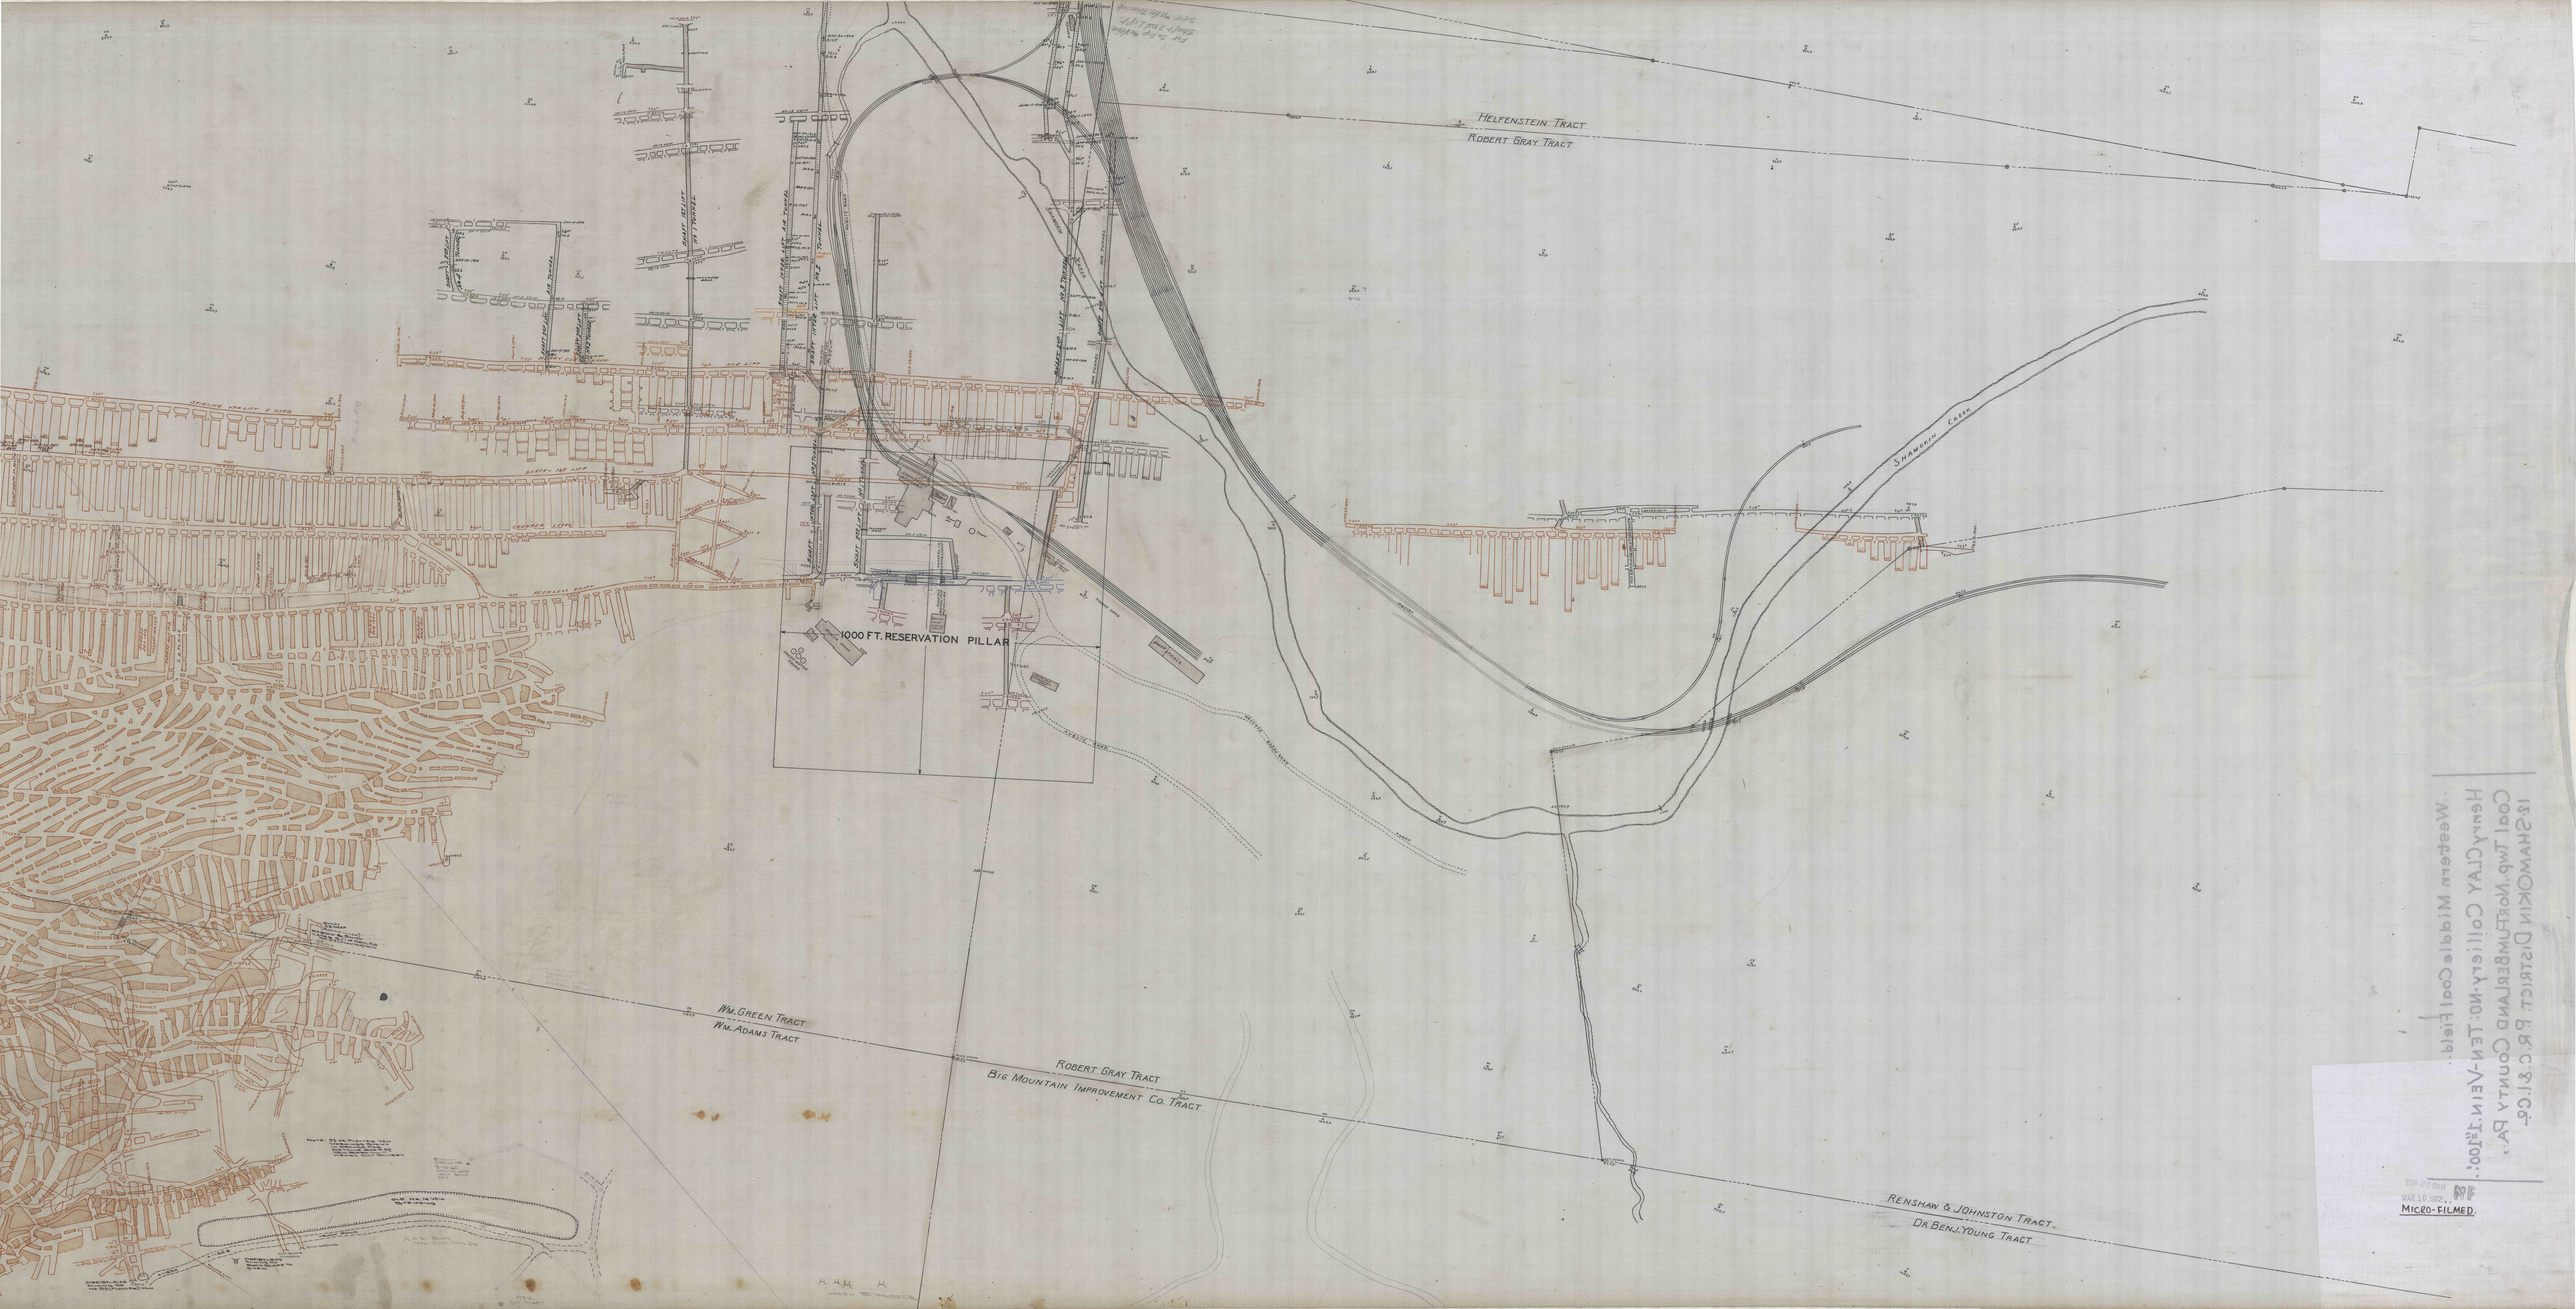

HELFENSTEIN TRACT
ROBERT GRAY TRACT
SHAMOKIN CREEK
1000 FT. RESERVATION PILLAR
HENRY CLAY BREAKER
HENRY CLAY HOISTING SHAFT
BOILER HOUSE
FRESH WATER TANKS
WATER HOIST ENGINE HOUSE
SMITH AND CARPENTER SHOP
RAZED STABLE
TIMBER YARD
PUBLIC ROAD
PRIVATE WAGON ROAD
TANK
PUMP HO.
SHAFT 1ST LIFT No 1 TUNNEL
SHAFT INTER. LIFT AIR TUNNEL
SHAFT INTER. LIFT No 2 TUNNEL
SHAFT 2ND LIFT No 3 TUNNEL
SHAFT 2ND LIFT AIR TUNNEL
SHAFT 2ND LIFT No 1 TUNNEL
SHAFT INTER. LIFT No 2 TUNNEL
DRAINAGE TUNNEL
AIR HOLE
STIRLING 4TH. LIFT E. GANG.
HENRY CLAY SHAFT
2ND. LIFT
SHAFT 1ST. LIFT
COUNTER LEVEL
TURNOUT
TRAVELING WAY
AIRWAY
PEERLESS DRIFT
PEERLESS No. 11 VEIN
GARFIELD No. 11 VEIN
No. 13 VEIN
No. 14 VEIN
No. 11 VEIN
No. 7 VEIN
No. 5 VEIN
DUMP SHUTE
S.A. PLANE
CONCRETE DAM.
WM. GREEN TRACT
WM. ADAMS TRACT
ROBERT GRAY TRACT
BIG MOUNTAIN IMPROVEMENT CO. TRACT
RENSHAW & JOHNSTON TRACT
DR. BENJ. YOUNG TRACT

MF
MAR 10 1972
MICRO-FILMED.