


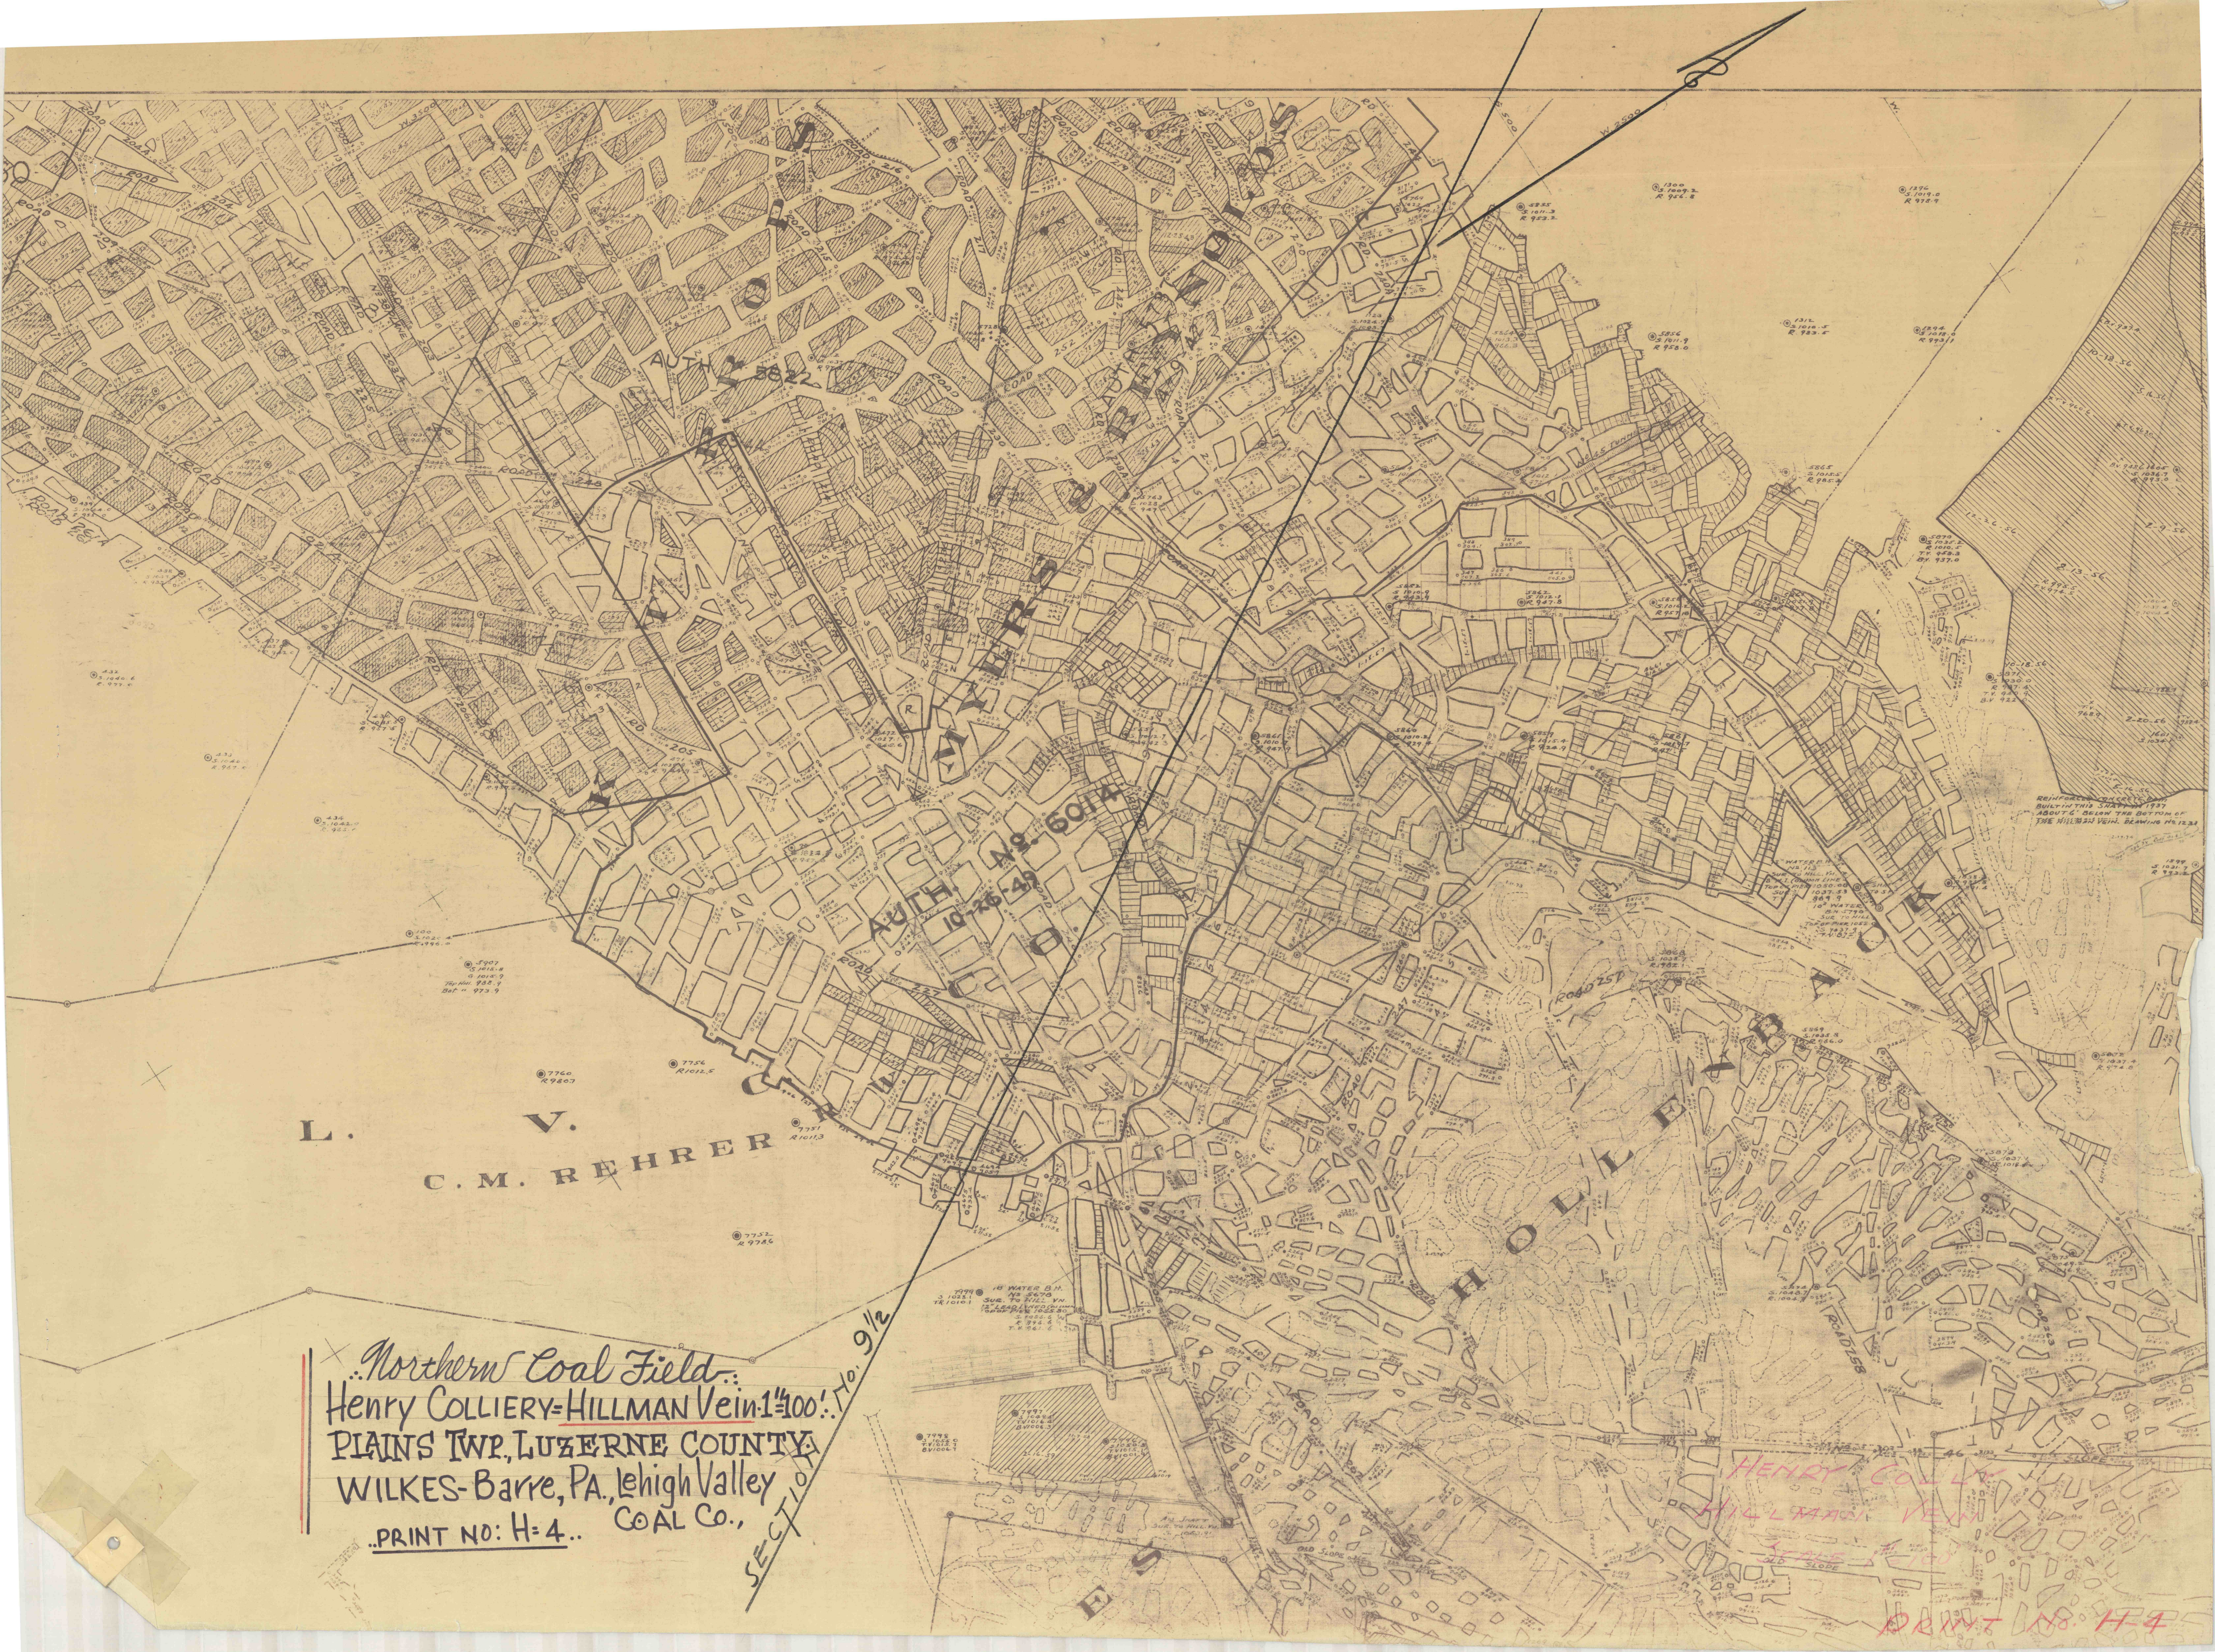

Northern Coal Field:
Henry Colliery-Hillman Vein 1 1/4 100'
PLAINS TWP, LUZERNE COUNTY
WILKES-Barre, PA., Lehigh Valley
..PRINT NO: H-4.. COAL Co.,

No. 9 1/2

HENRY COLLIERY
HILLMAN VEIN
SCALE 1" = 100'
PRINT NO. H-4