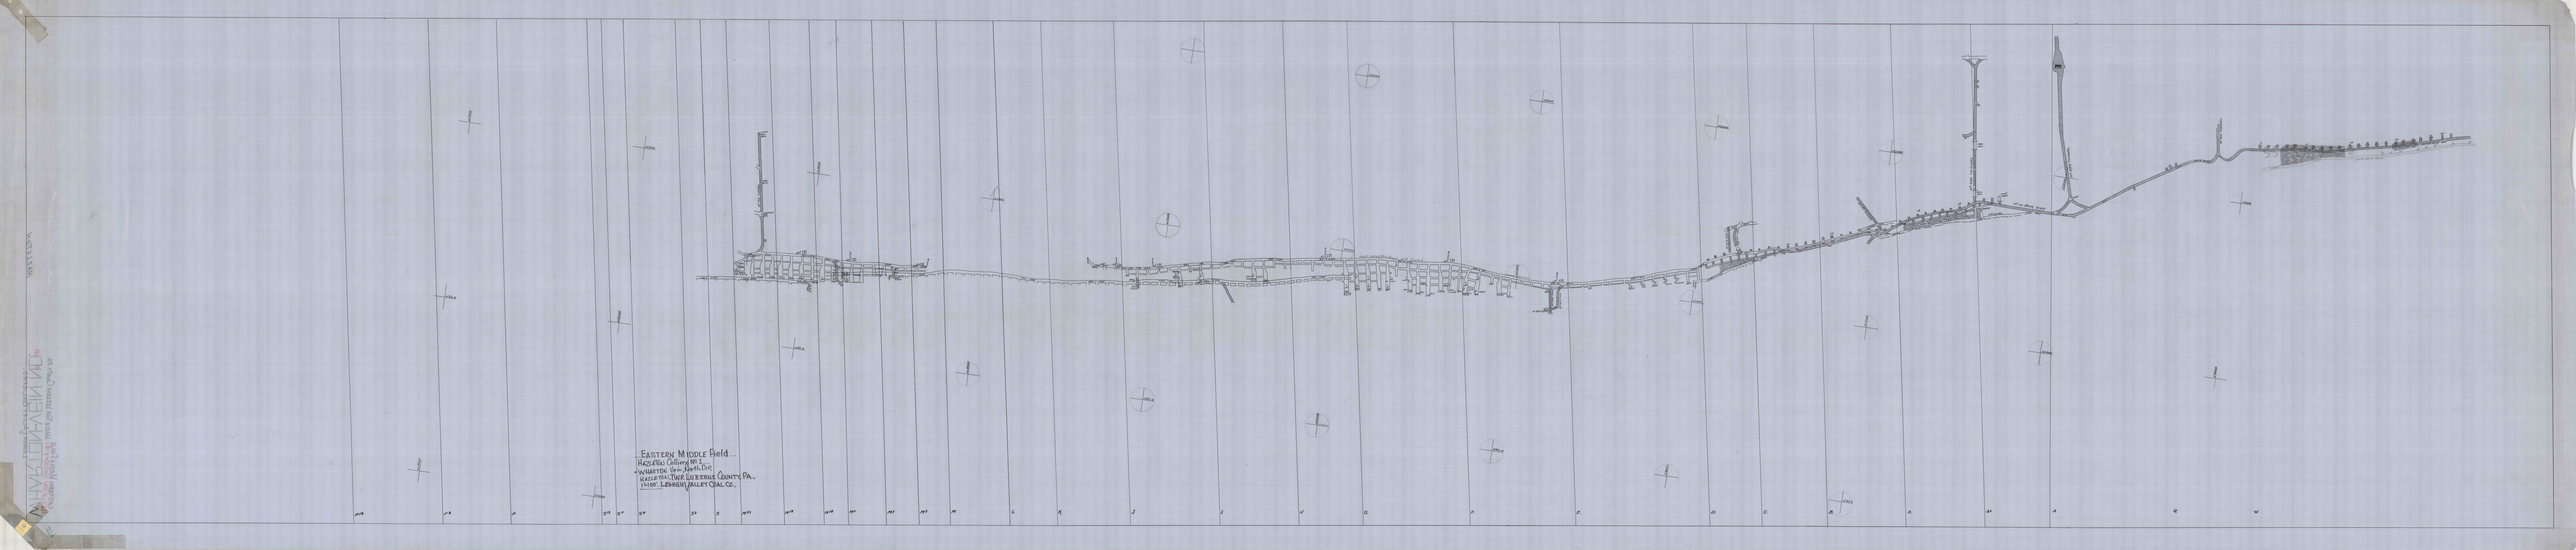

W7000
N1000
W5000
N850
W2000
N450
W6000
S1000
N1000
W5000
N2000
N1000
W1000
N45.0
W2000
E3000
No 910 TUNNEL
WHARTON
WHARTON GWY
8th LEVEL
WEST WHARTON Gwy 8th Level
W. BUCK
No 505 TUNNEL
MAM. VEIN
No 400 TUNNEL
No 410 TUNNEL
No 41 ROCK GWY
3rd LEVEL
No 41 ROCK GWY
P18
P8
P
S13
S11
S9
S3
S
M23
M18
M14
M11
M7
M3
M
L
K
J
I
H
G.
F.
E.
D.
C.
B.
O.
A2
A
Q
W

...EASTERN MIDDLE FIELD...
HAZLETON Colliery No 1...
• WHARTON Vein, North Dip,
HAZLETON, TWP. LUZERNE COUNTY, PA.,
1"=100'. LEHIGH VALLEY COAL CO.,