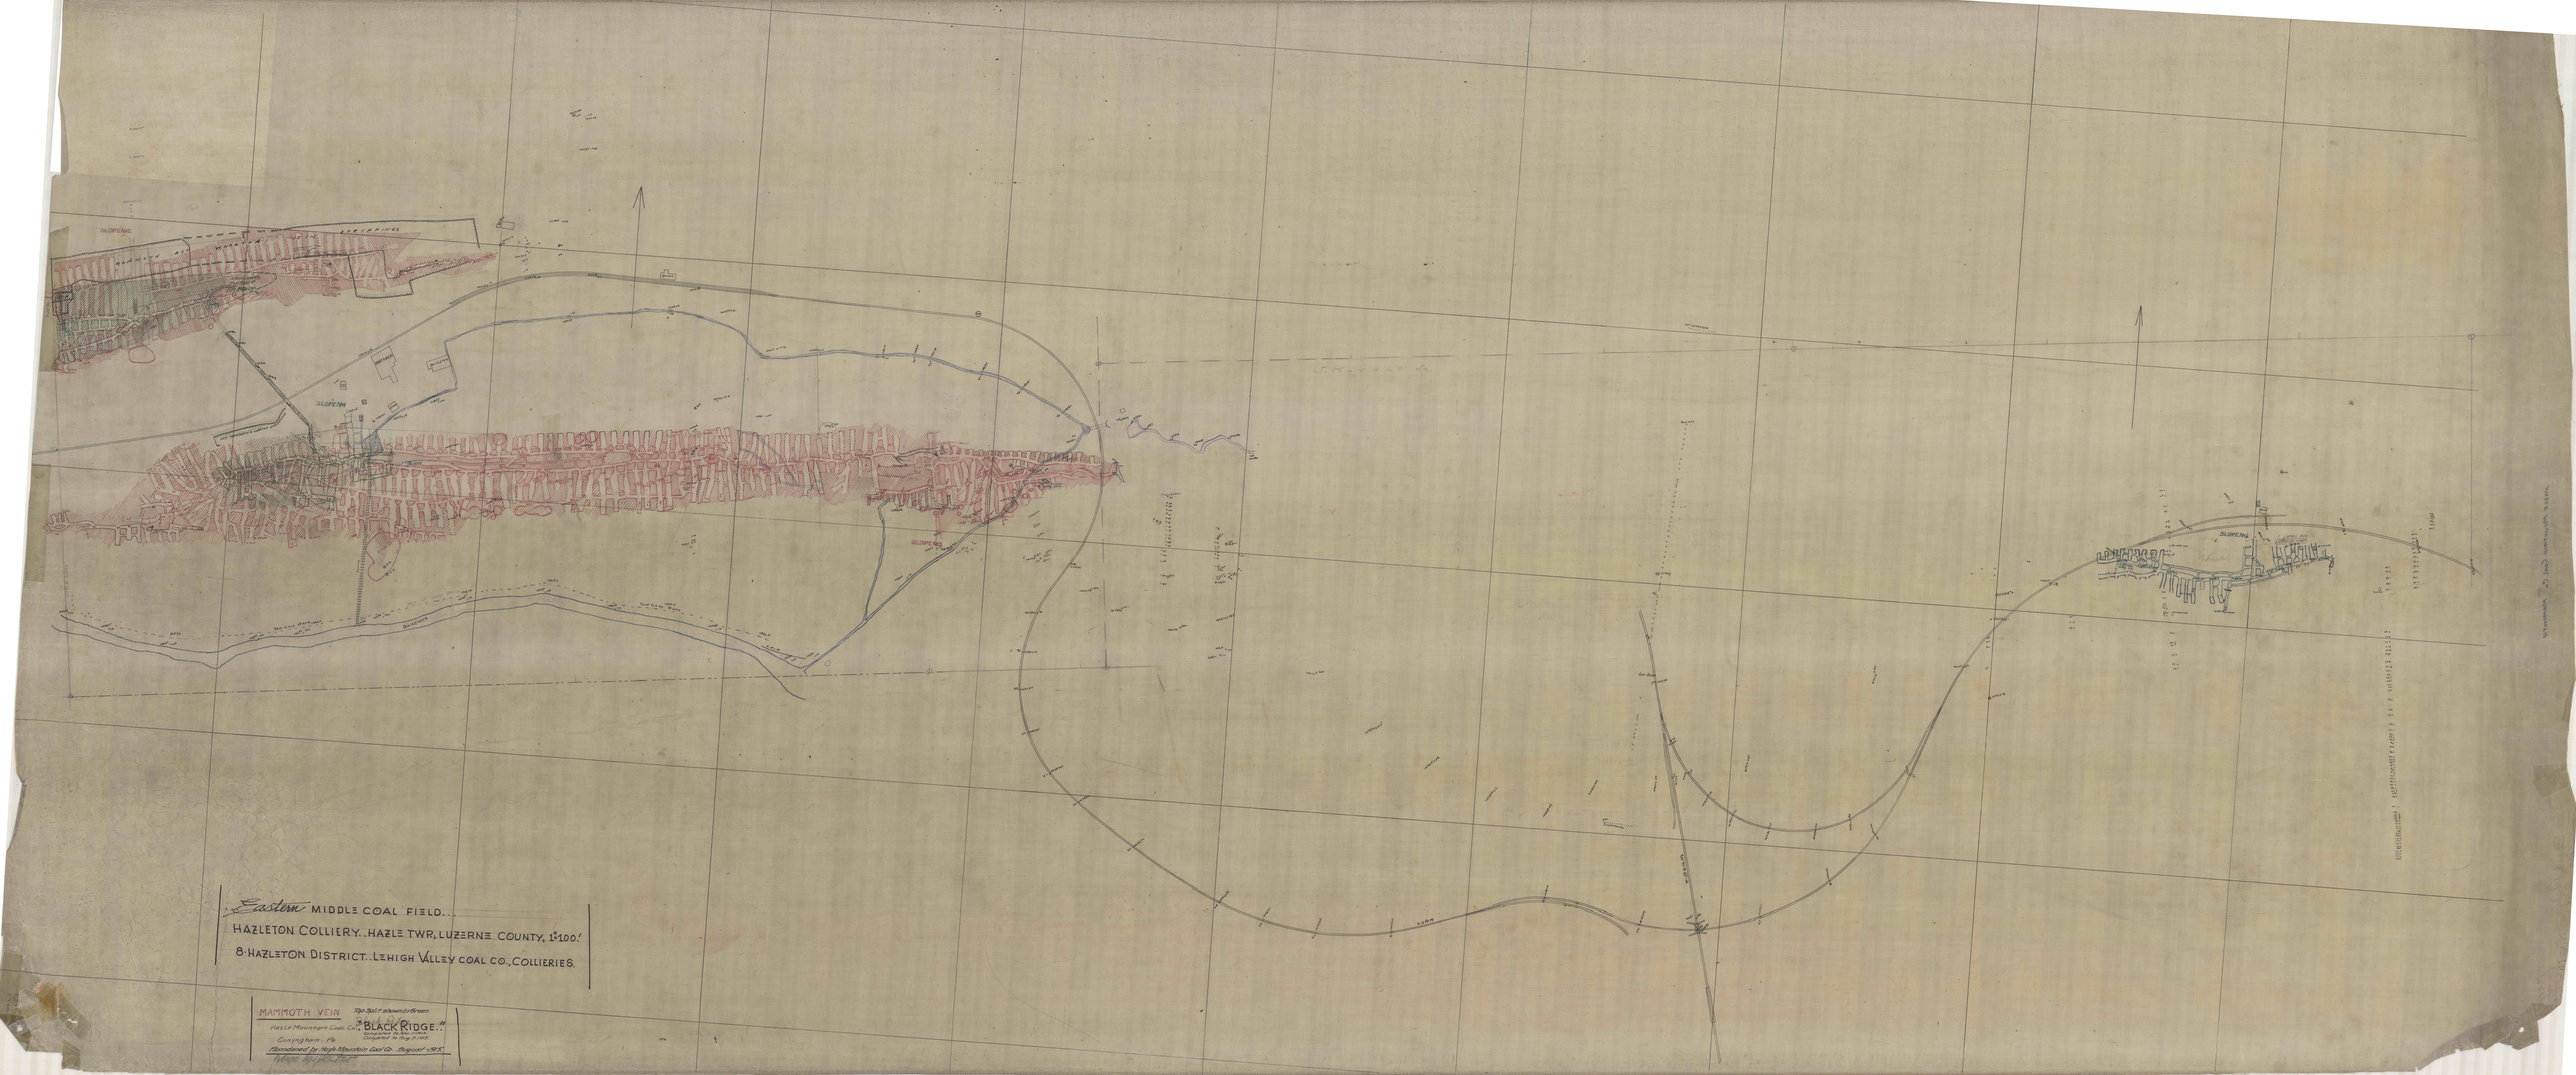

Eastern MIDDLE COAL FIELD.

HAZLETON COLLIERY. HAZLE TWP, LUZERNE COUNTY, 1"=100'

8. HAZLETON DISTRICT. LEHIGH VALLEY COAL CO., COLLIERIES.

MAMMOTH VEIN

Top Split shown in Green

Hazle Mountain Coal Co's "BLACK RIDGE"

Compared to Aug 31 1925

Coming here - Fig

