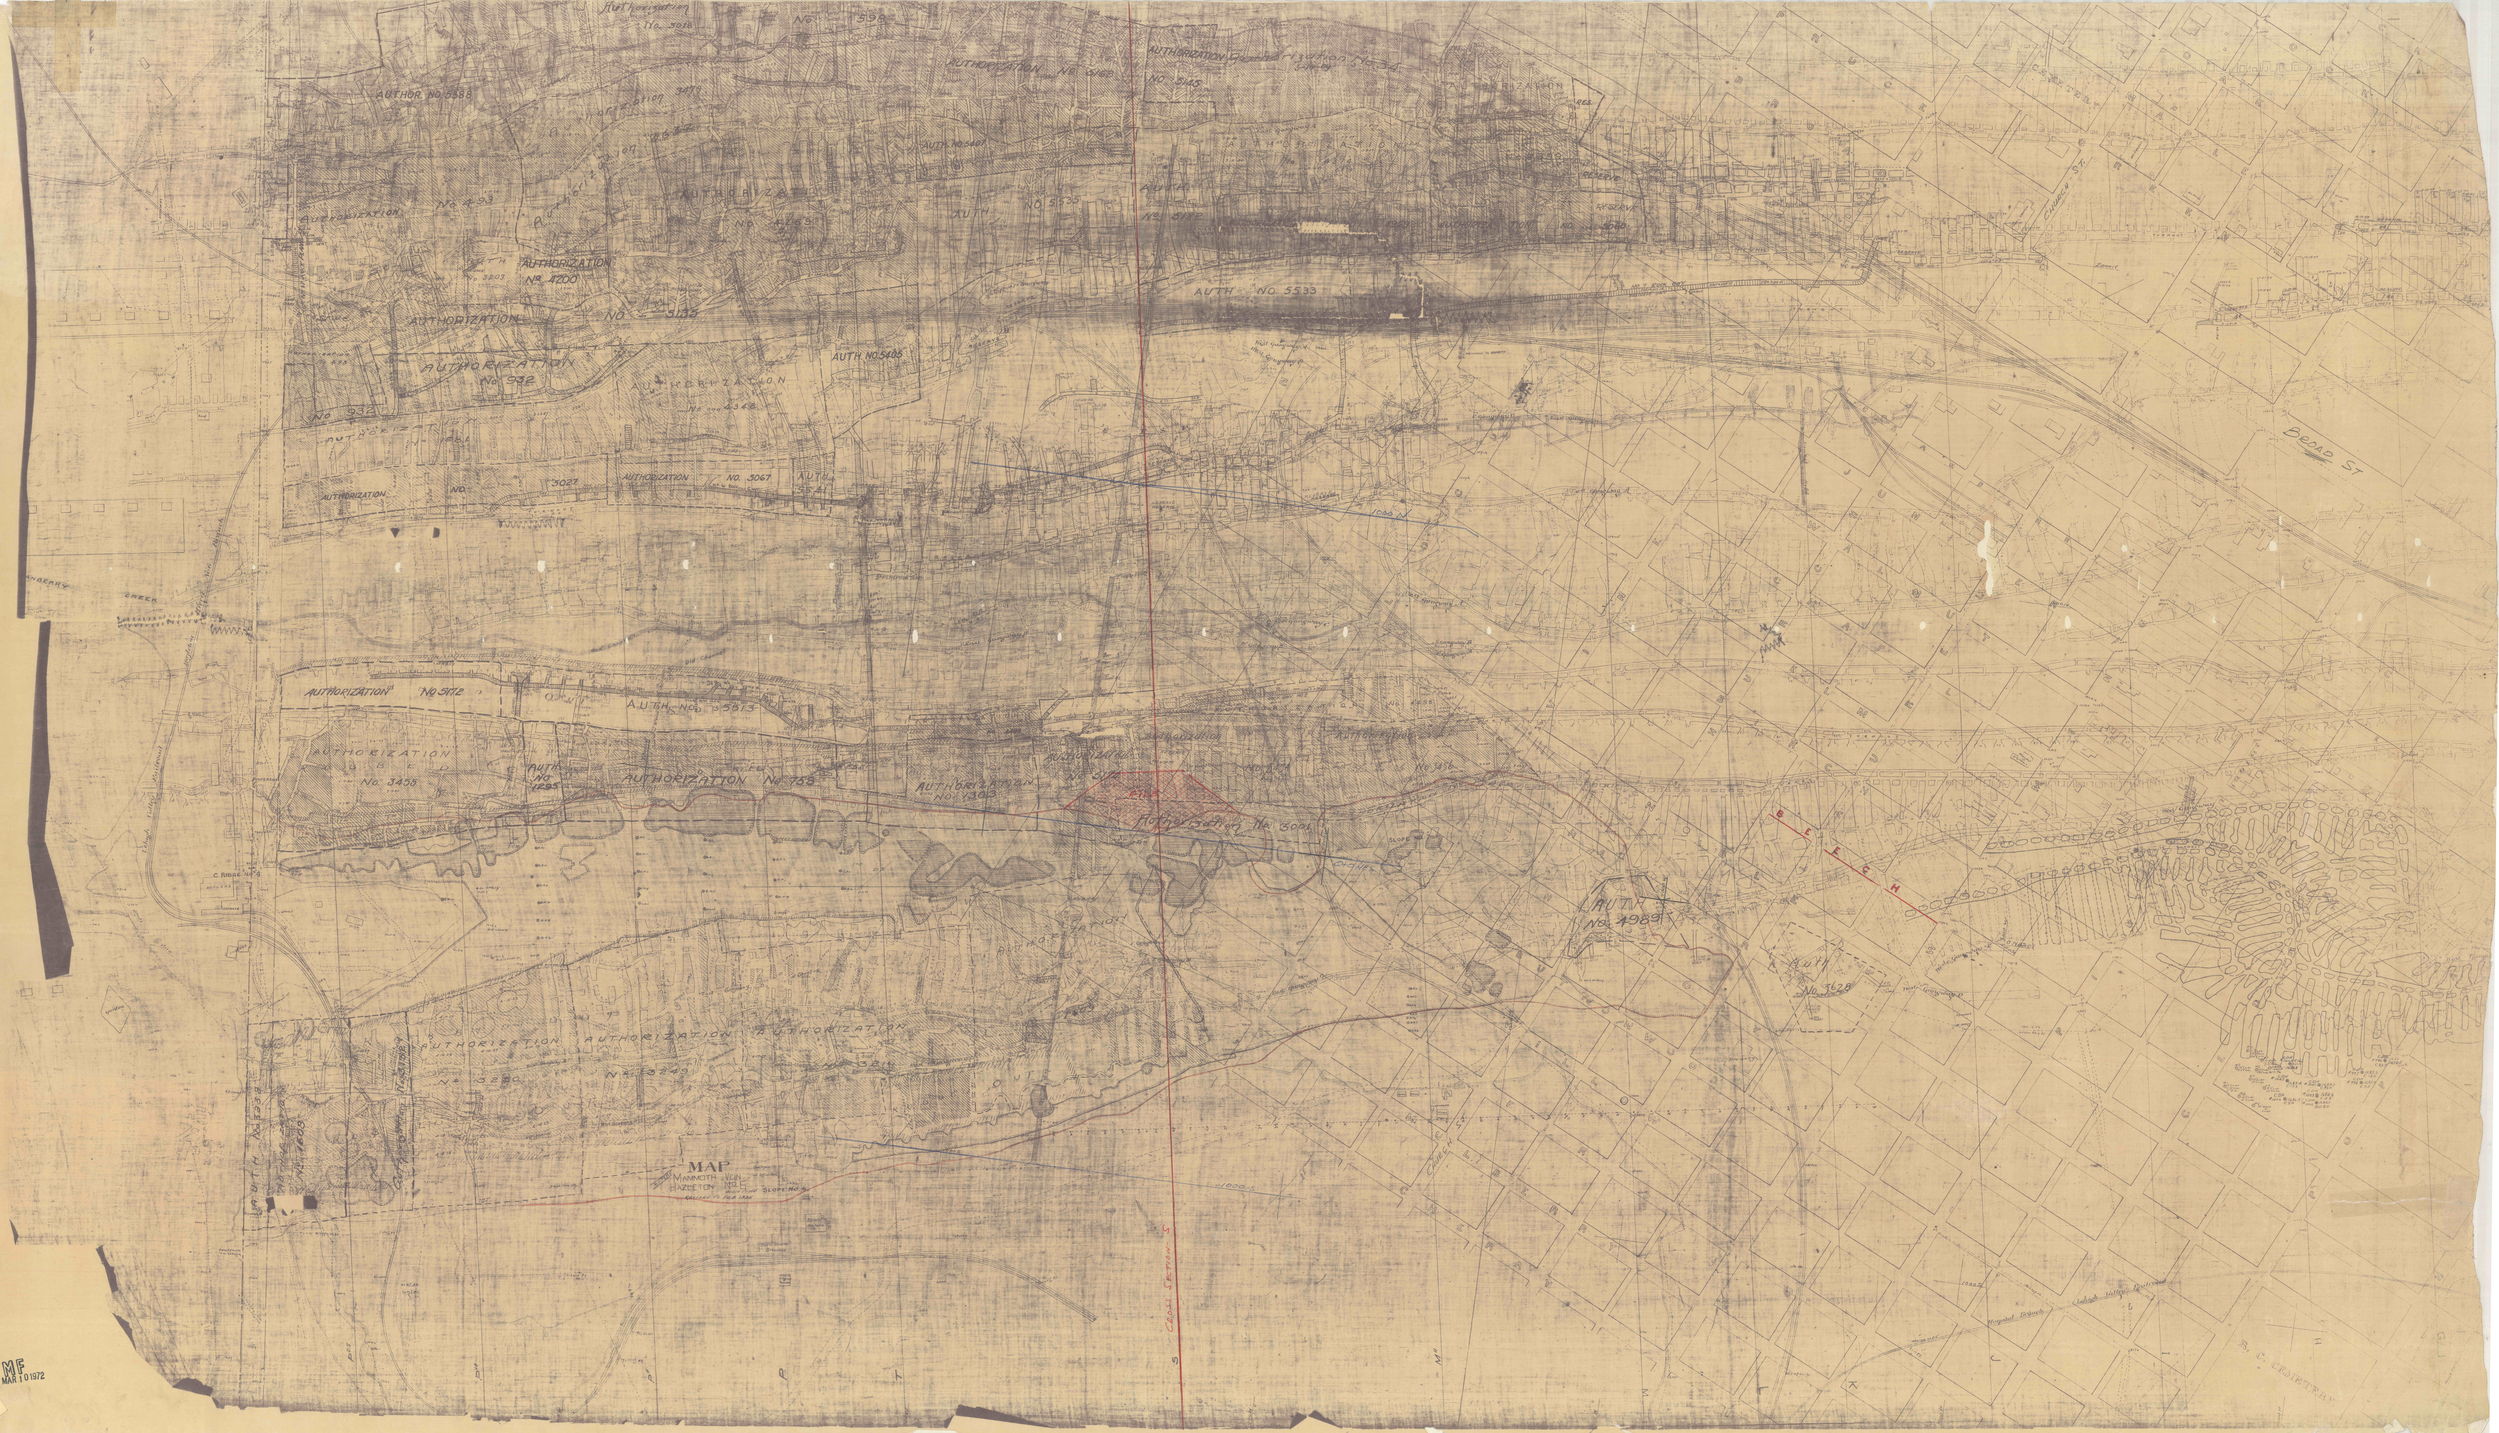

MAP
OF THE MAMMOTH VEIN
HAZLETON No 6
Scale 1" = 100'
SLOPE No. 6
REVISED TO FEB. 1935
Authorization No. 3018
No. 598
AUTHOR. NO. 5388
Authorization 3479
Authorization 3637
AUTHORIZATION No 493
Authorization
AUTHORIZATION No 4263
AUTH. No 3203
AUTHORIZATION No 4200
AUTHORIZATION No 5135
AUTHORIZATION No 932
No 932
AUTHORIZATION No 4348
AUTHORIZATION No 1881
AUTHORIZATION No 5027
AUTHORIZATION No. 5067
AUTH 5541
AUTHORIZATION No 5165
AUTHORIZATION Authorization No. 34
No. 5145
AUTHORIZATION
RES.
AUTH. No. 5407
AUTHORIZATION No 4374
No 2890
RESERVE
AUTH. No. 5535
AUTH. No 5182
1969
AUTHORIZATION No 3060
AUTH. No. 5533
AUTH. No. 5405
No 7 ROCK GWY
DRAINAGE GWY
West Gangway A
East Gangway A
TURNOUT
RESERVE
1000-N
Primrose
New Channel
Old Channel
CRANBERRY CREEK
AUTHORIZATION No 5172
AUTH. No 5513
AUTHORIZATION No. 3455
AUTH. No 1295
AUTHORIZATION No. 758
AUTHORIZATION No. 1303
Authorization
AUTHORIZATION No 5174
Fire
Authorization No. 3001
No 3454
No 3456
AUTHORIZATION No 4498
SLOPE No. 6
OTONES
AUTH. No. 4989
Auth. No. 3628
AUTHORIZATION No 3250
AUTHORIZATION No 3249
AUTHORIZATION No 3219
AUTH. No 3338
AUTHORIZATION No 1608
Cross Section S
1000-S
C. RIDGE No 4
BOILERS
CRACKER
Lehigh Valley Railroad
Down Smith Shop
Down Boilers
Torn Down Breaker
Coal Begins Top
Coal Begins Bott.
Office
BEECH
BROAD ST.
CHURCH ST.
CEMETERY
SPRUCE
BROAD
GREEN
MAPLE
OAK
LOCUST
JUNIPER
WALNUT
CHESTNUT
ELM
HEMLOCK
MULBERRY
WILLOW
BUTTONWOOD
CHERRY
POPLAR
West Gangway
West Gangway P
3000 W
Brewery
Hospital Branch
Lehigh Valley Railroad
R. C. CEMETERY
1000 S

MF
MAR 10 1972

A