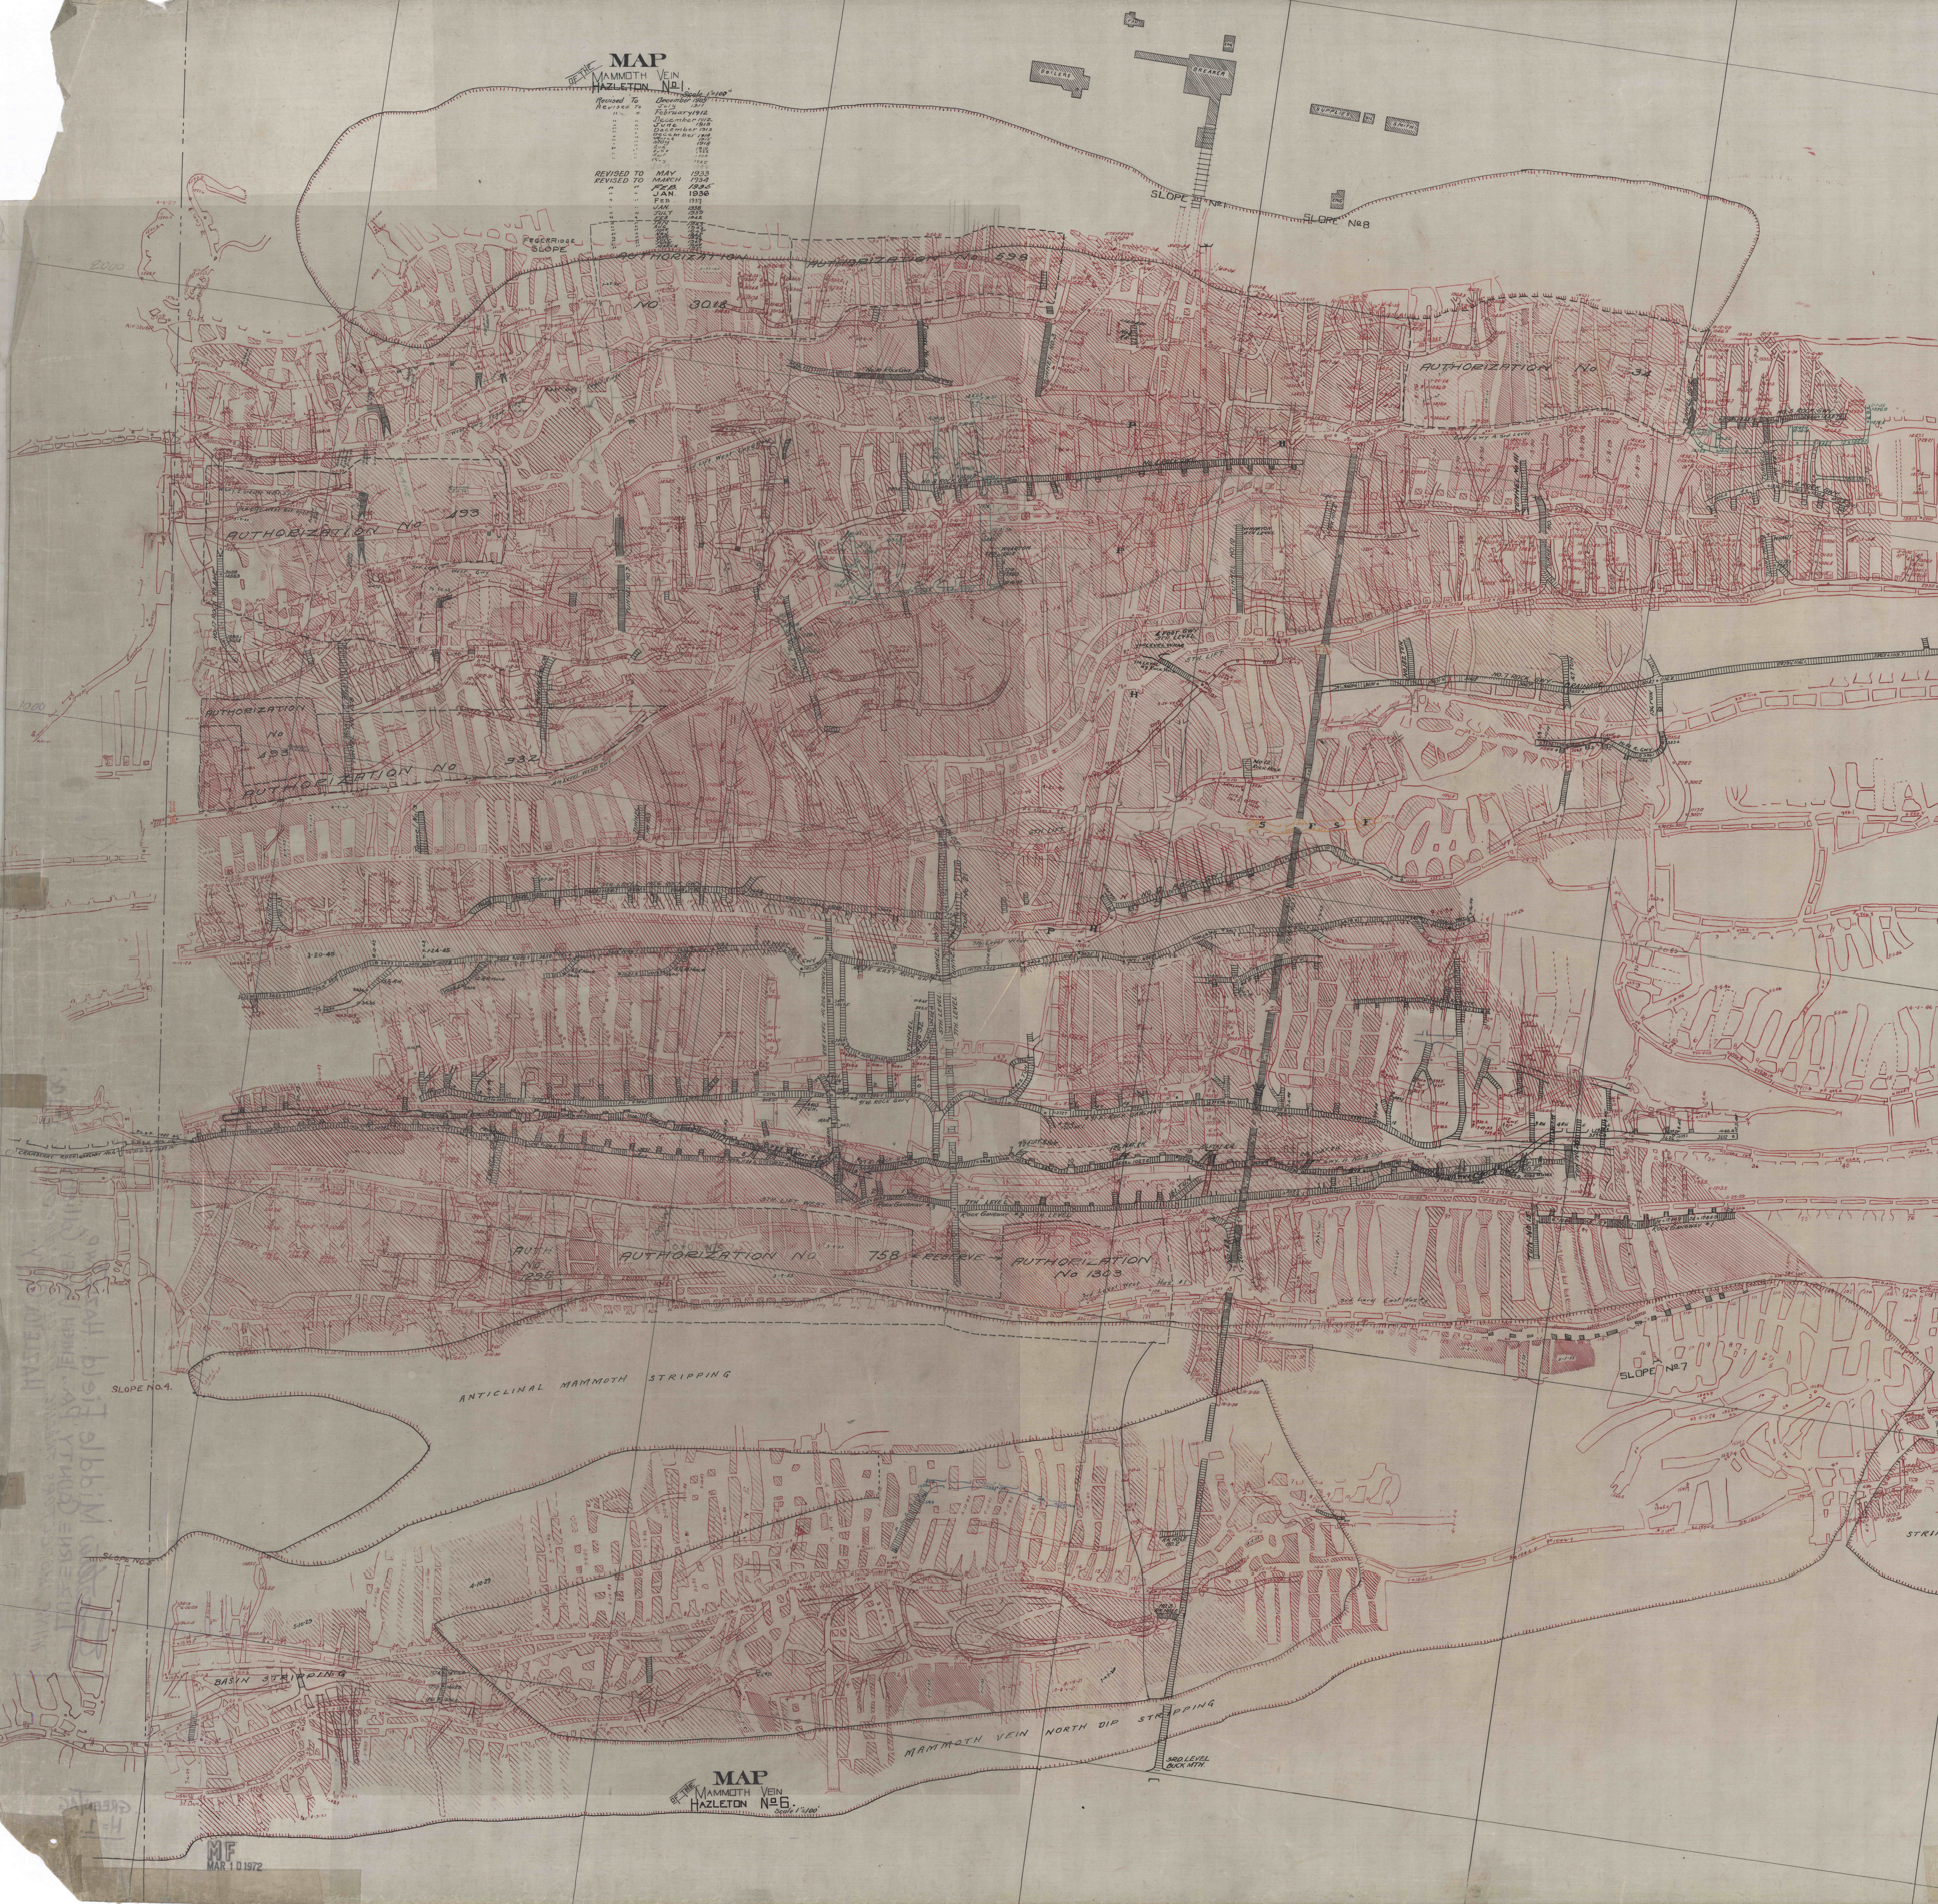

MAP
of the
MAMMOTH VEIN
HAZLETON No 1.
Scale 1" = 100'

Revised To	December 1909
Revised To	July 1911
" "	February 1912
" "	December 1912
" "	June 1913
" "	December 1913
" "	December 1914
" "	March 1915
" "	May 1918
" "	Aug. 1919
" "	June 1922
" "	Sept 1923
" "	Aug 1925
"	Jan 1926
REVISED TO	MAY 1933
REVISED TO	MARCH 1934
" "	FEB. 1935
" "	JAN. 1936
" "	FEB. 1937
" "	JAN. 1938
" "	JULY 1939
" "	FEB 1942
" "	JAN 1943
" "	AUG 1943
" "	MAR 1945
" "	NOV 1945
" "	AUG 1946
" "	JULY 1947
" "	JUNE 1948
" "	MARCH 1951

MAP
of the
MAMMOTH VEIN
HAZLETON No 6.
Scale 1" = 100'

FAN
ENG
BOILERS
BREAKER
SUPPLIES
OIL
SMITH
ENG
SLOPE No 1
SLOPE No 8
FEGERRIDGE SLOPE
AUTHORIZATION No 3018
AUTHORIZATION No 598
AUTHORIZATION No 34
AUTHORIZATION No 493
AUTHORIZATION No 493
AUTHORIZATION No 932
Air Shaft
2000
1000
PLANE
No 17 ROCK PLANE
West Gwy
East Gwy
Feger Ridge
3rd Lift West
TUNNEL No 7
TUNNEL No 3
TUNNEL No 103
Tunnel No 13
TUNNEL No 138
No 10 Rock GWY
No 8 ROCK GWY
WHARTON
WHARTON 5TH LEVEL
TUNNEL NO. 10
6 FOOT GWY 5TH LEVEL
5TH LIFT
No 12 Rock Hole
6TH LIFT
NO. 12 ROCK GWY
7th LEVEL No 6 ROCK GWY
No 25 EAST ROCK GWY
7th Level West
East Gwy A 3rd Level
TUNNEL No 111
TUNNEL No 17
NO. 5 ROCK GWY
NO. 4 ROCK GWY
WHART.
NO. 7 ROCK GWY. DRAINAGE
No 182 TUN
136 TUN
No 80 R. GWY
CAVE
3-20-45
1-24-45
15½ R.H.
12½ R. Hole
8½ R. Hole
CRANBERRY ROCK GANGWAY No 6
STABLE
Pump
Sump
91 W. ROCK GWY
# 91 E. ROCK GANGWAY
# 27 E. Rock GWY
5TH. LIFT WEST
Rock Gangway # 3
7TH LEVEL
Rock Gangway # 2 7TH LEVEL
Rock Gangway # 1
20¼ FLAT R.H.
4th Level East Gwy. A. North Dip.
TUN No 15
TUN No 26
3rd Level West Haz. # 1
3rd Level East Haz. # 1
AUTH No 1295
AUTHORIZATION No 758 ← RESERVE → AUTHORIZATION No 1303
SLOPE No. 4.
ANTICLINAL MAMMOTH STRIPPING
SLOPE No 7
SLOPE No 5
BASIN STRIPPING
SUMP
RK HOLE NO. 2
NO. 3 RK HOLE
MAMMOTH VEIN NORTH DIP STRIPPING
3RD. LEVEL BUCK MTN.
STRIP
S F S F
P H
32 DAM

MF
MAR 10 1972