
REC'D IN DAMAGED CONDITION: MARCH 23, 1972 from HAGLEY SURVEYS Micro-filming Service

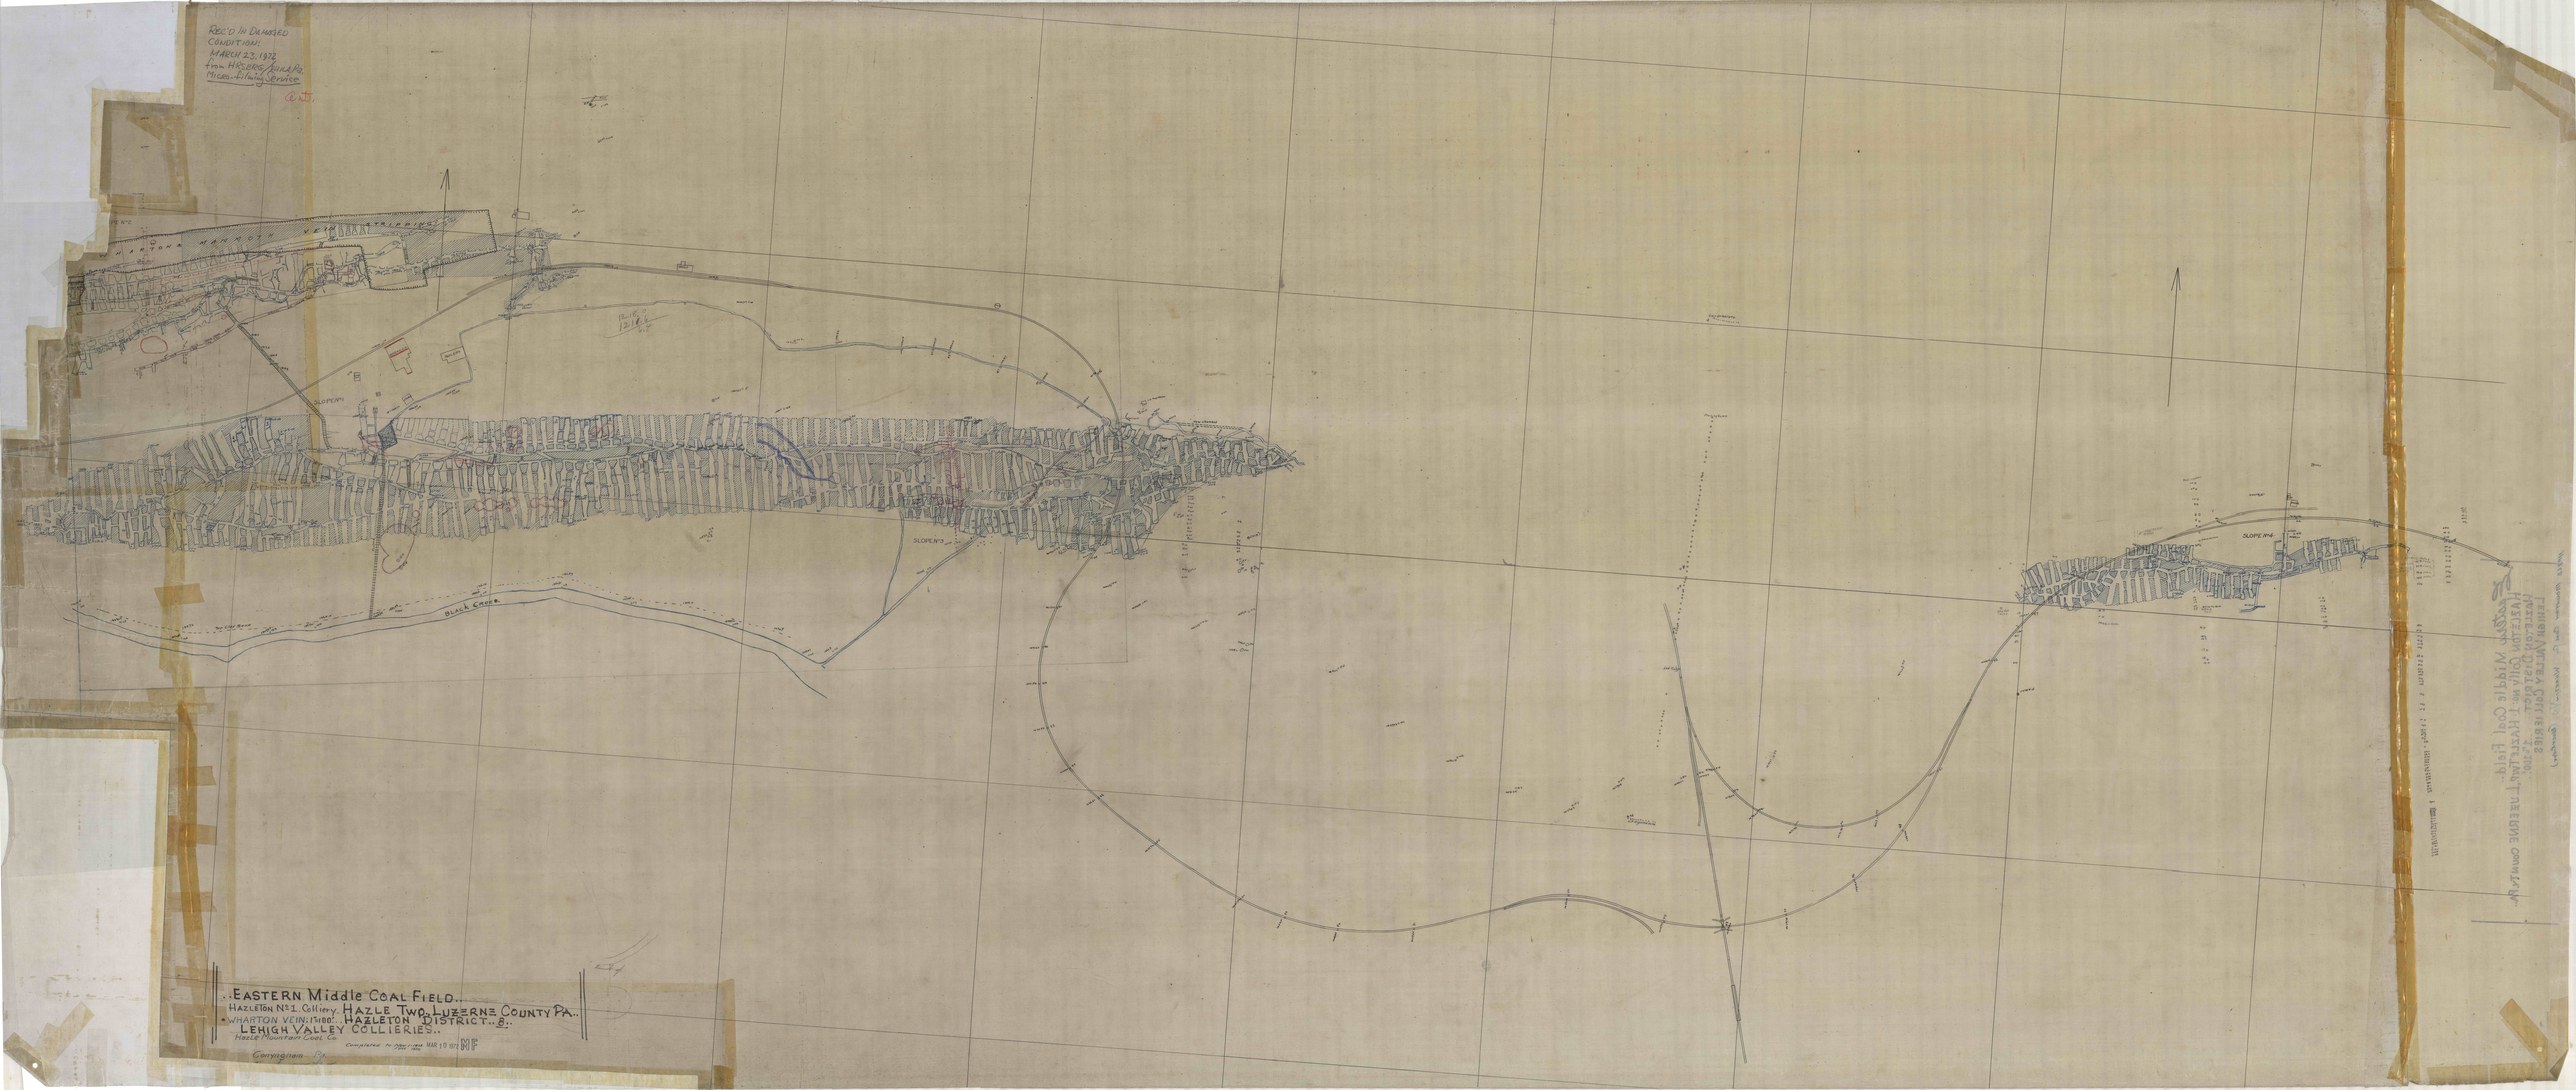

EASTERN Middle COAL FIELD.
HAZLETON No. 1 Colliery HAZLE TWP. LUZERNE COUNTY PA.
WHARTON VEIN, Mahanoy HAZLETON DISTRICT.
LEHIGH VALLEY COLLIERIES.
Hazle Mountain Coal Co.
Completed to date MAR 10 1972 MF
Carrington Pf.