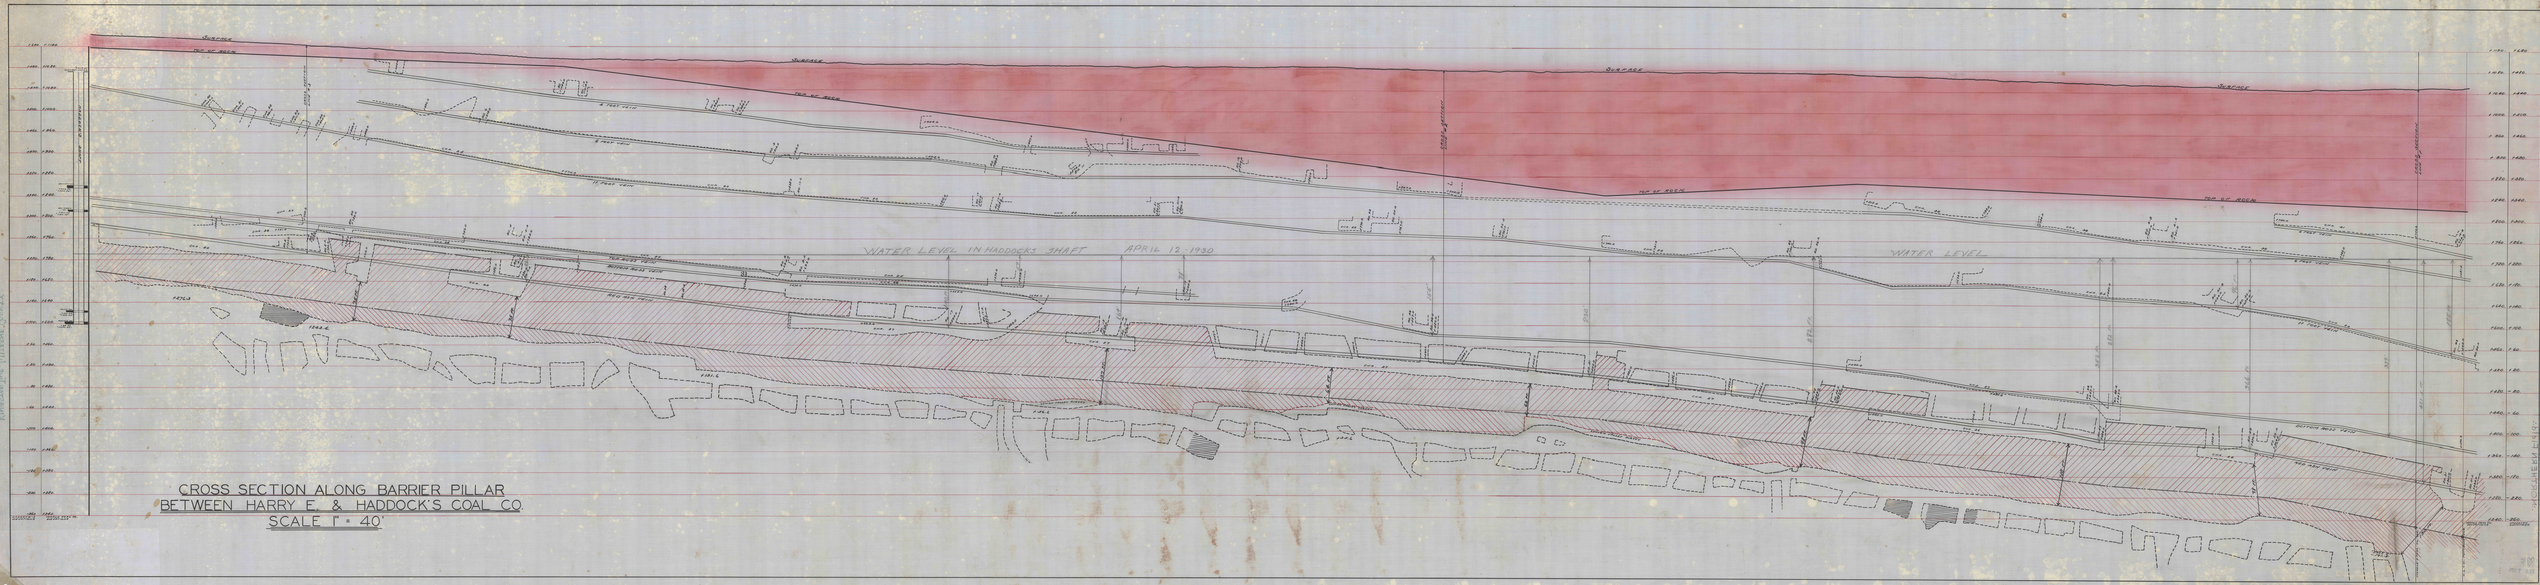


CROSS SECTION ALONG BARRIER PILLAR
BETWEEN HARRY E. & HADDOCK'S COAL CO.
SCALE 1" = 40'