

CSM

CSM

MAR 10 1972
MF


GREEN TAG
H-18.

HAZLETON QUARRY
SECTION M23

365' EAST OF HAZLETON SLOPE NO. 1
Scale 1" = 100'

Date of Revision
Tracy
Diamond
Orchard
Primrose
Mammoth
Wharton
Gamma
Buck Mt.

Datum 1000

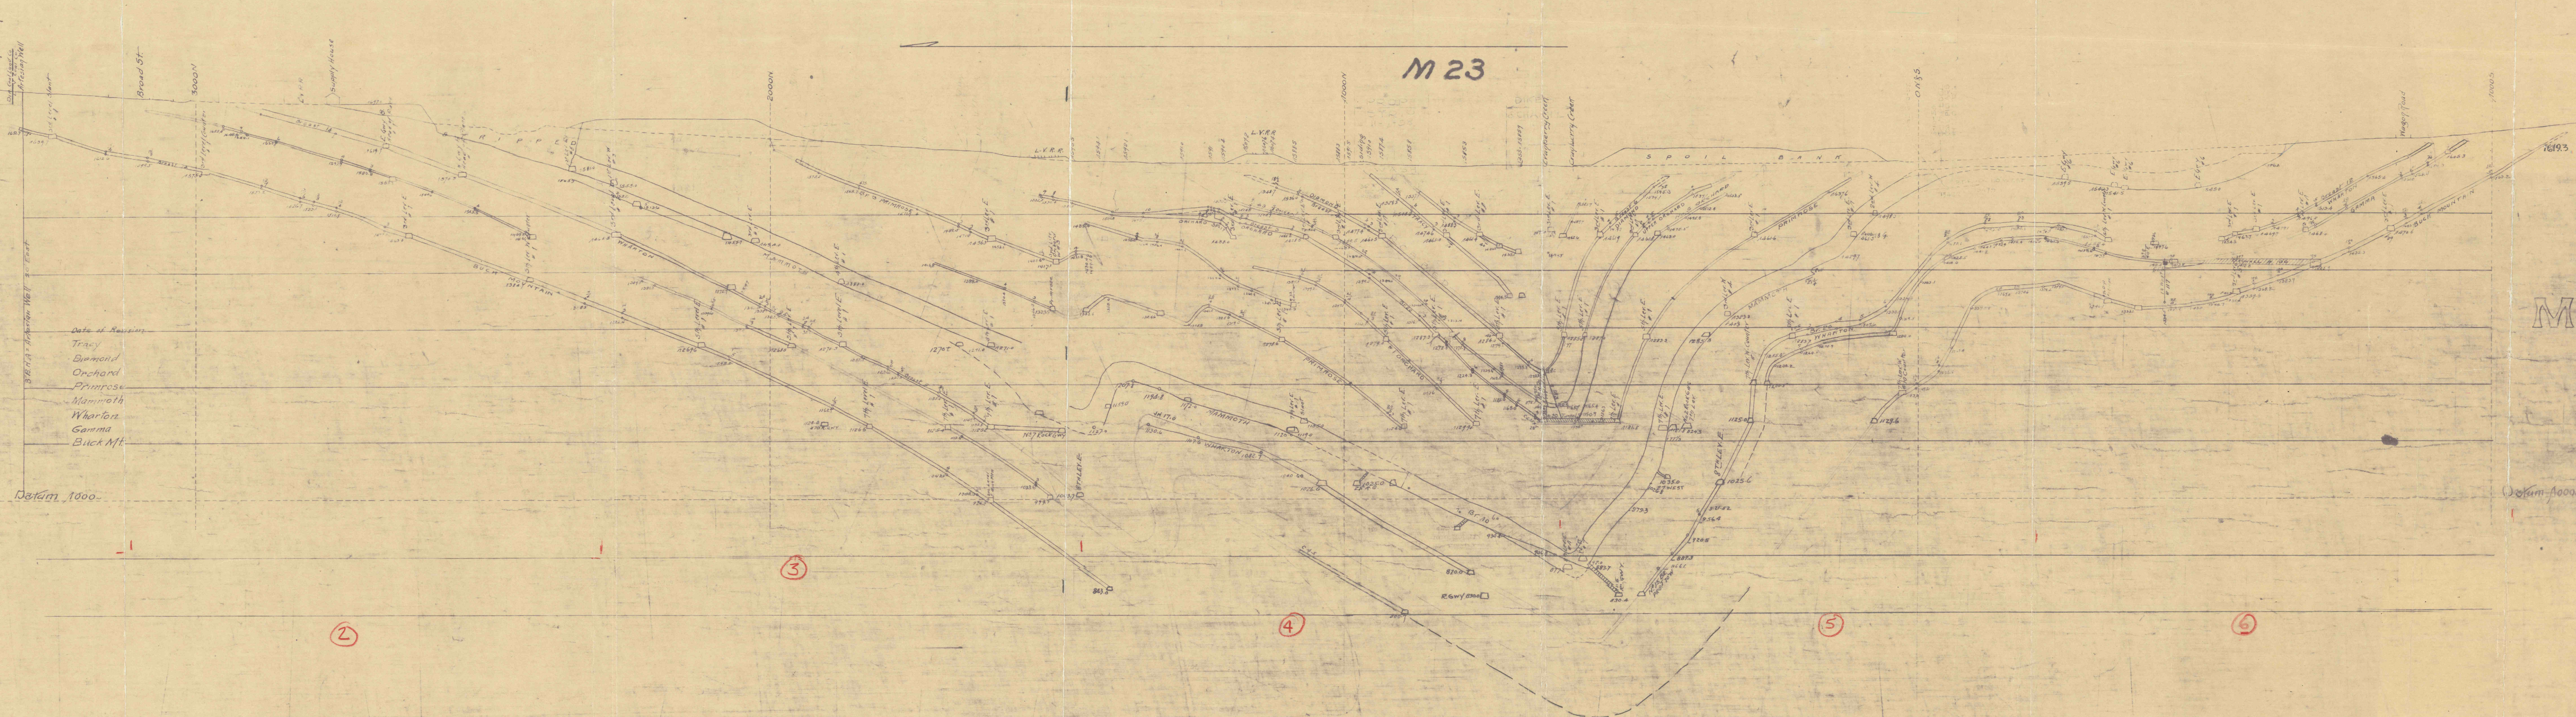

MF
MAR 10 1972