5=SMALL Pc.

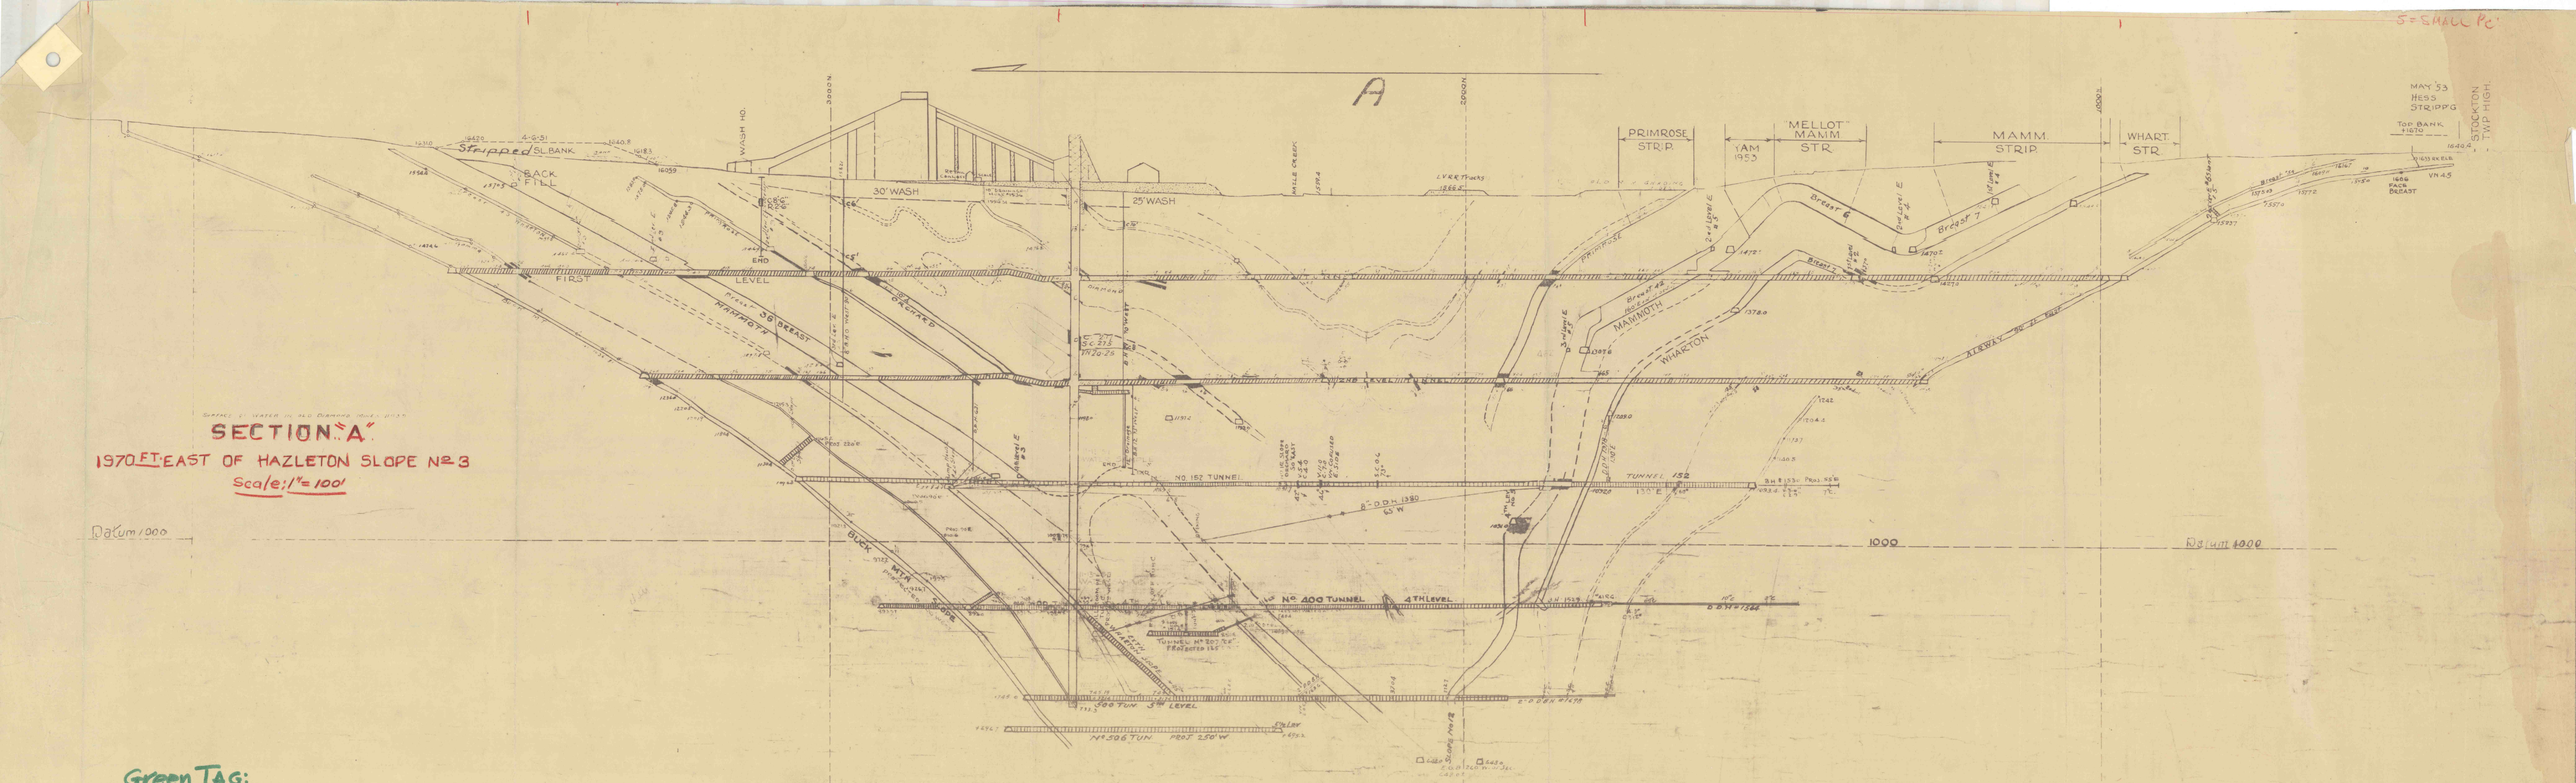
A
PRIMROSE STRP.
MELLOT
MAMM STR.
1AM 1953
MAMM. STRIP.
WHART. STR.
MAY '53 HESS STRIPP'G
STOCKTON TWP HIGH.
Stripped SL BANK
BACK FILL
4-6-51
WASH HD.
30' WASH
25' WASH
NILE CREEK
FIRST
END LEVEL
36 BREAST
HAMMOTH
Breast 6
Breast 7
Breast 8
MAMMOTH
WHARTON
AIRWAY
No 152 TUNNEL
TUNNEL 152
No 400 TUNNEL
4TH LEVEL
BUCK MTN
300 TUN 3rd LEVEL
No 306 TUN
Datum 1000
1000
SECTION "A"
1970 FT. EAST OF HAZLETON SLOPE No 3
Scale; 1"= 100'
Green TAG:
H-18
2.
2=A,