


- VENTILATION SYMBOLS
- = MAIN FAN
 - = AUXILIARY FAN
 - = AIR FLOW- INTAKE
 - = AIR FLOW- RETURN
 - + = PERMANENT STOPPING
 - + = TEMPORARY "
 - ⊠ = AIR BRIDGE
 - ⊠ = REGULATOR
 - ⊠ = MAN DOOR
 - ∇ = VELOCITY, FPM
 - Q = QUANTITY, CFM

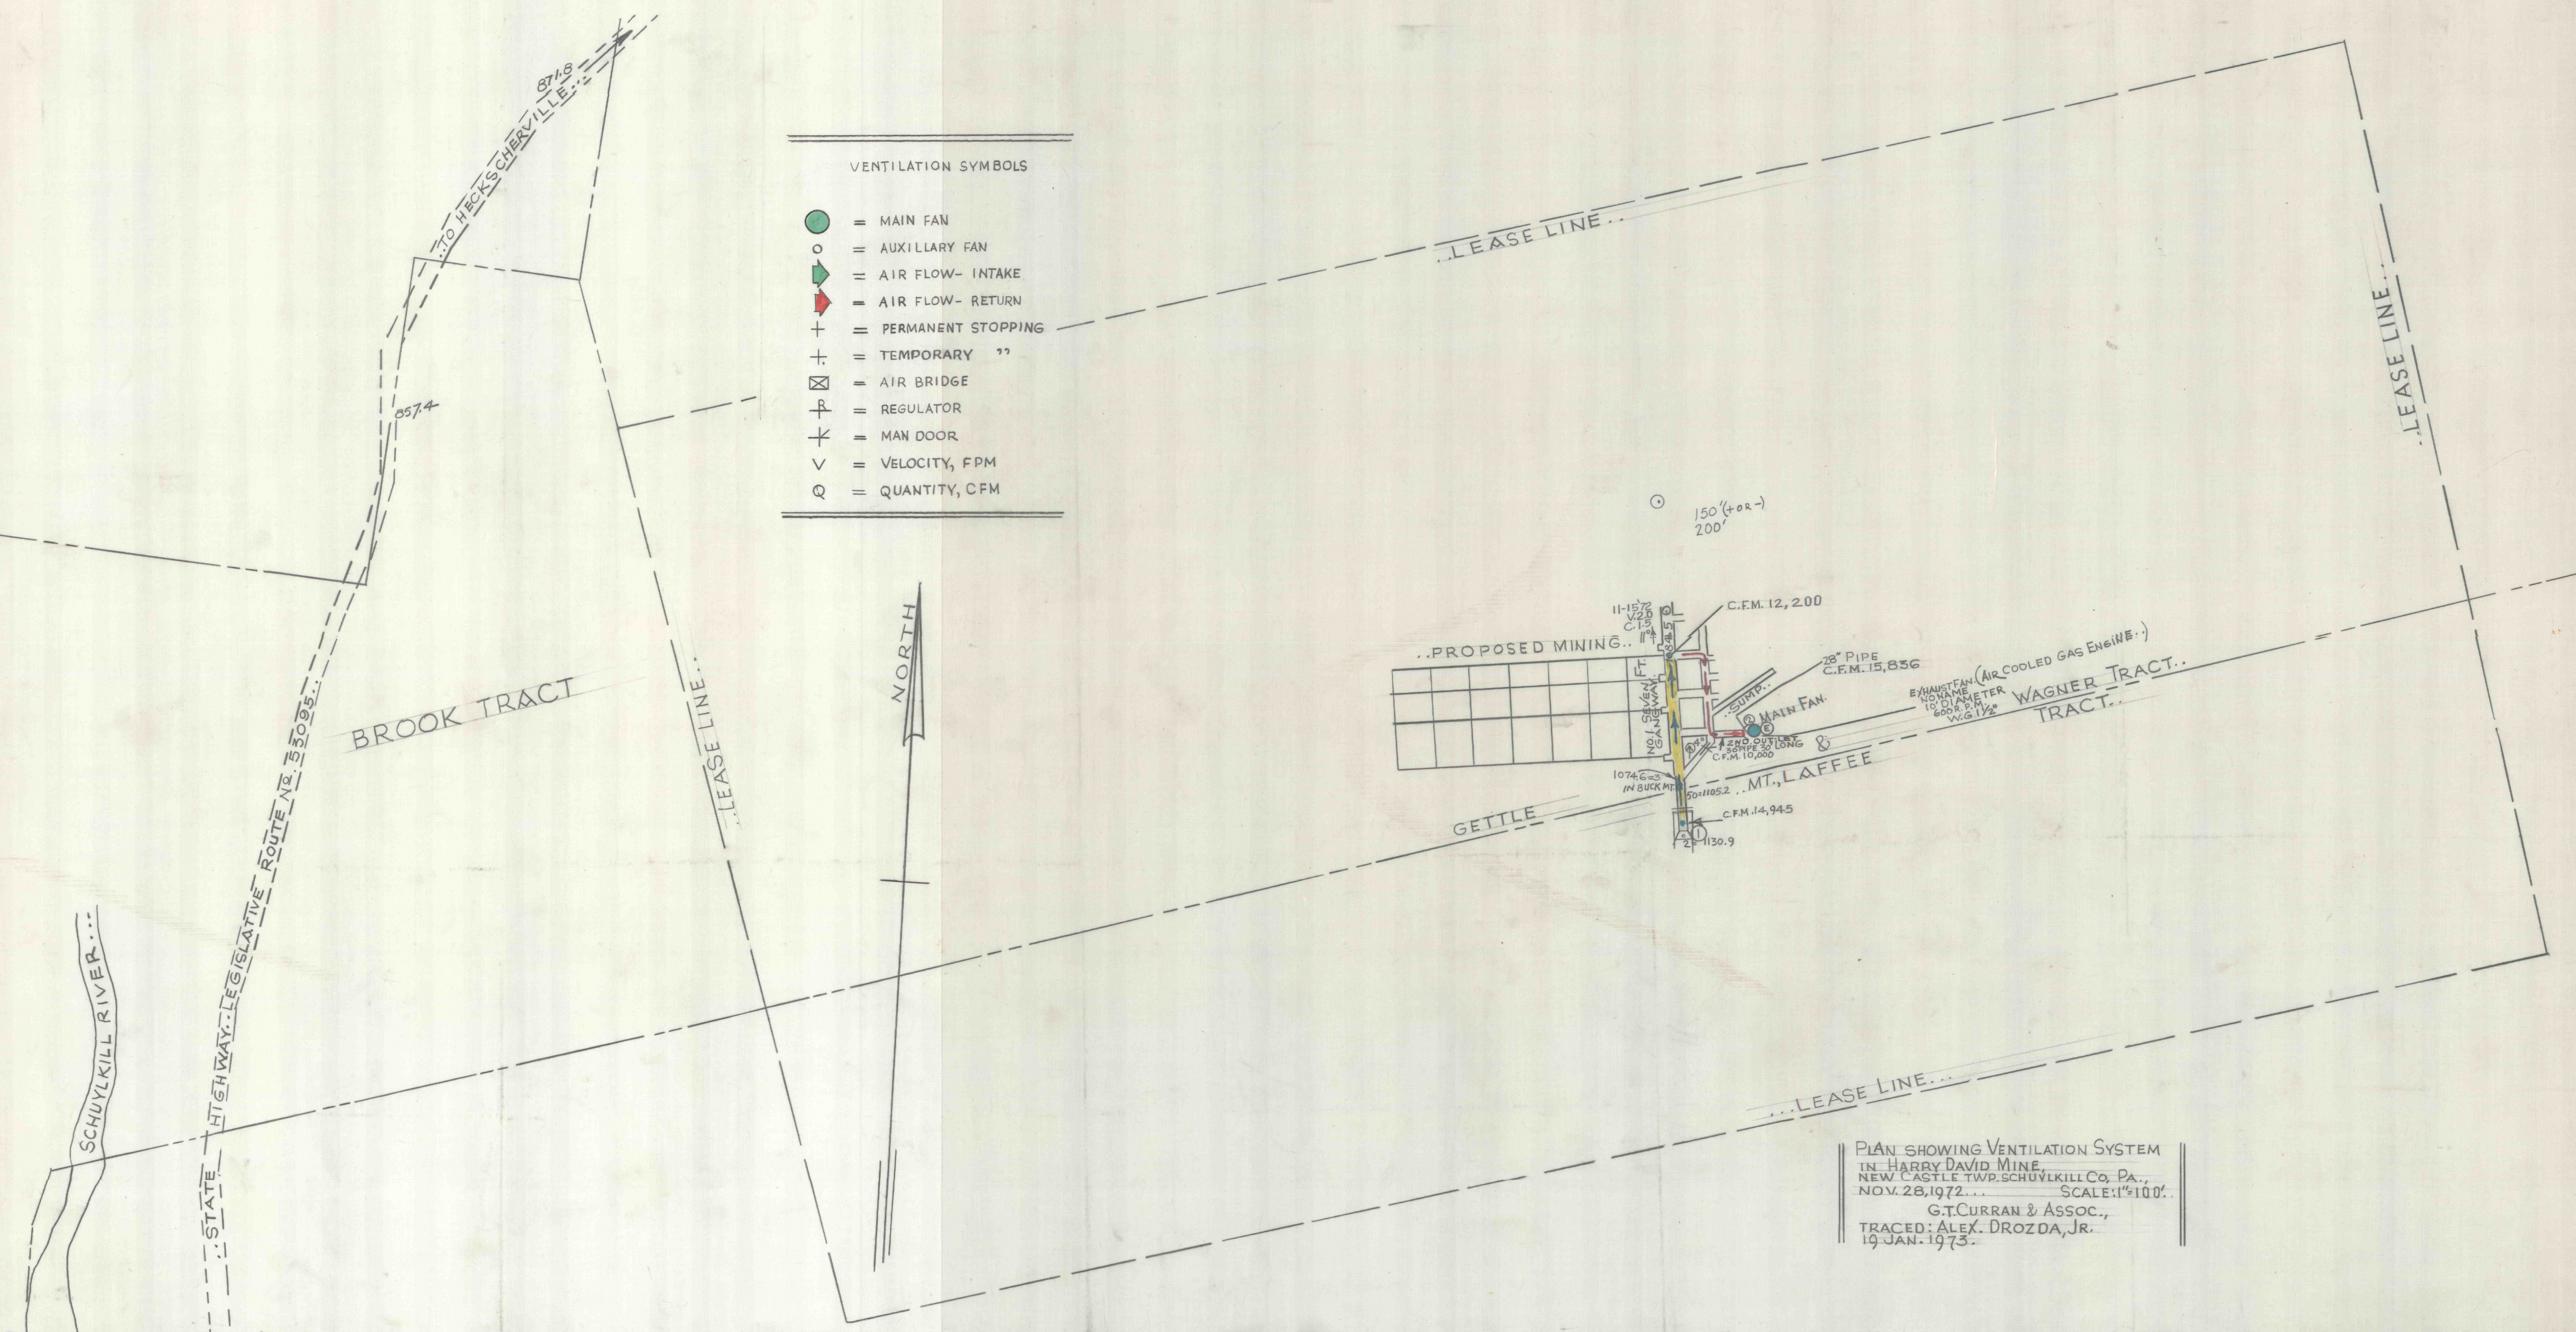

PLAN SHOWING VENTILATION SYSTEM
 IN HARRY DAVID MINE,
 NEW CASTLE TWP. SCHUYLKILL CO. PA.,
 NOV. 28, 1972... SCALE: 1"=100'
 G.T. CURRAN & ASSOC.,
 TRACED: ALEX. DROZDA, JR.,
 19 JAN. 1973.