



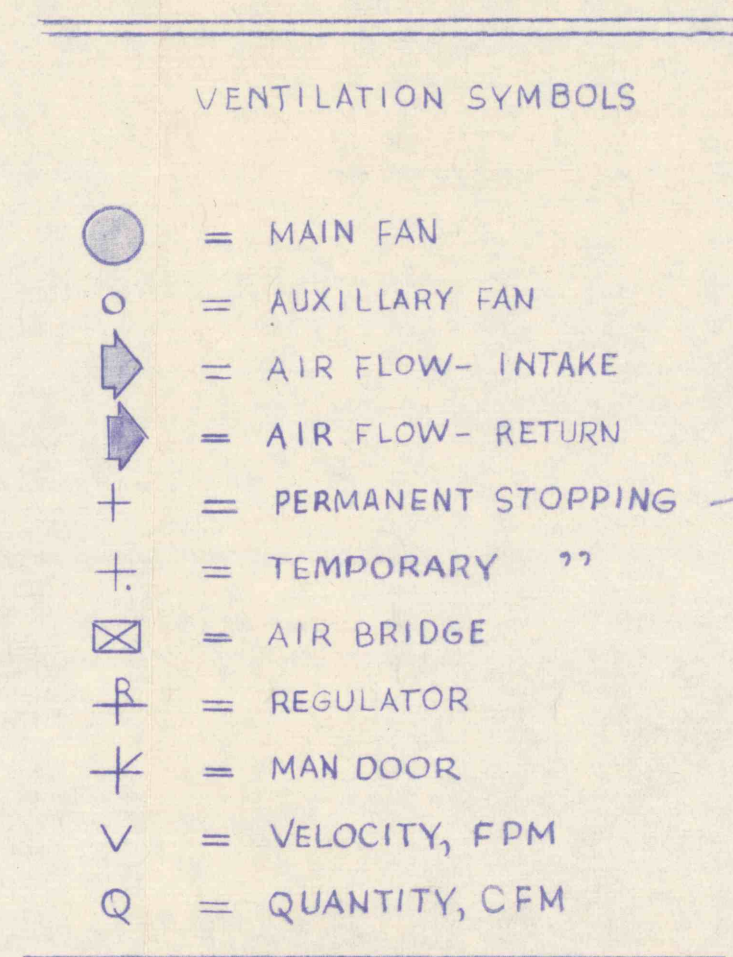

NORTH

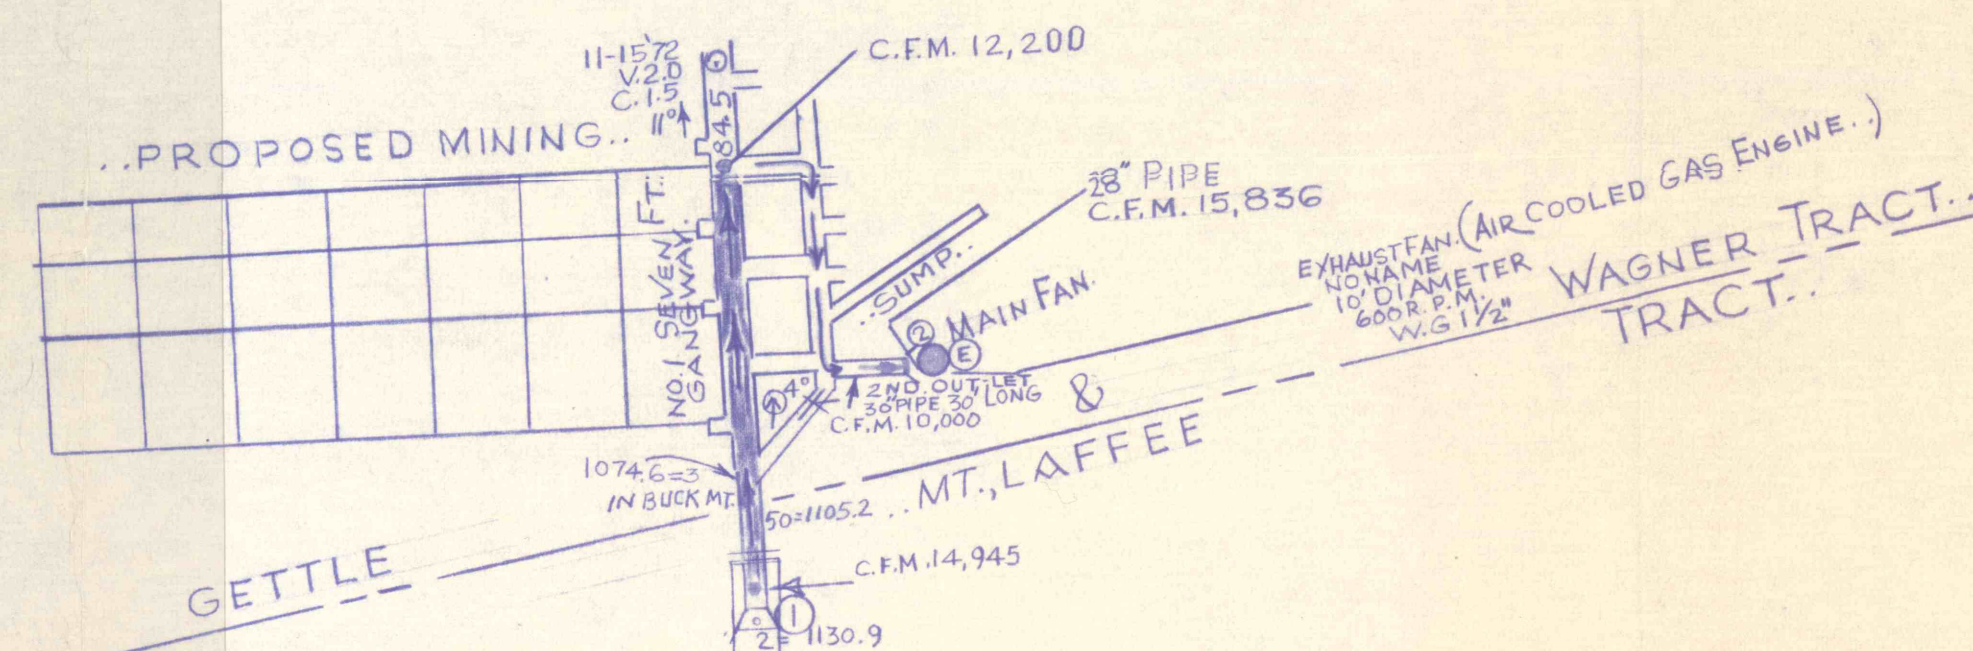

PLAN SHOWING VENTILATION SYSTEM
IN HARRY DAVID MINE,
NEW CASTLE TWP. SCHUYLKILL CO., PA.,
NOV. 28, 1972. SCALE: 1"=100'.
G.T. CURRAN & ASSOC.,
TRACED: ALEX. DROZDA, JR.,
19 JAN. 1973.