


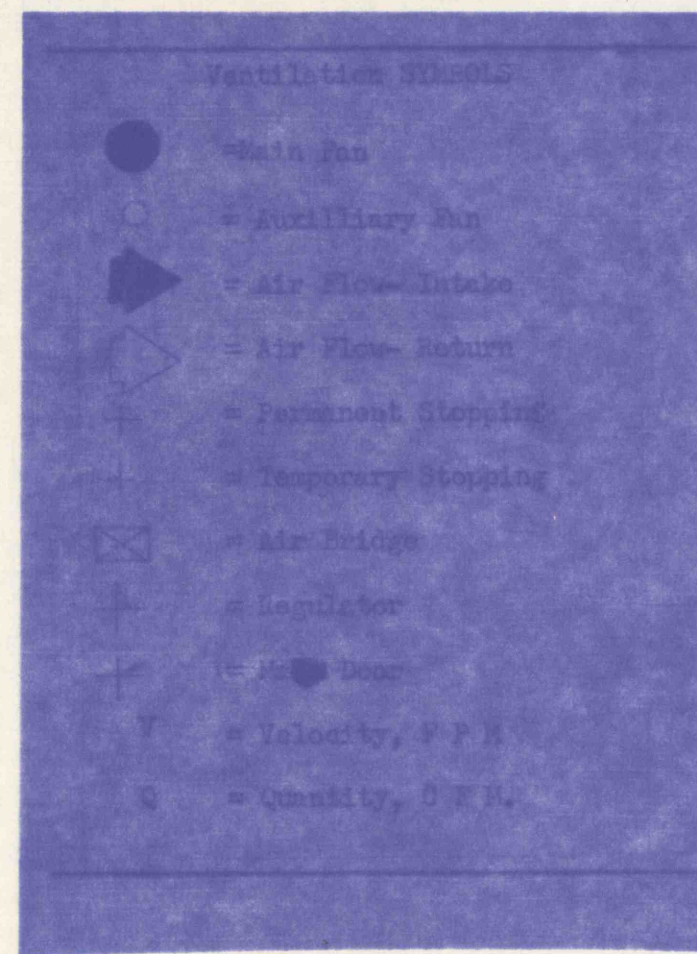

NORTH

BROOK TRACT

SCHUYLKILL RIVER...


STATE HIGHWAY LEG SLATE ROUTE NO. 3095

TO HECKSCHERVILLE

LEASE LINE..

LEASE LINE..

LEASE LINE..

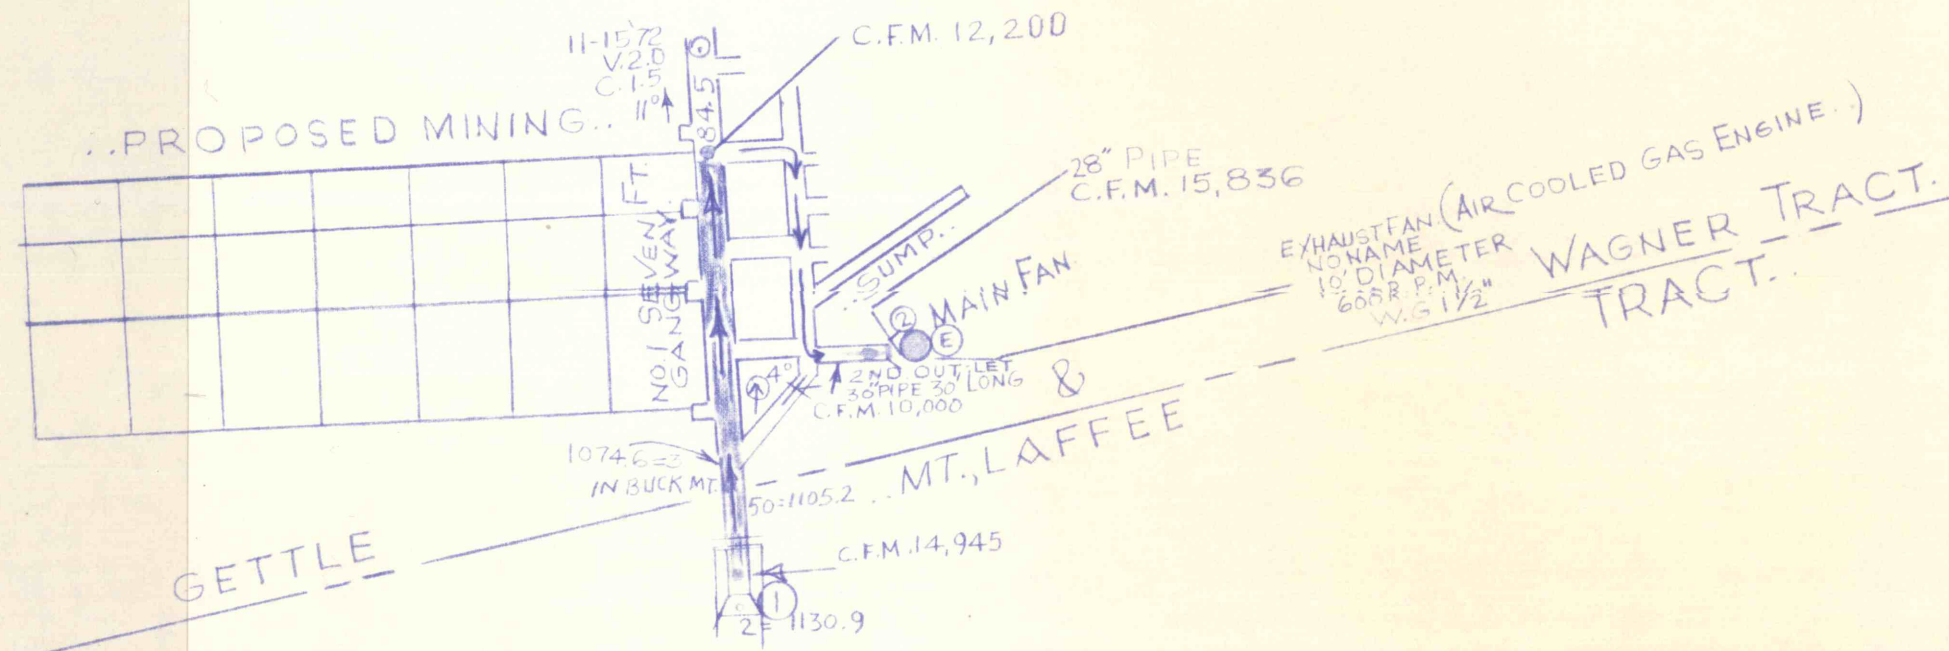

PLAN SHOWING VENTILATION SYSTEM
IN HARRY DAVID MINE,
NEW CASTLE TWP. SCHUYLKILL CO. PA.,
NOV. 28, 1972. SCALE: 1"=100'
G.T. CURRAN & ASSOC.,
TRACED: ALEX. DROZDA, JR.,
19 JAN. 1973.