


MF
DEC 12 1974

CLARK VEIN
FEEDERDAM SECTION

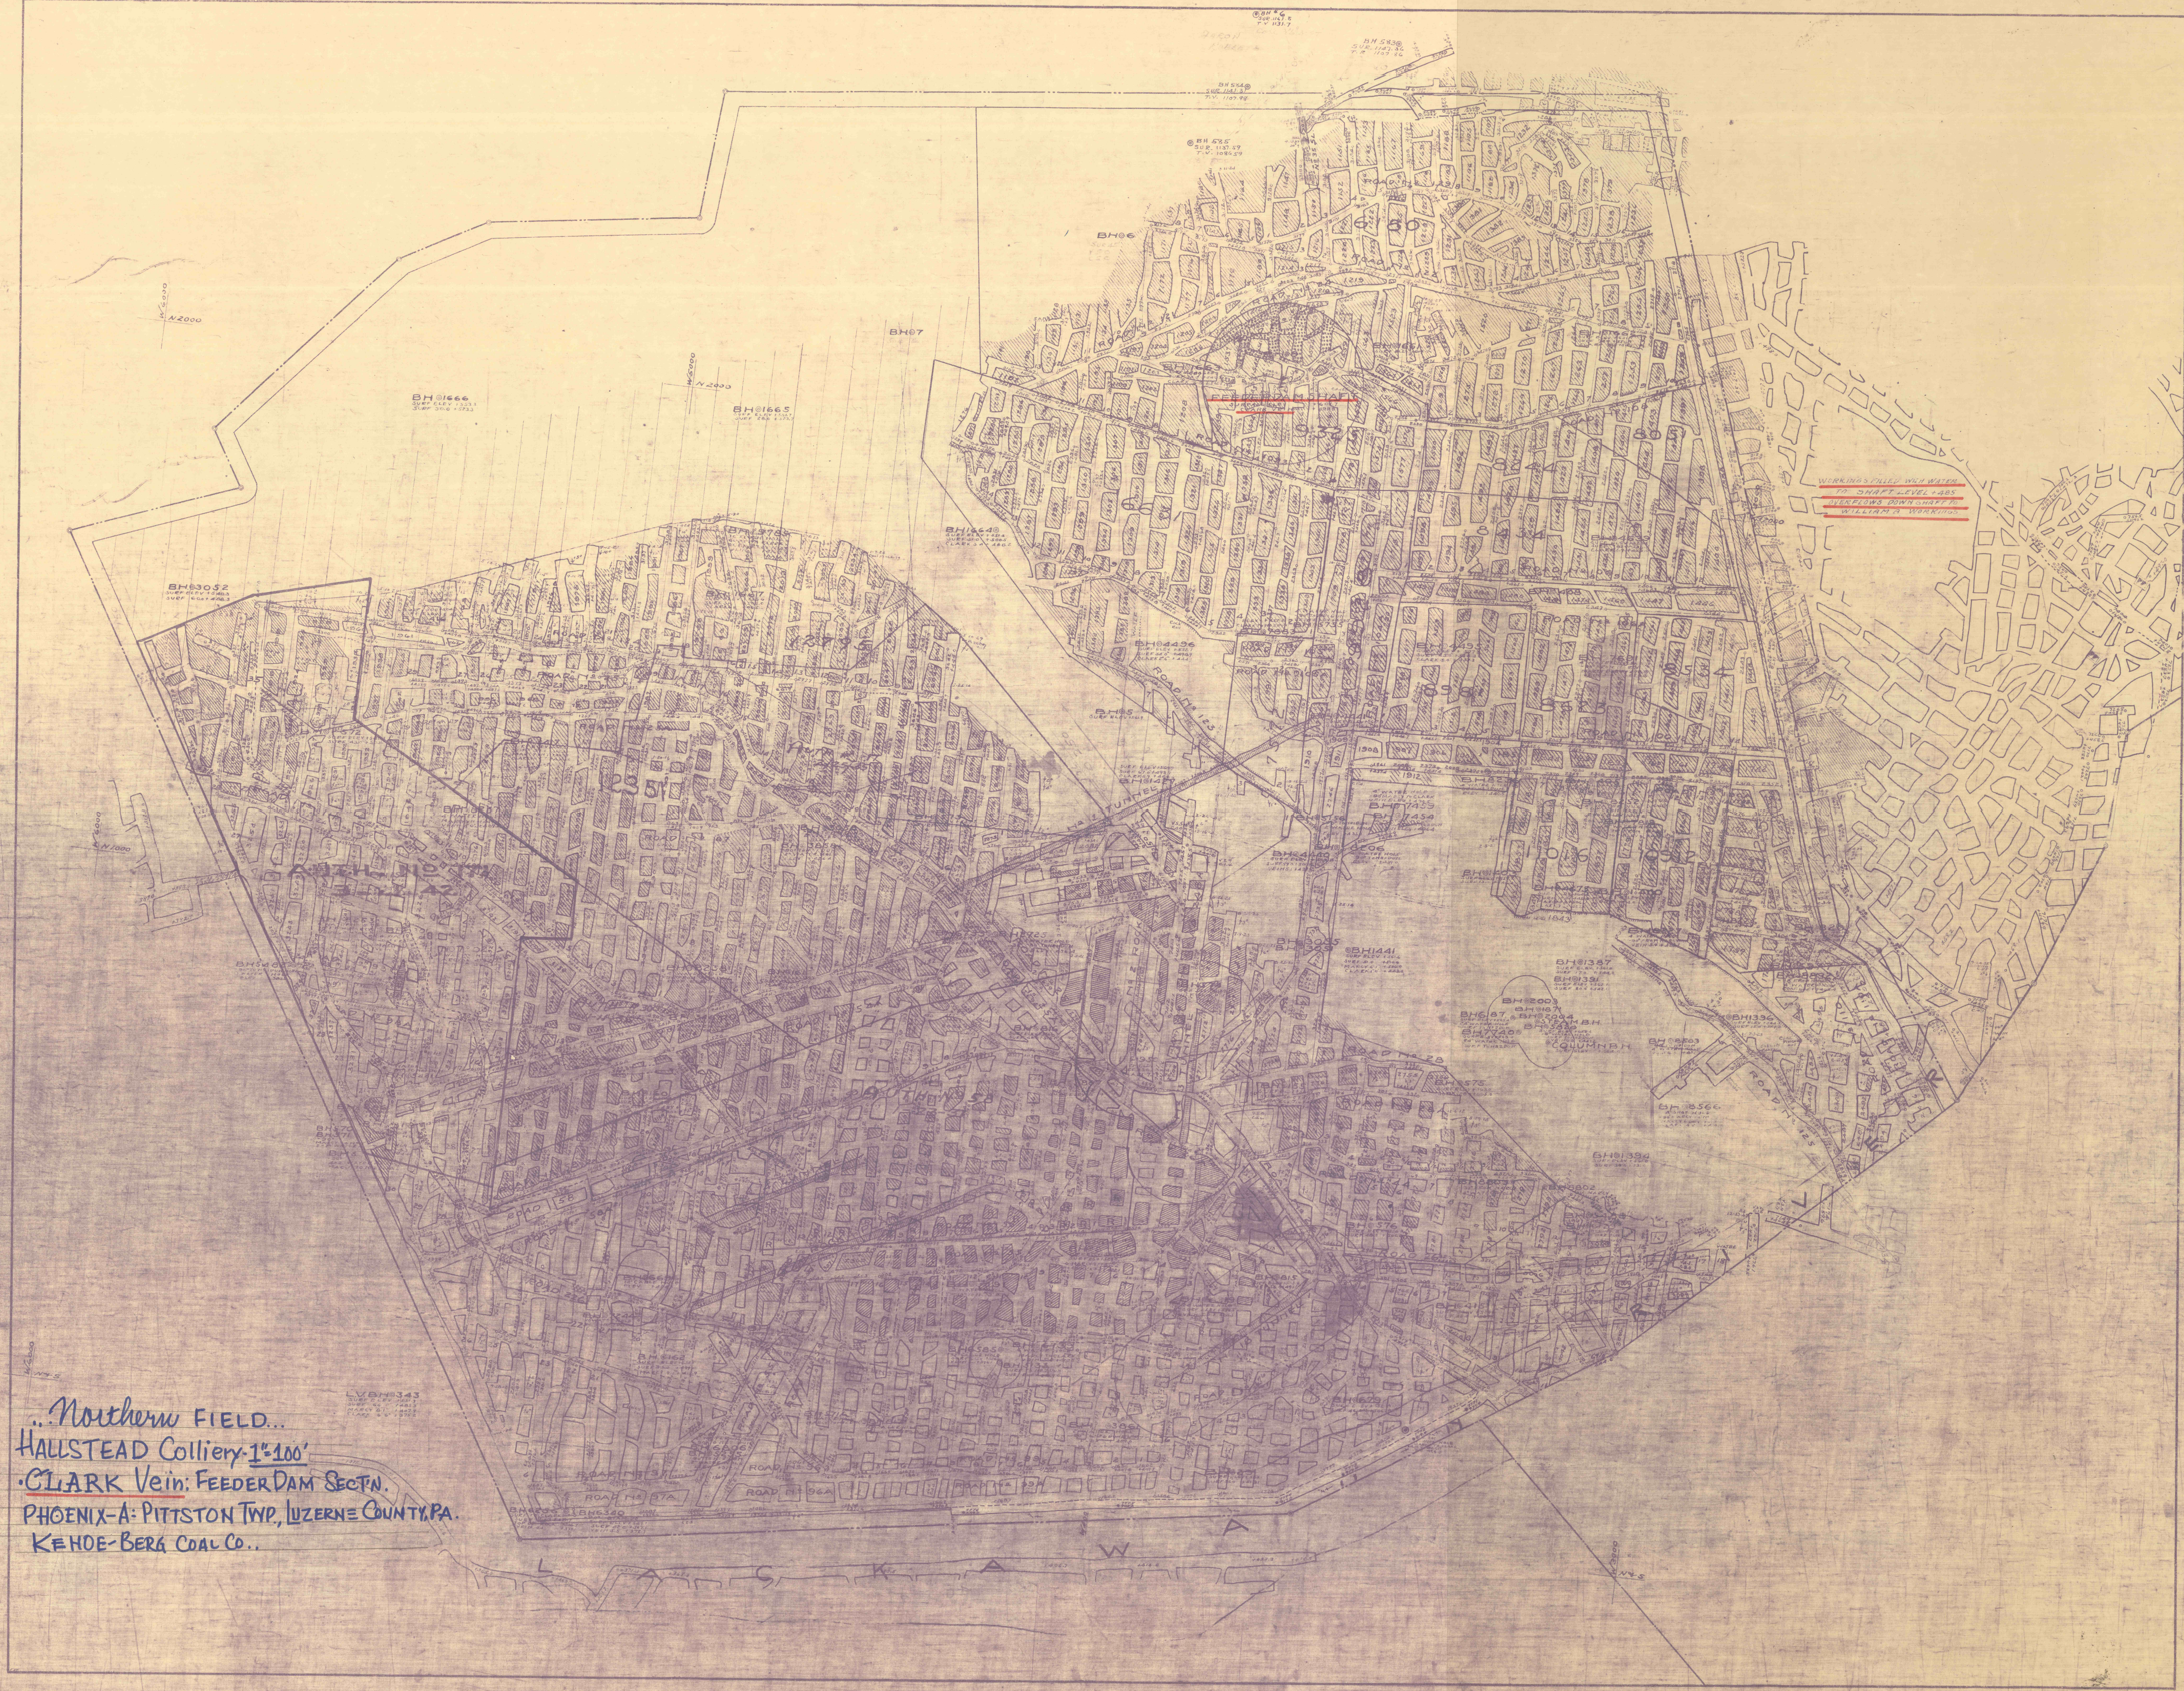

CLARK VEIN
FEEDERDAM SECTION

..Northern Field..
Hallstead Colliery 1" x 100'
CLARK Vein: FEEDERDAM SECTN.
KEHOE-BERG COAL CO..

MF DEC 12 1974