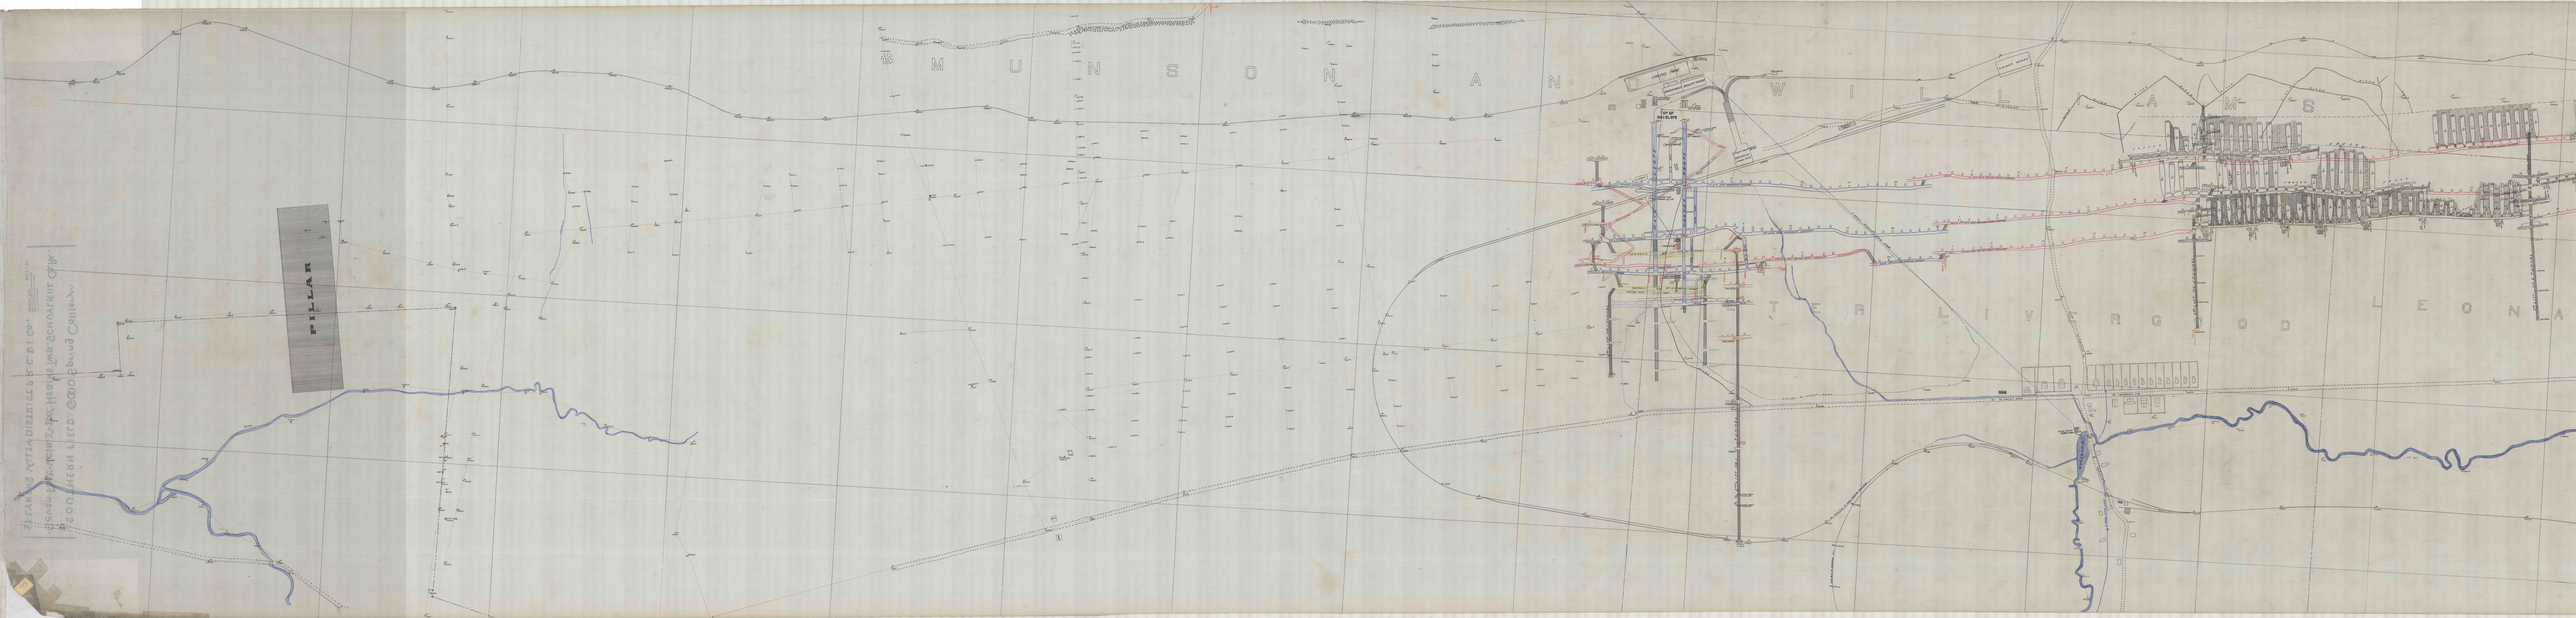
M U N S O N
A N
W I L L I A M S
T E R
L I V
R G O D
L E O N A
PILLAR