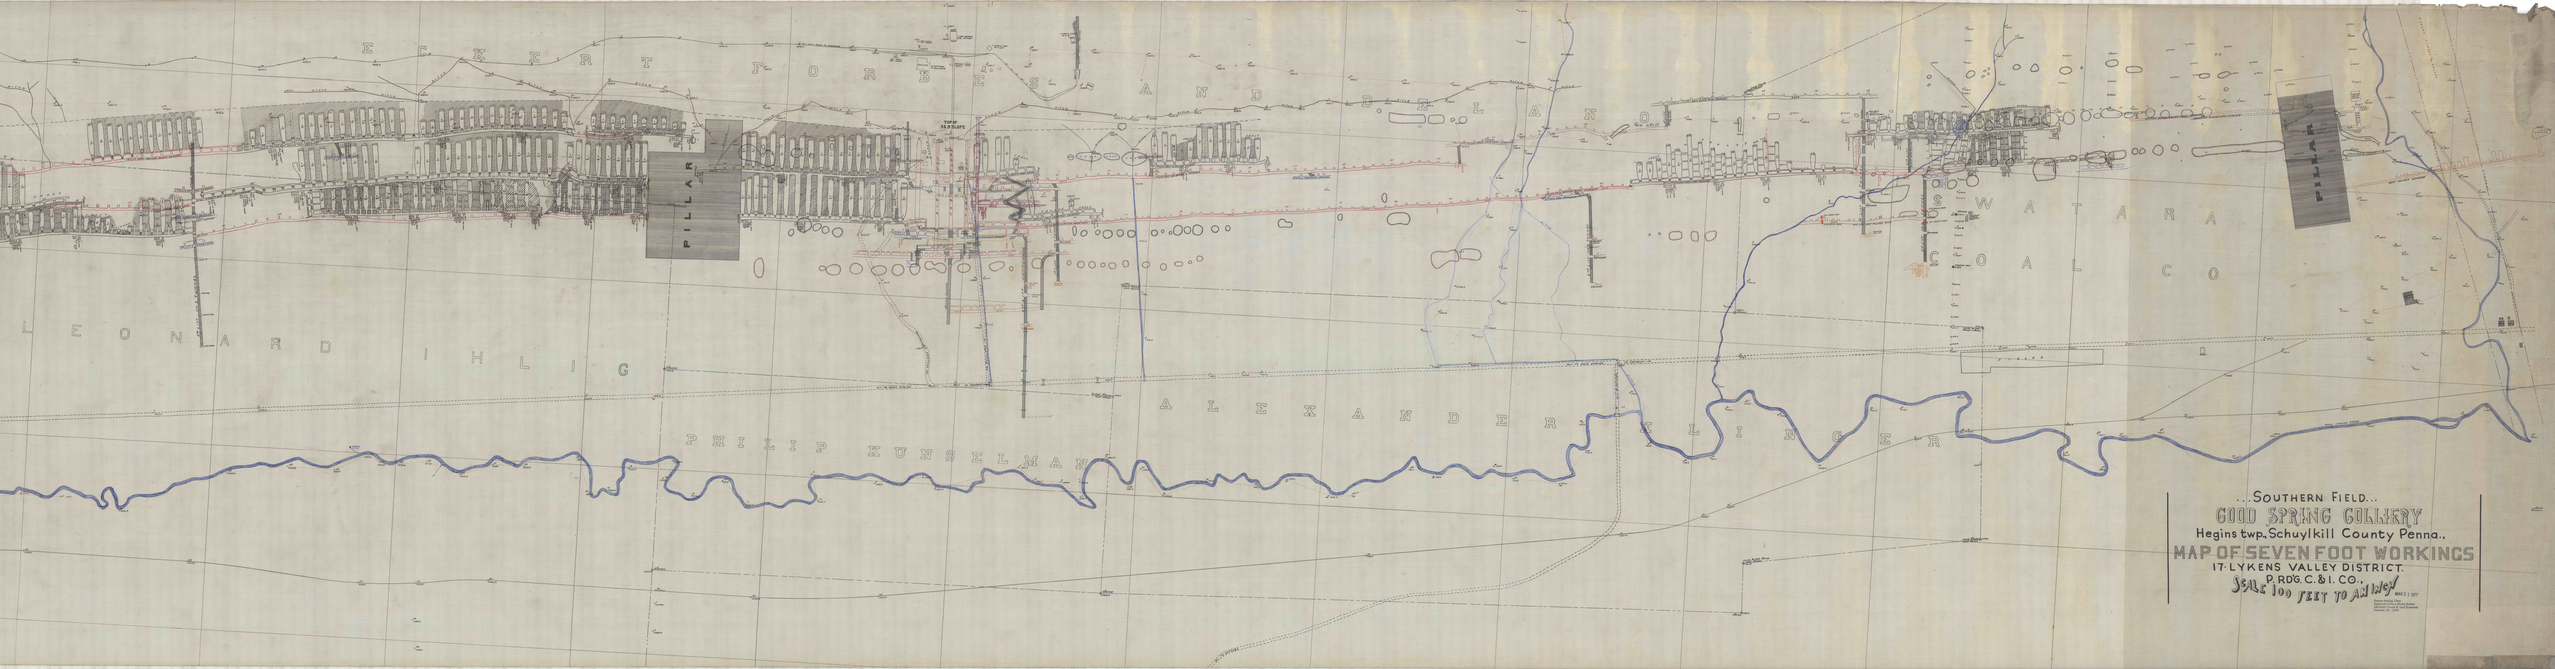

...SOUTHERN FIELD...

GOOD SPRING COLLIERY

Hegins twp., Schuylkill County Penna.,

MAP OF SEVEN FOOT WORKINGS

17-LYKENS VALLEY DISTRICT.

P. RDG. C. & I. CO.,

SCALE 100 FEET TO AN INCH