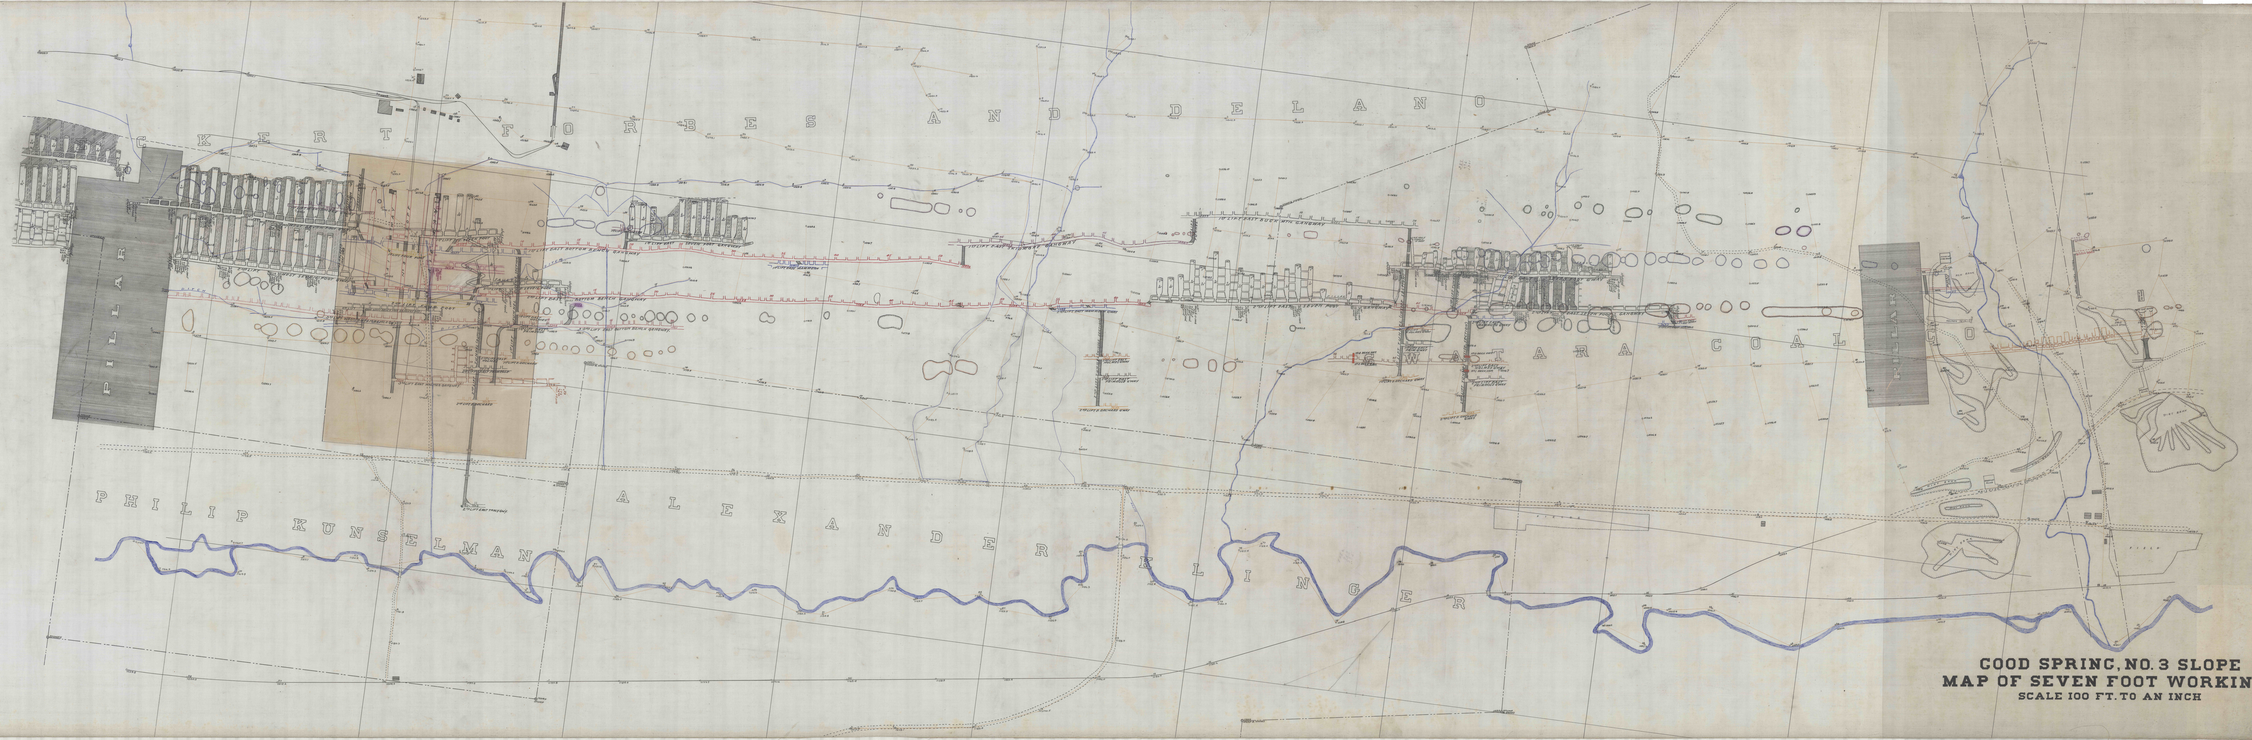


GOOD SPRING, NO. 3 SLOPE
MAP OF SEVEN FOOT WORKINGS
SCALE 100 FT. TO AN INCH