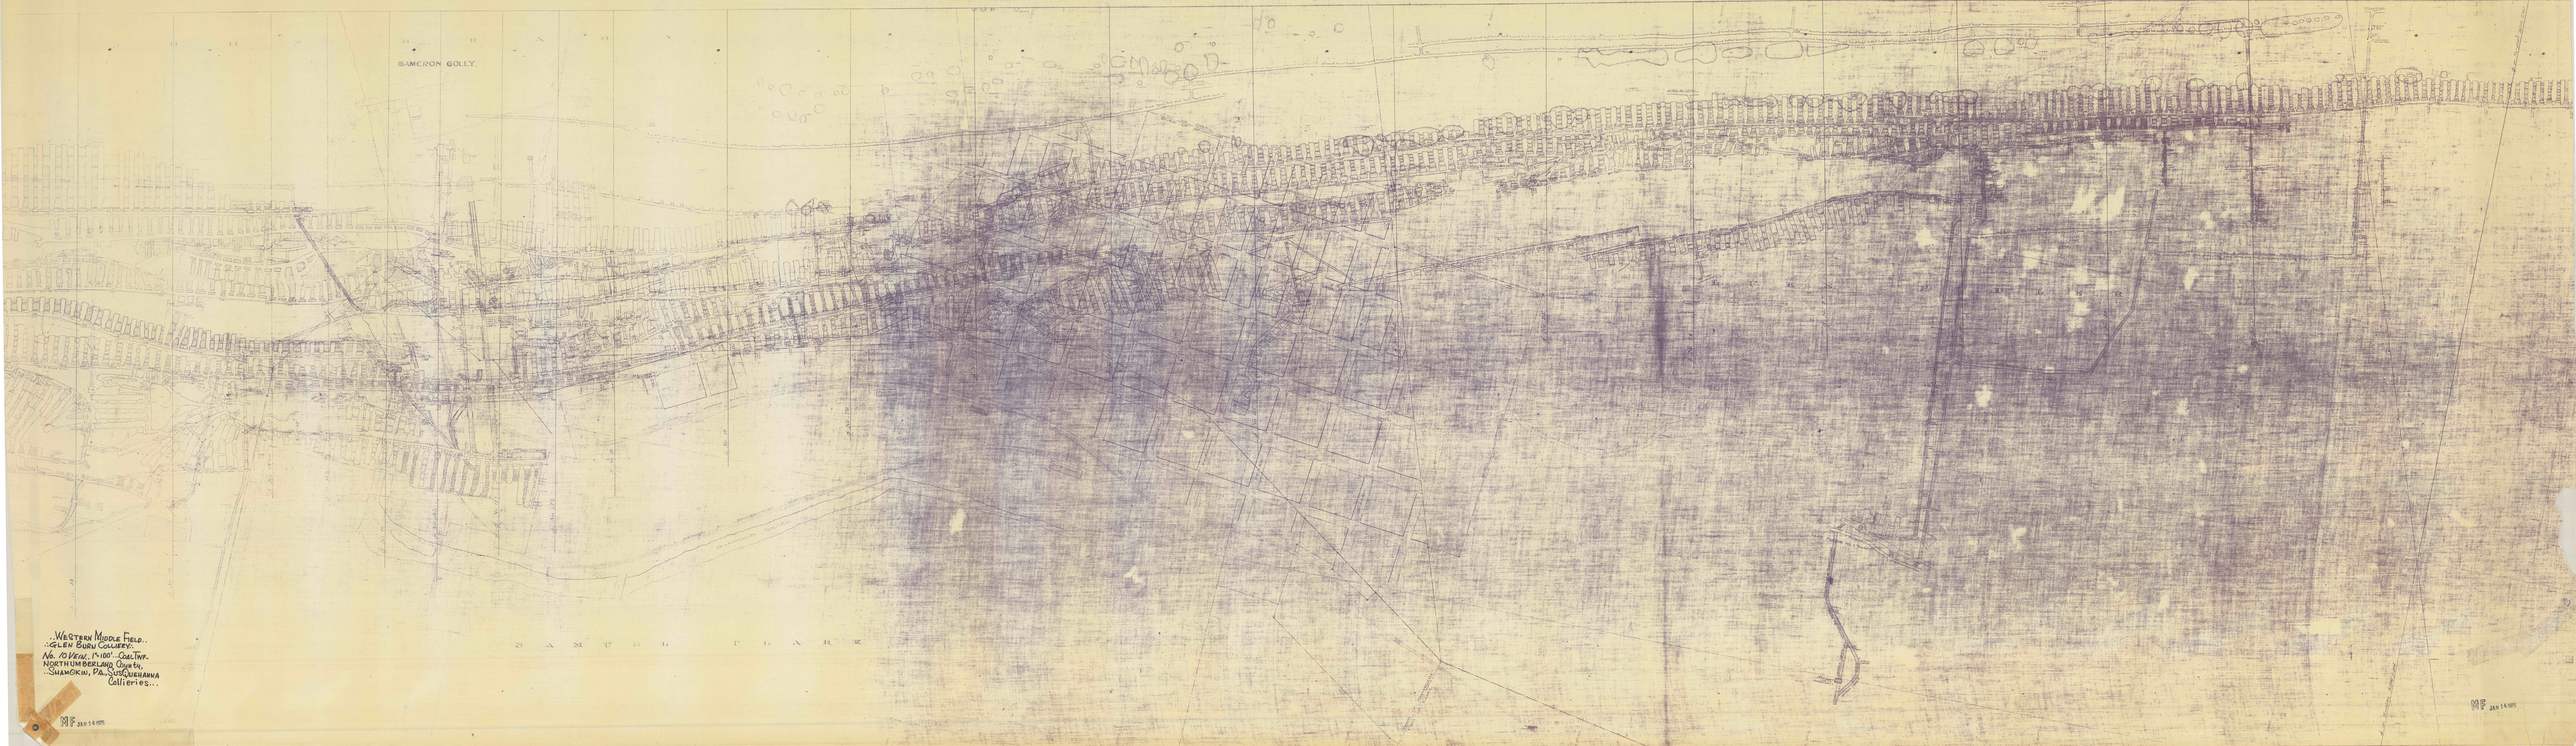

CAMERON COLLY.
..WESTERN MIDDLE FIELD..
..GLEN BURN COLLIERY..
NORTHUMBERLAND COUNTY,
..SHAMOKIN, PA., SUSQUEHANNA
MF JAN 14 1975
MF JAN 14 1975