
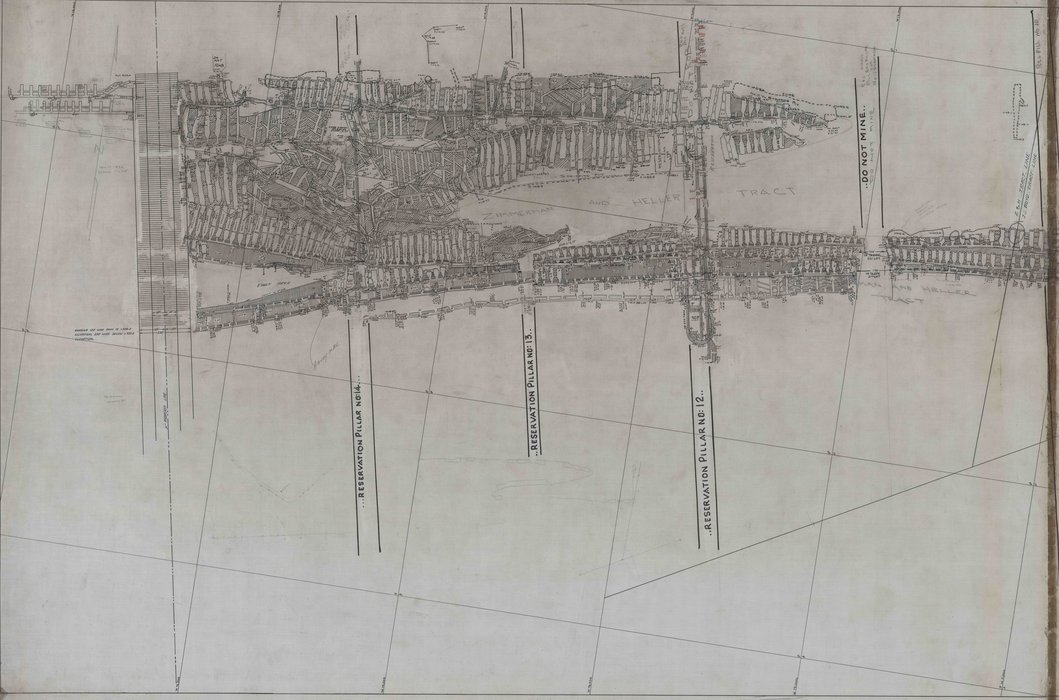


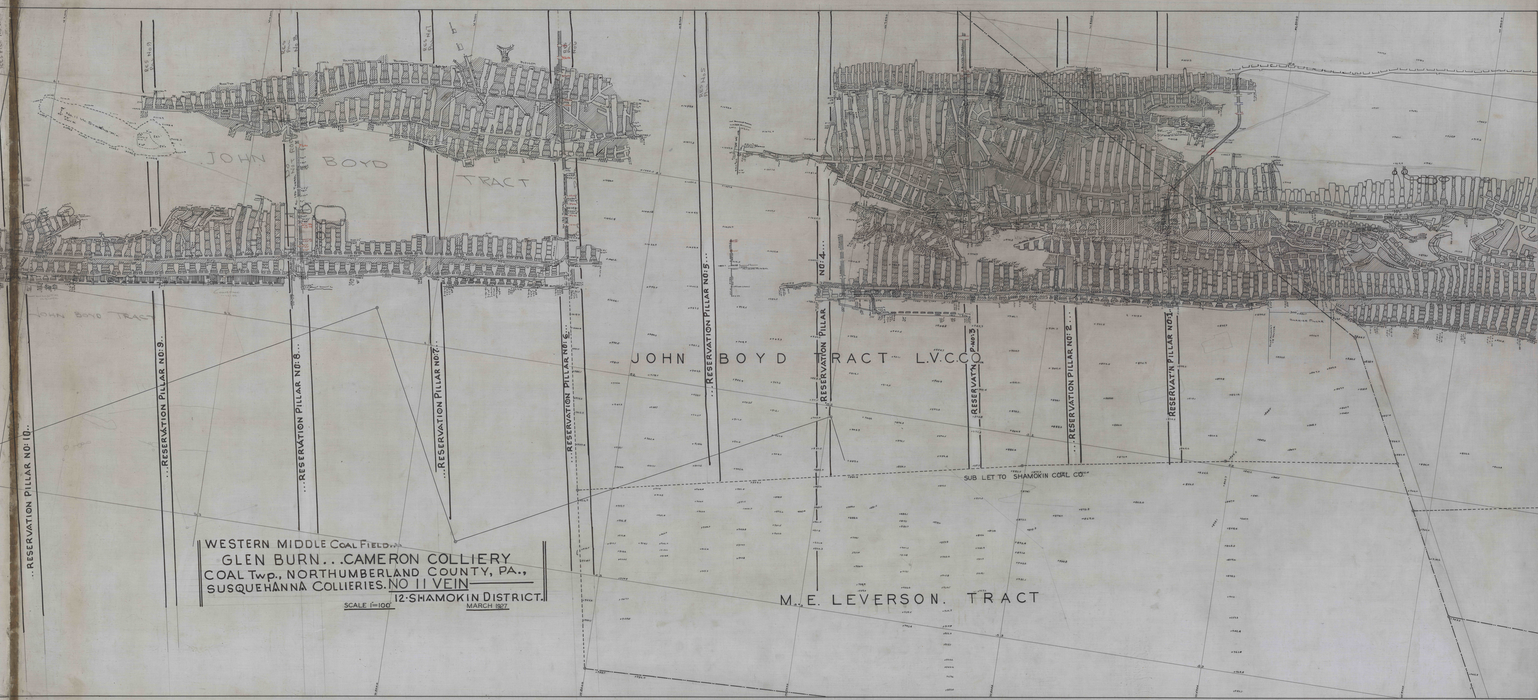

WESTERN MIDDLE COAL FIELD.
GLEN BURN. . . CAMERON COLLIERY
COAL Twp., NORTHUMBERLAND COUNTY, PA.,
SUSQUEHANNA COLLIERIES. NO 11 VEIN
12 SHAMOKIN DISTRICT.
SCALE 1"=100' MARCH 1927