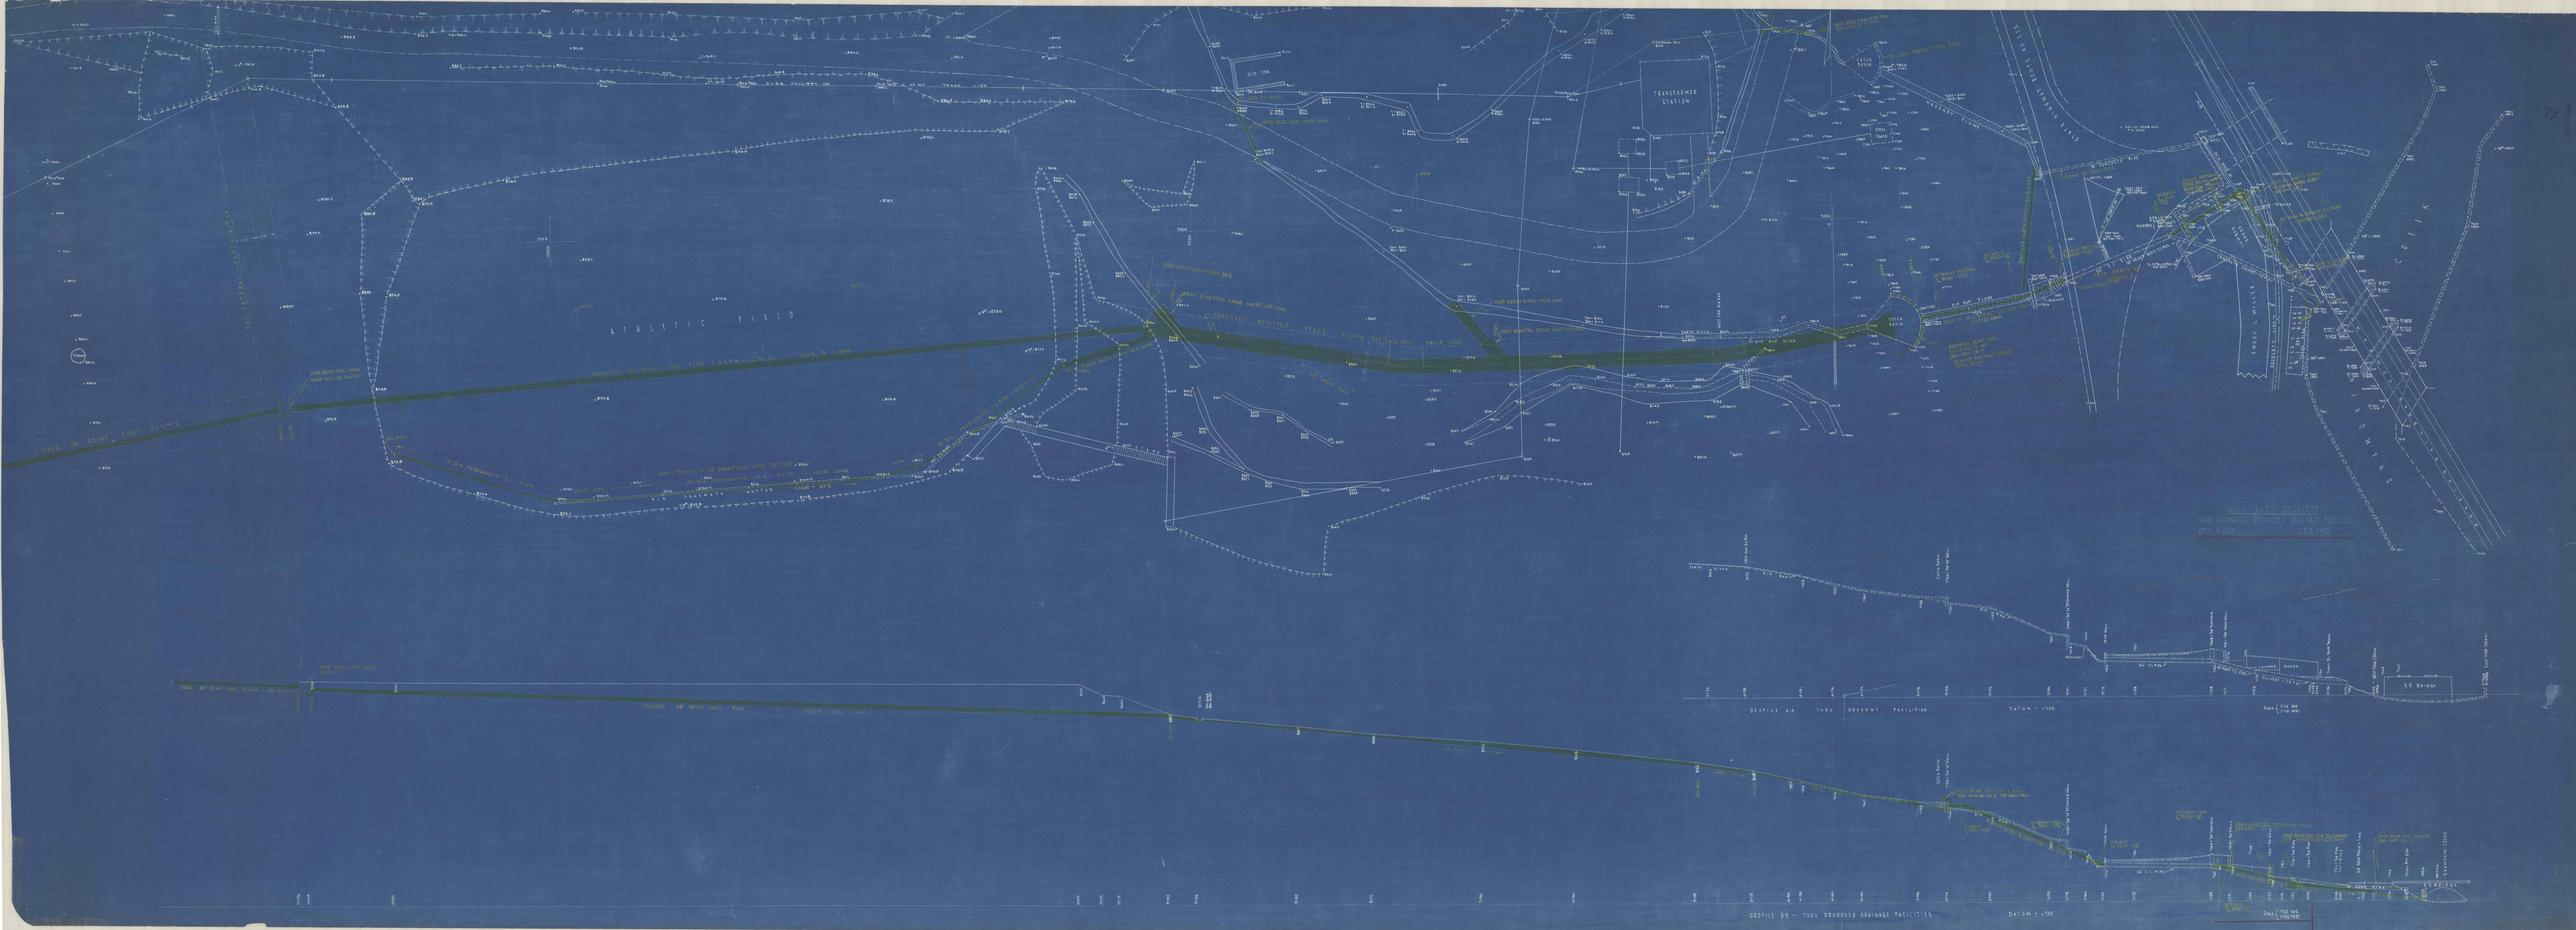
ATHLETIC FIELD
TRANSFORMER STATION
PROFILE 6-6 THRU DESIGNATED FACILITIES
DATUM = 1700
PROFILE 8-8 - THRU DESIGNATED DRAINAGE FACILITIES
DATUM = 1700