


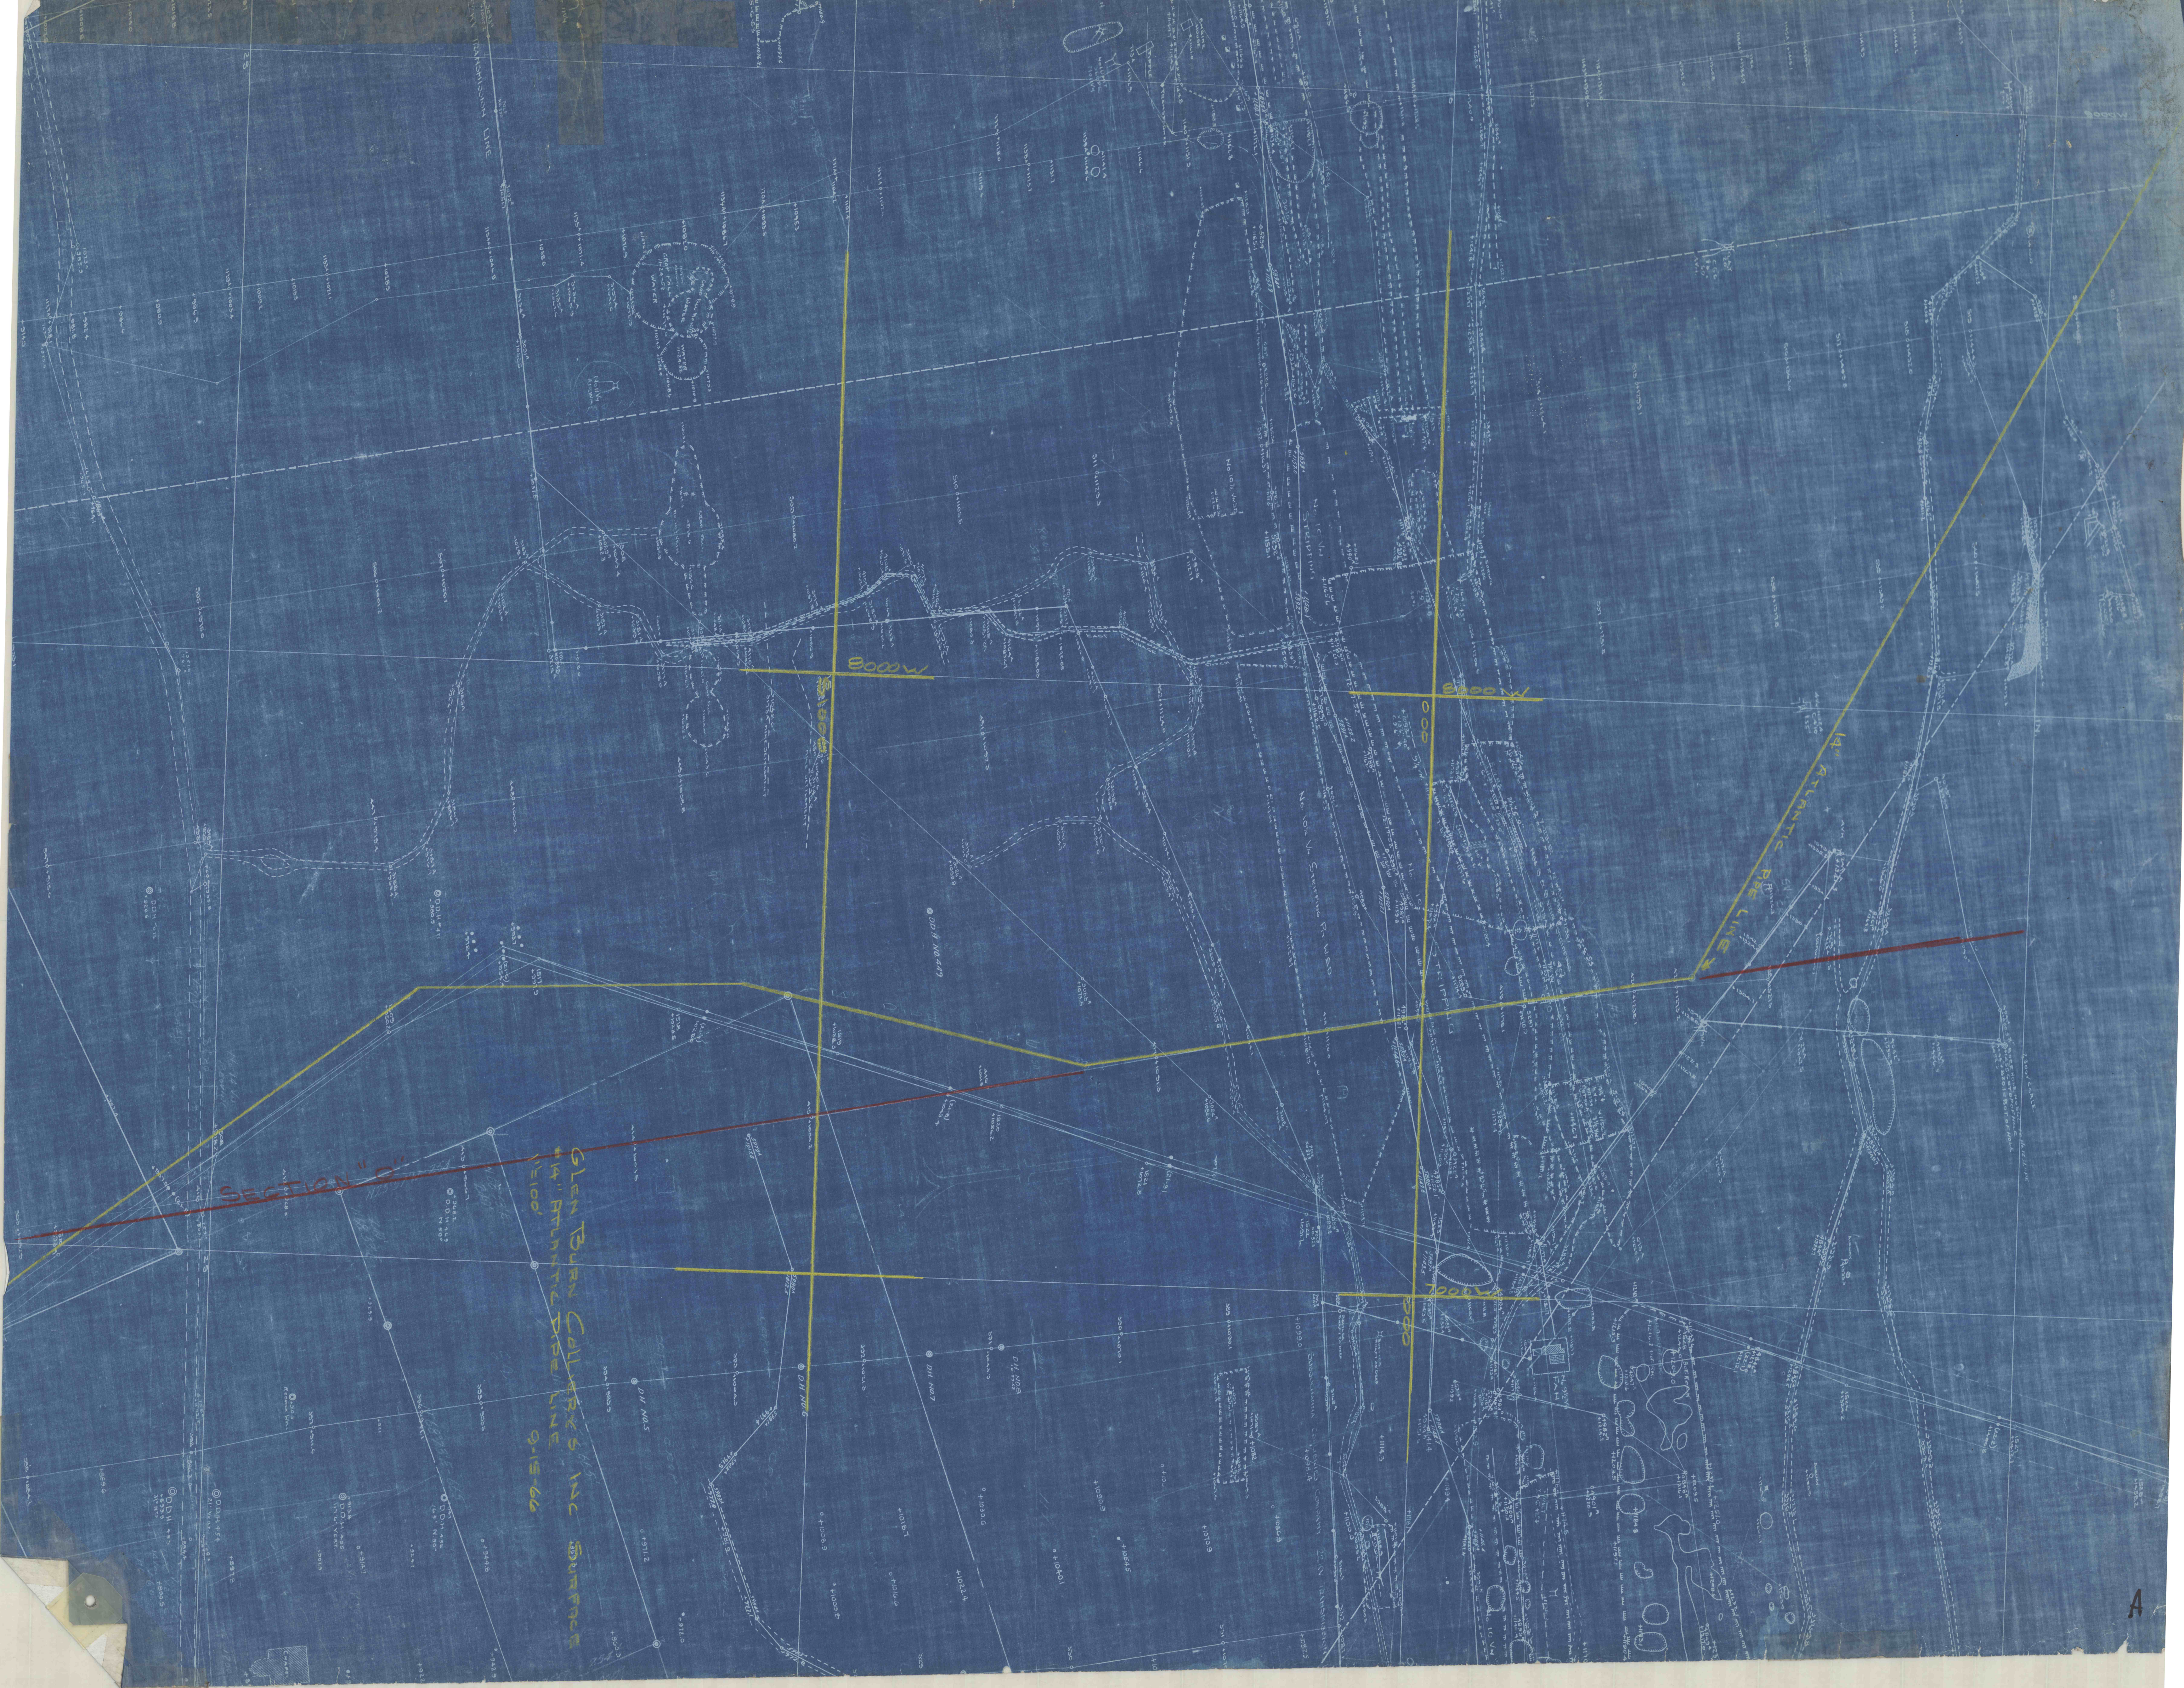

GLEN BURN CALLERS INC SURFACE
14" ATLANTIC PIPE LINE
9-15-66

SECTION "D" LINES

14" ATLANTIC PIPE LINE

8000W

8000W

000

1000W

500

DI NO.6

DI NO.7

DI NO.5

D.L. 1028

+1051.5

+1051.4

