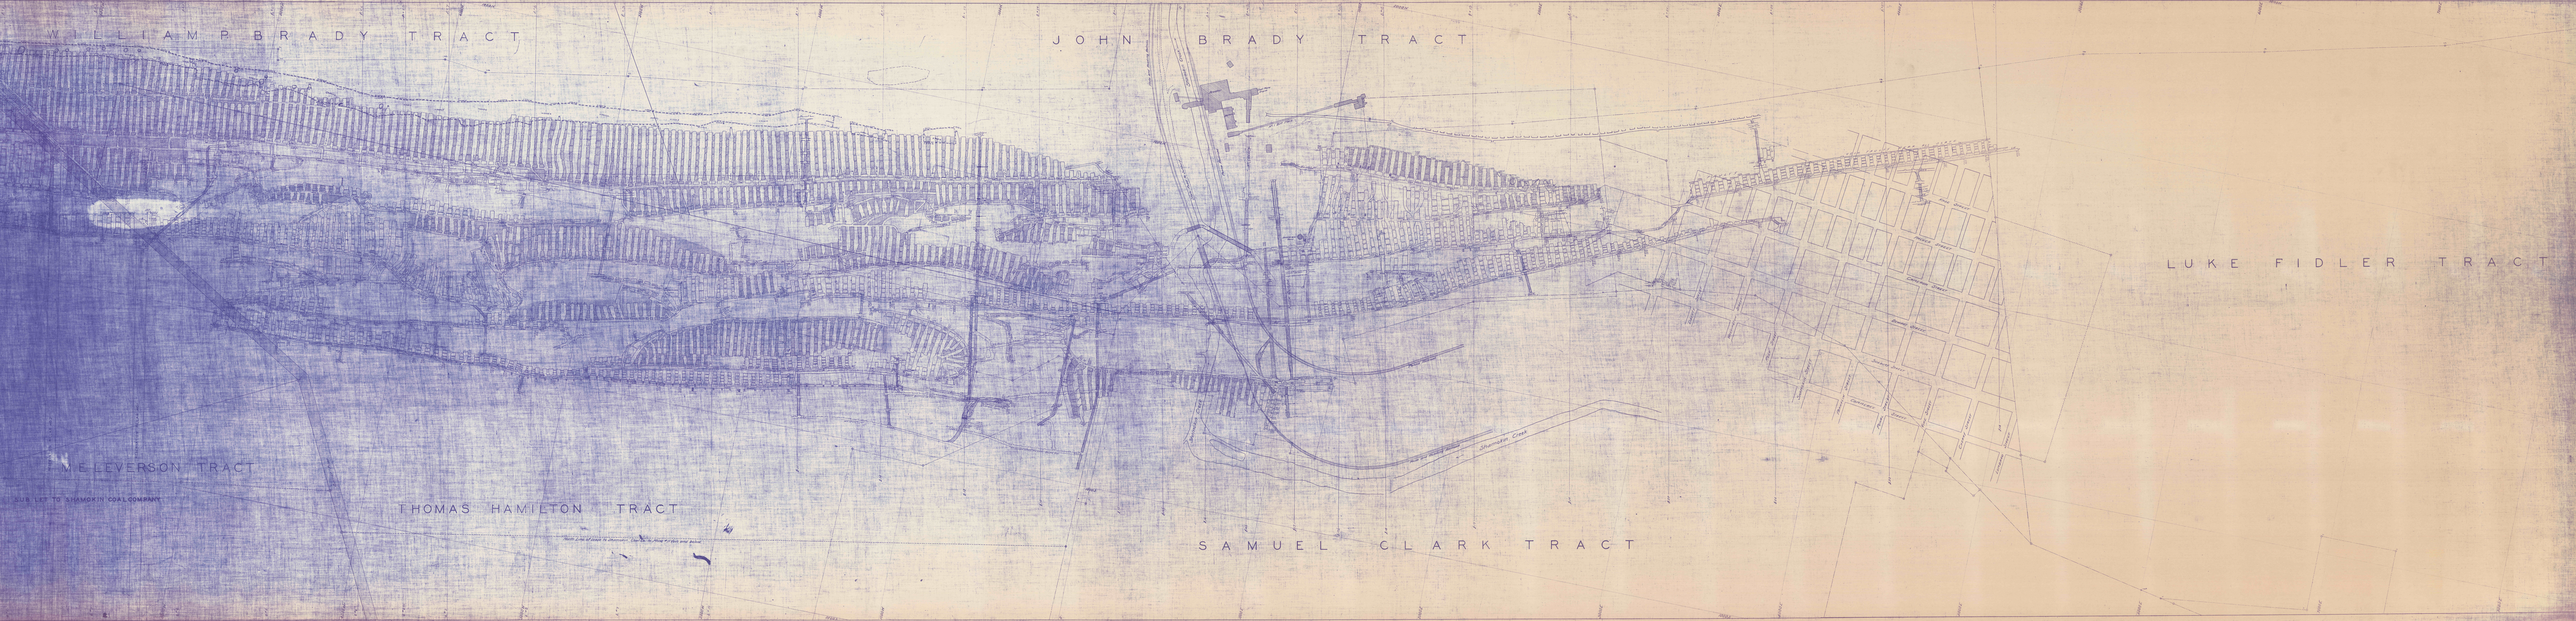
WILLIAM P BRADY TRACT
JOHN BRADY TRACT
LUKE FIDLER TRACT
E LEVERSON TRACT
SUB LET TO SHAMROCK COAL COMPANY
THOMAS HAMILTON TRACT
SAMUEL CLARK TRACT