


Western MIDDLE FIELD.
GLEN BURN COLLIERY
COAL TWP., NO 9½ VEIN SHAMOKIN DISTRICT.
L.V.C.CO. LEASE SUSQUEHANNA COLLIERIES.
SCALE 800 FEET TO AN INCH
NORTHUMBERLAND COUNTY, PA.

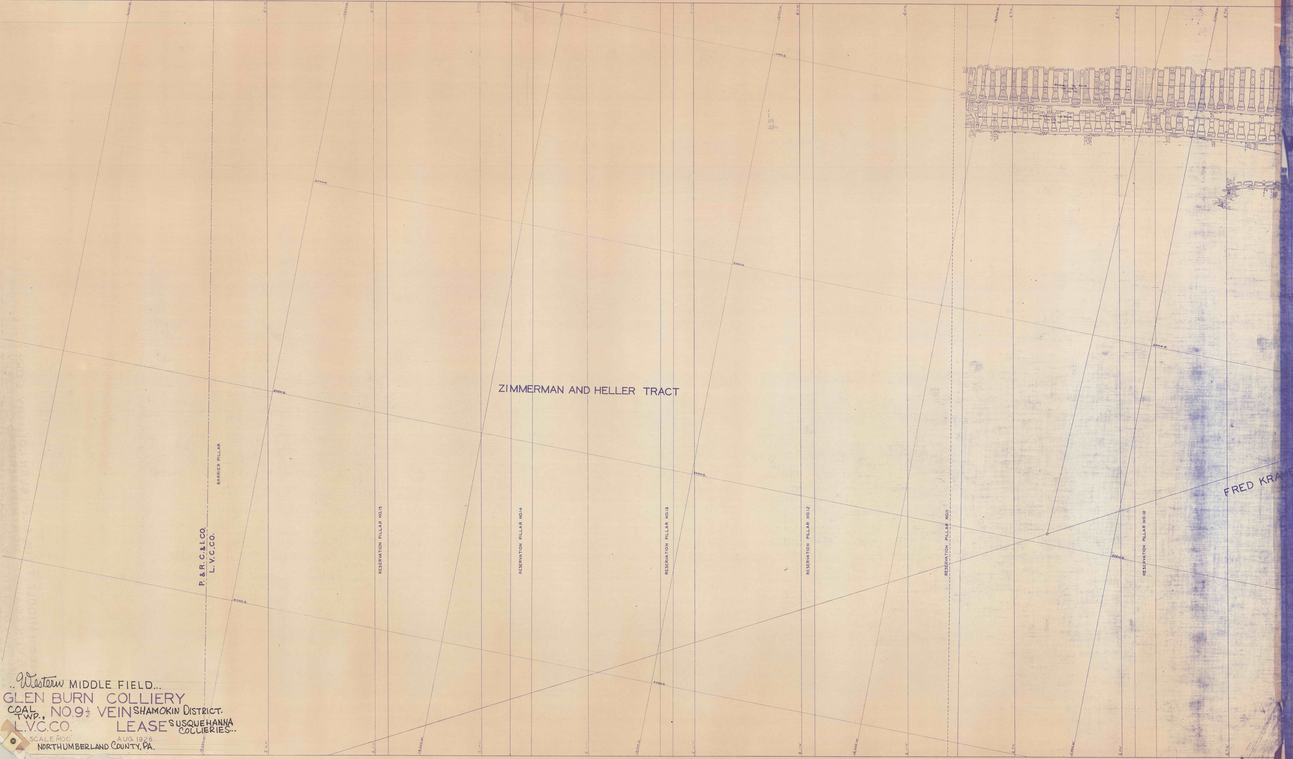