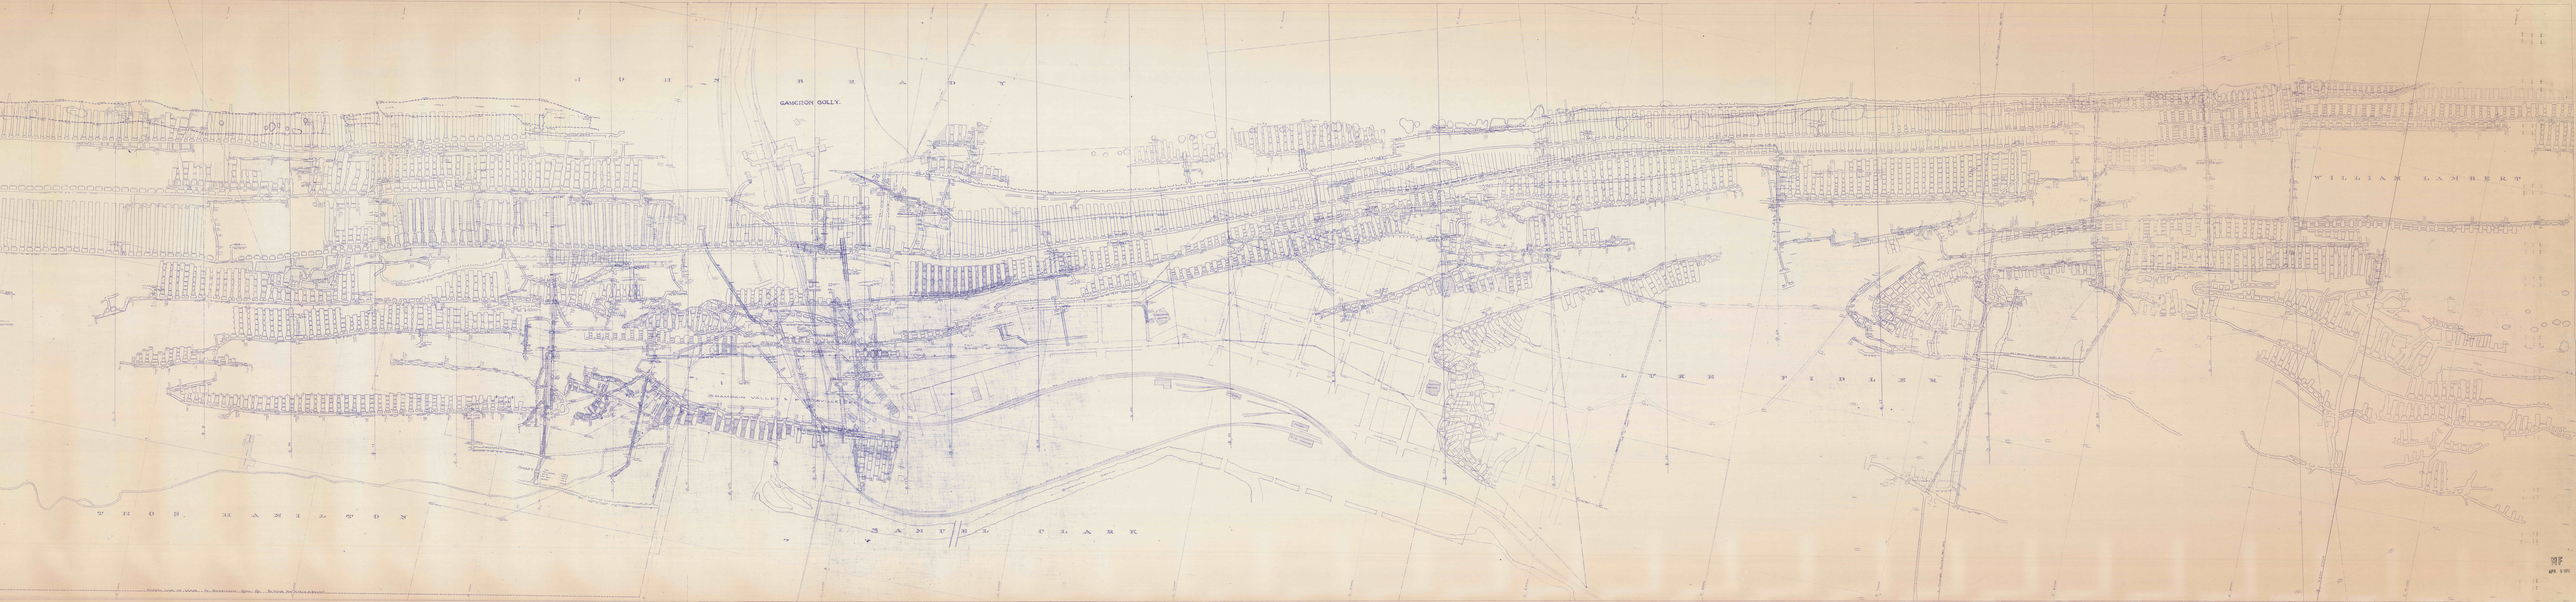
GANGTON GULLY.
WILLIAM LAMBERT
THOS. HAMILTON
SAMUEL CLARK