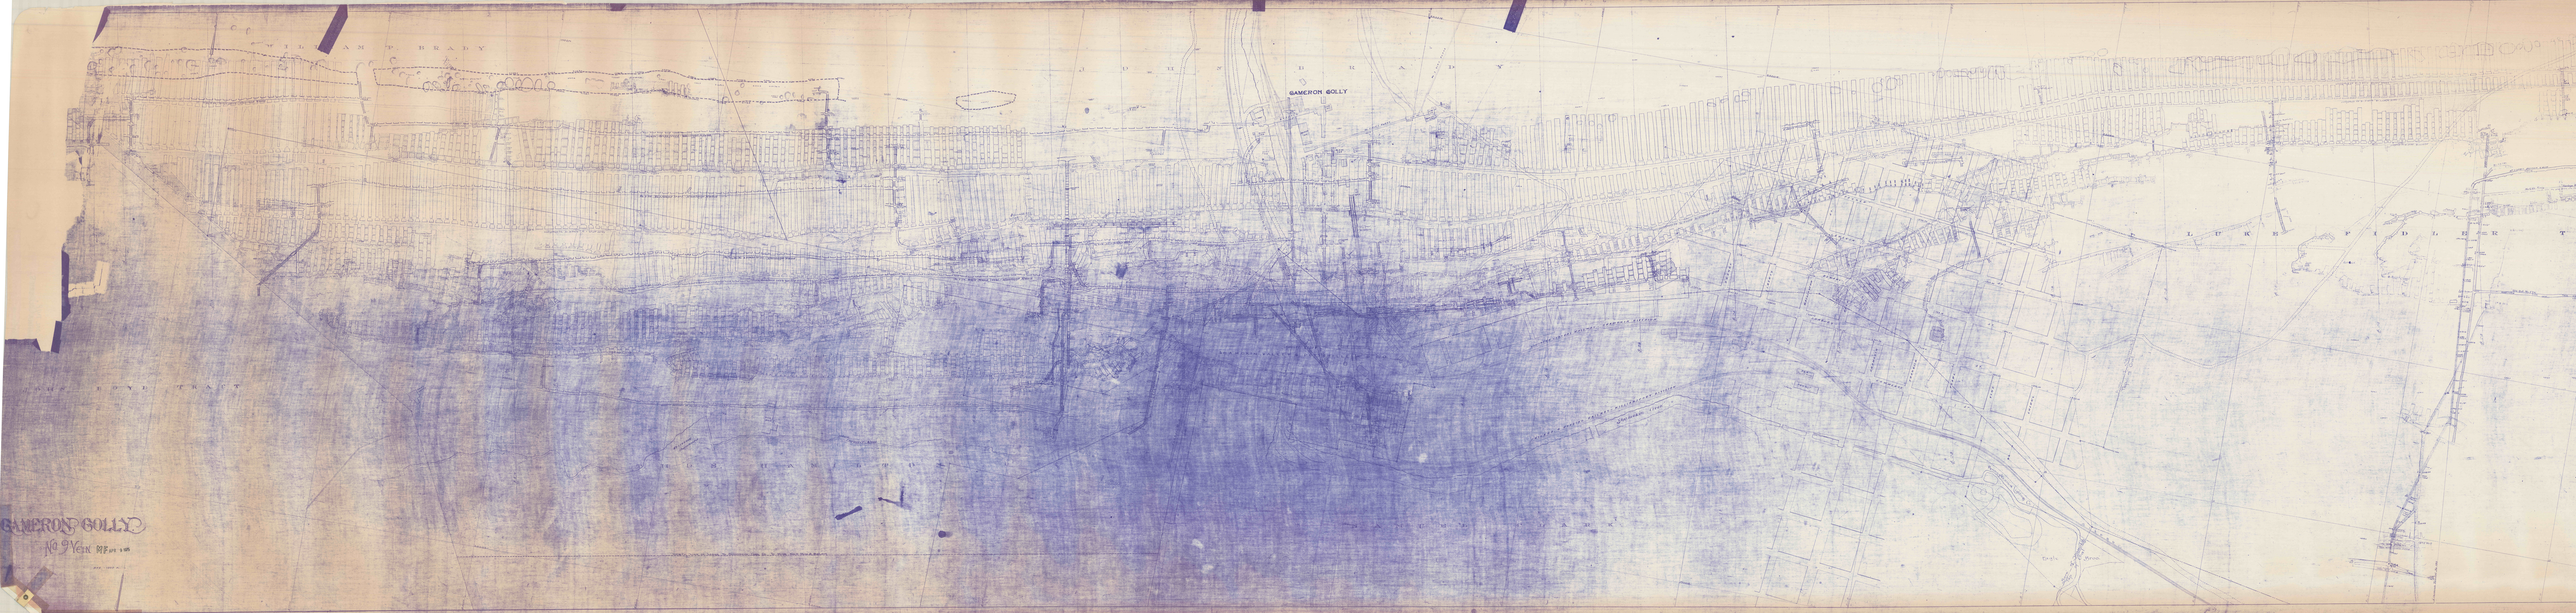
CAMERON GOLLY
GAMERON GOLLY
