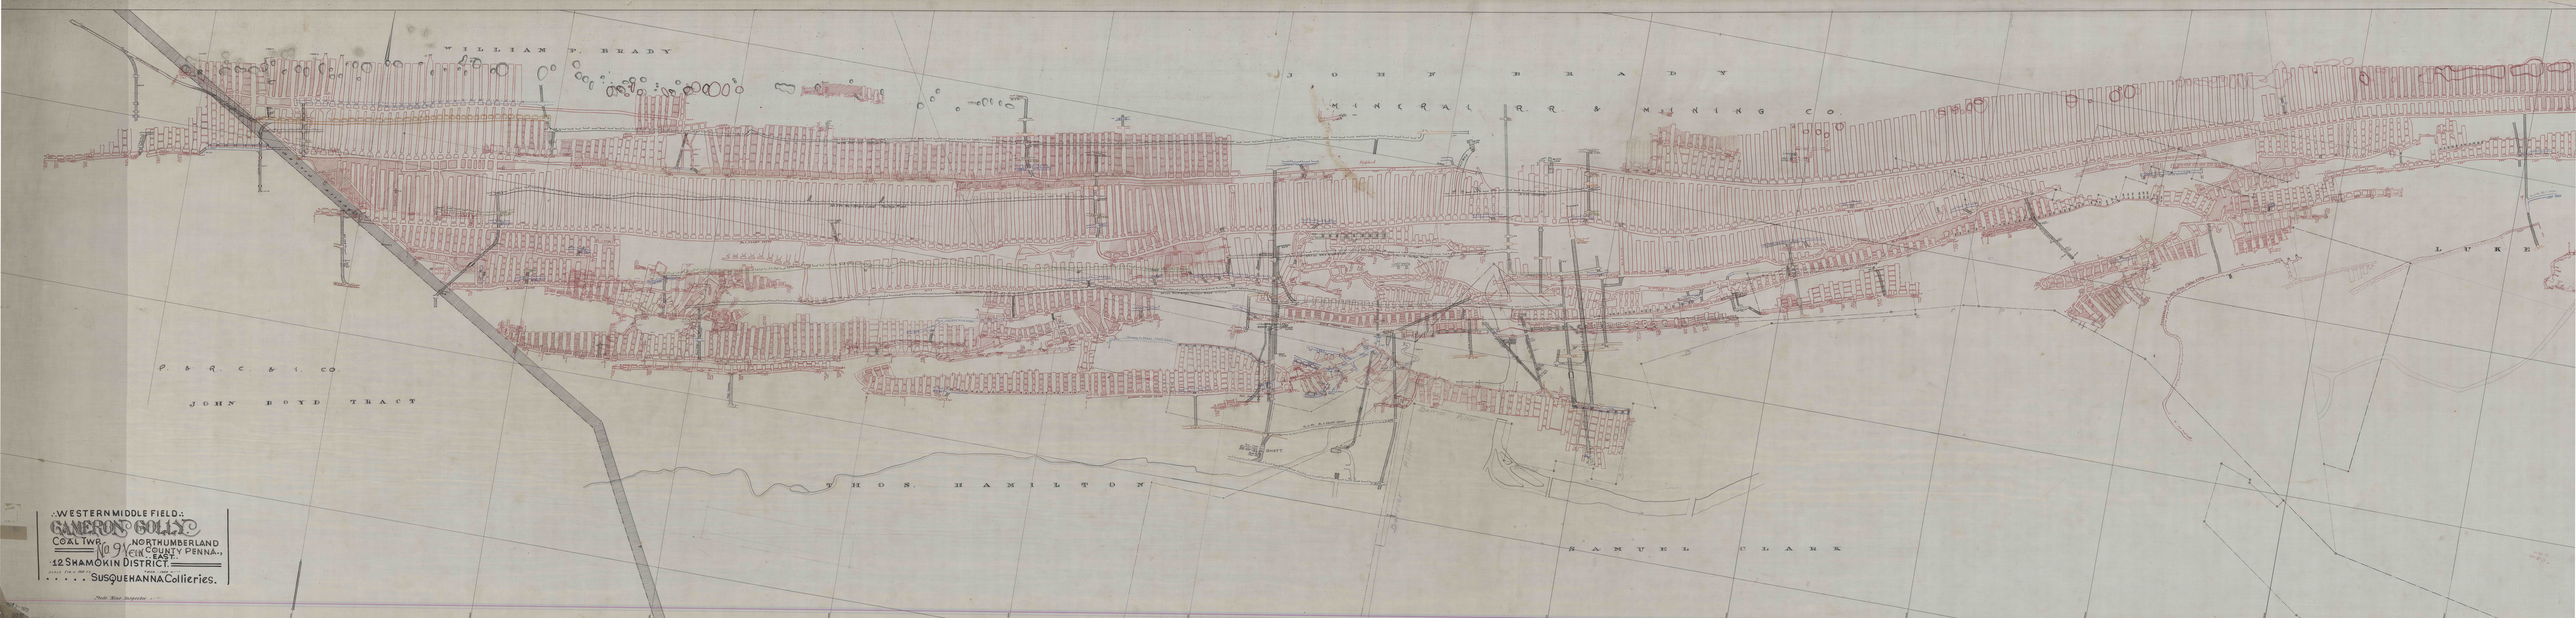

WILLIAM P. BRADY
JOHN BRADY
MINERAL R.R. & MINING CO.
P. & R. C. & I. CO.
JOHN BOYD TRACT
THOS. HAMILTON
SAMUEL CLARK
LUKE
WESTERN MIDDLE FIELD.
CAMERON COLLY
COAL TWP. No 9 VEIN NORTHUMBERLAND COUNTY PENNA.
EAST
12 SHAMOKIN DISTRICT.
SUSQUEHANNA Collieries.