


. WESTERN MIDDLE FIELD..
Glen Burn Colliery.. COAL TWP..
NORTHUMBERLAND COUNTY PA.,
12 SHAMOKIN DISTRICT.
SUSQUEHANNA COLL'RS.


1"=100'.

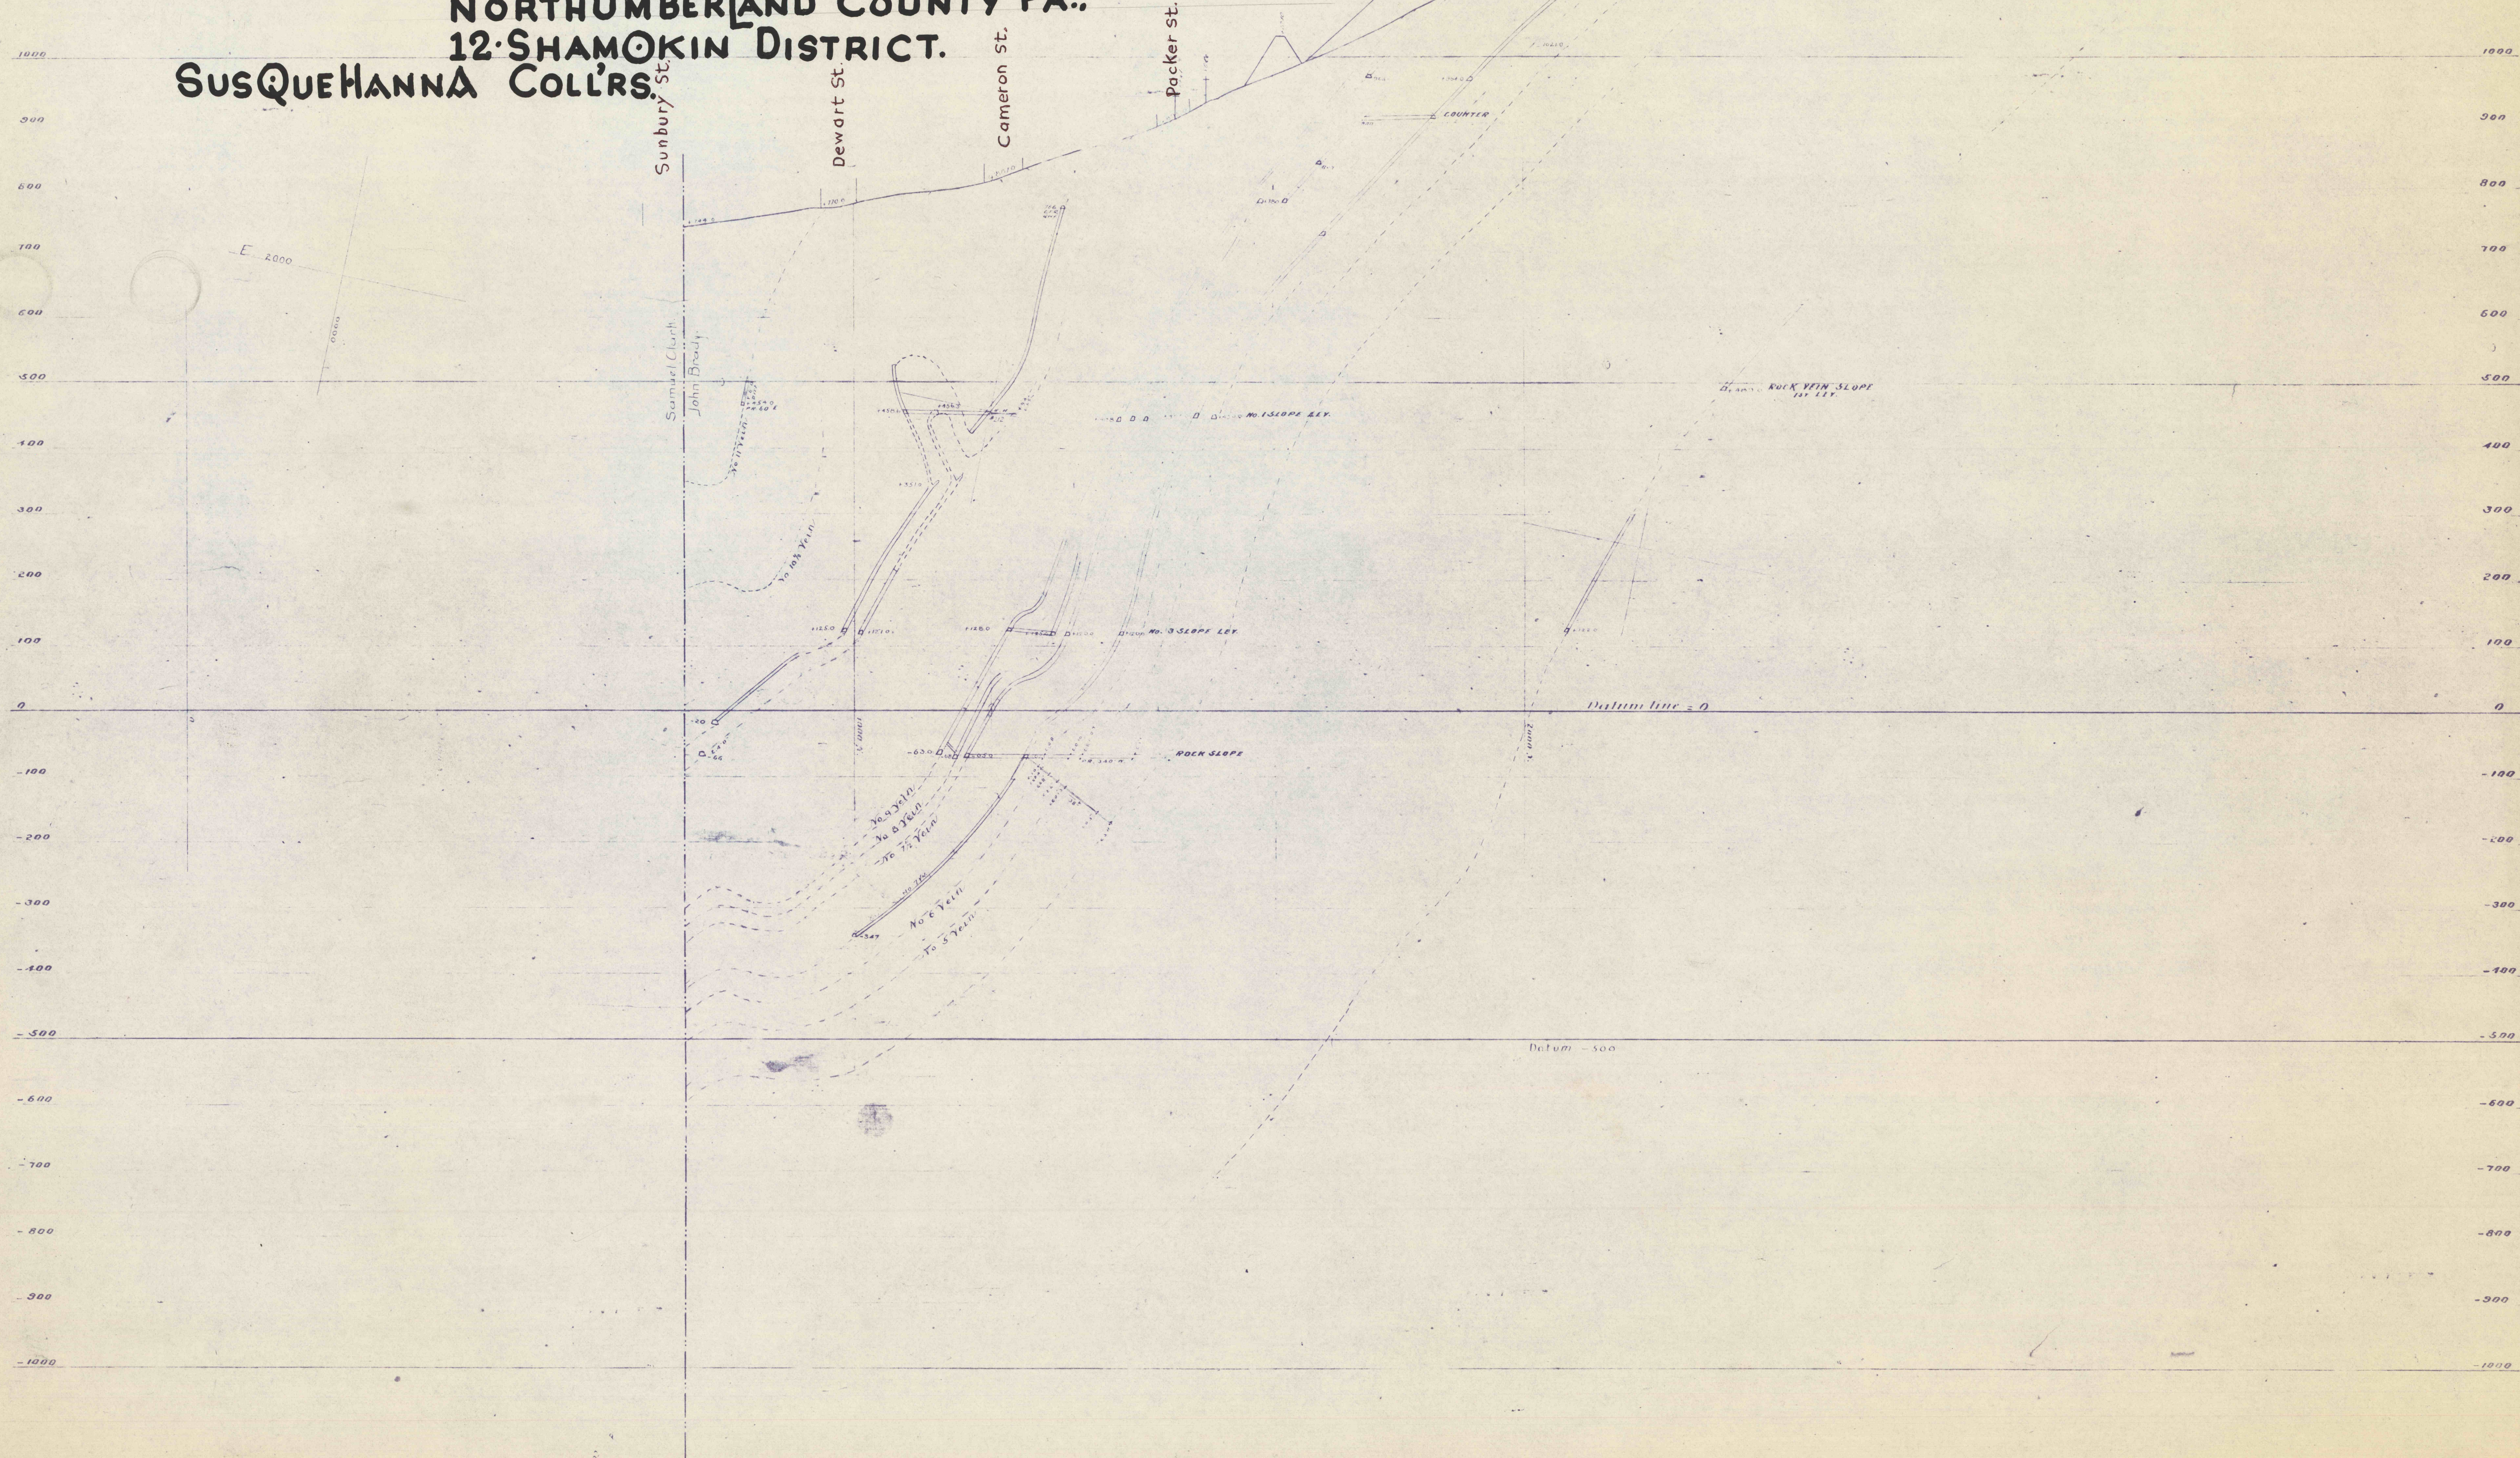

MF

MAR 10 1972

No. 21