


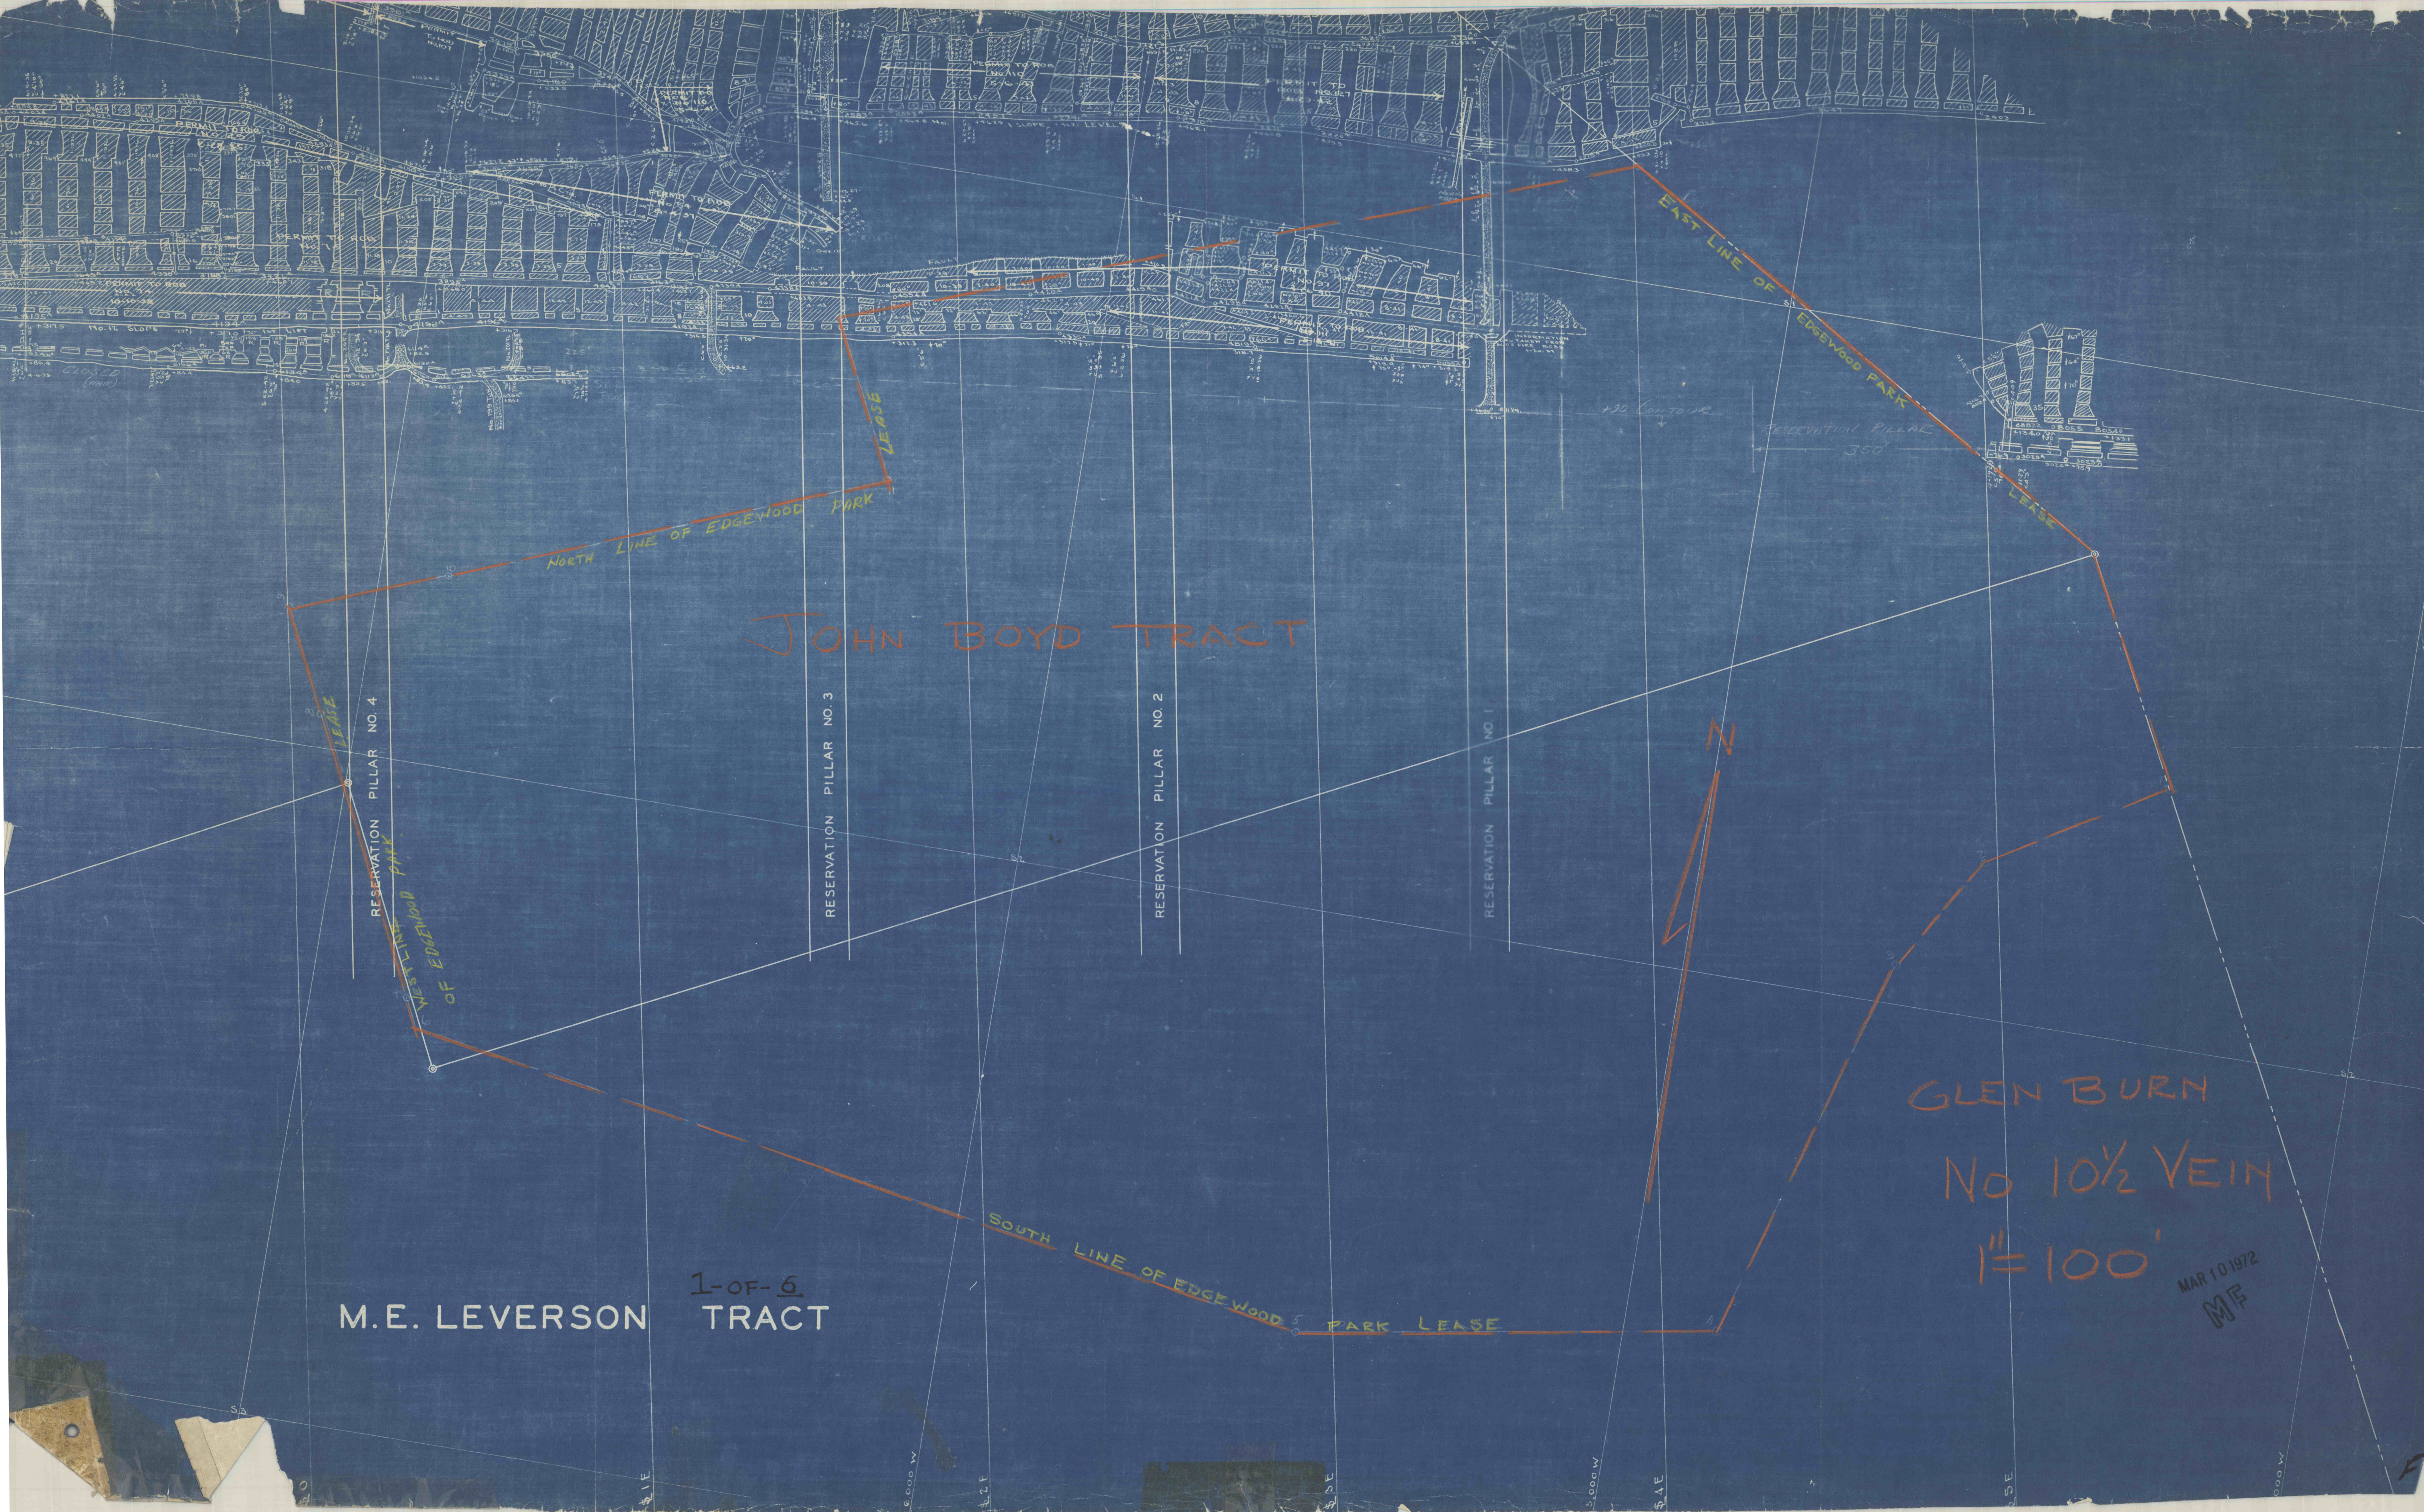

JOHN BOYD TRACT

GLEN BURN
No 10 1/2 VEIN
1" = 100'

M.E. LEVERSON

1-OF-6
TRACT

MAR 10 1972

MP