


..Western Middle Field..Glen BURN COLLIERY.
Coal Twp., Northumberland Co., Pa. *Cameron Coll'y. Section No. 9*
12 SHAMOKIN DISTRICT. SUSQUEHANNA
COLLIERIES. "MF-2 NOV. 1972. A.D."

Wm P. Brady Tract.

Thomas Hamilton Tract.

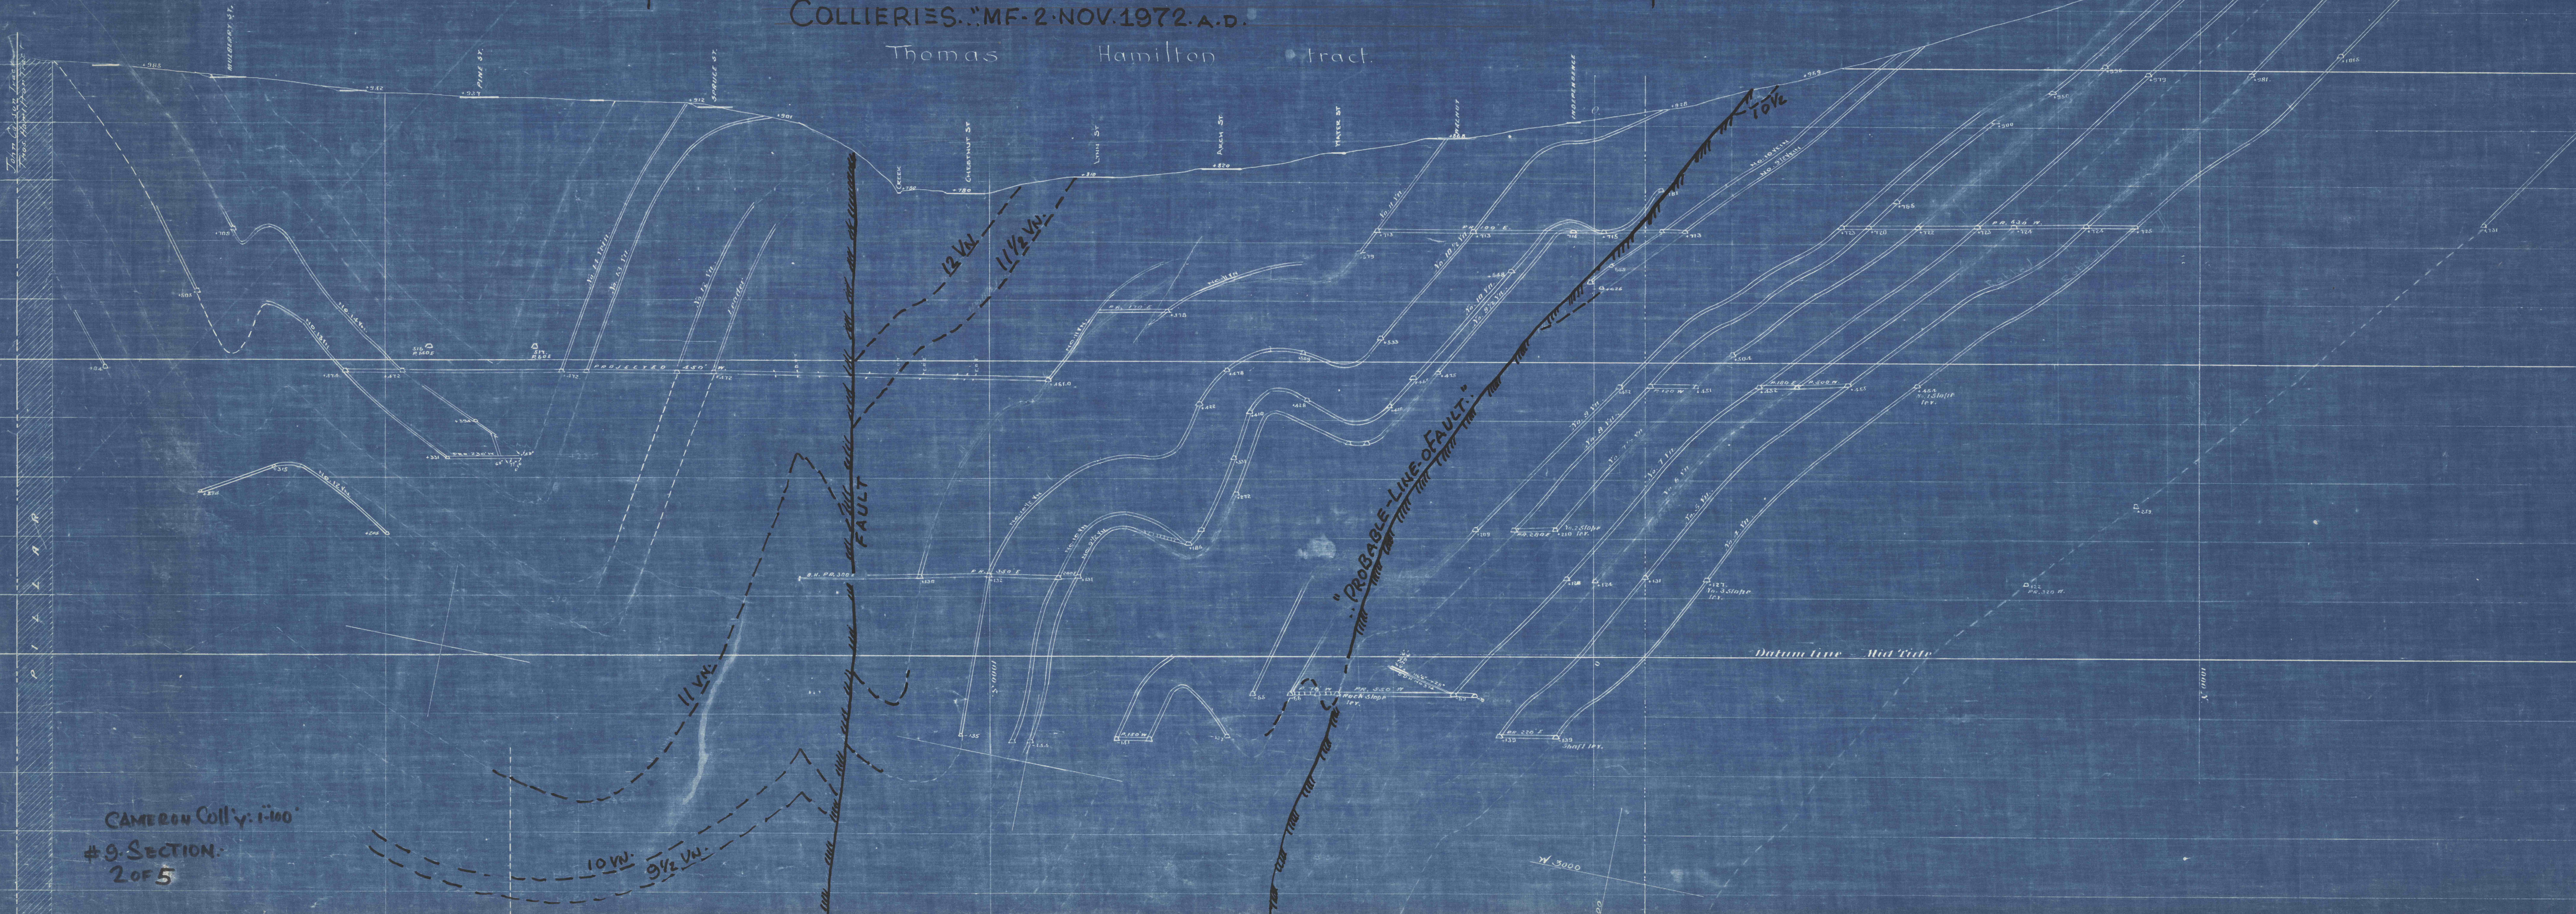

CAMERON Coll'y. 1:100
#9 SECTION:
2 OF 5