


WESTERN MIDDLE FIELD-MT. CARMEL TWP.,
NO. 3 VEIN-NORTHUMBERLAND CO. PA.,
COLONIAL COLLIERIES COMPANY
GREENOUGH COLLIERY

BARRIER PILLAR

BARRIER PILLAR

BARRIER PILLAR

BARRIER PILLAR

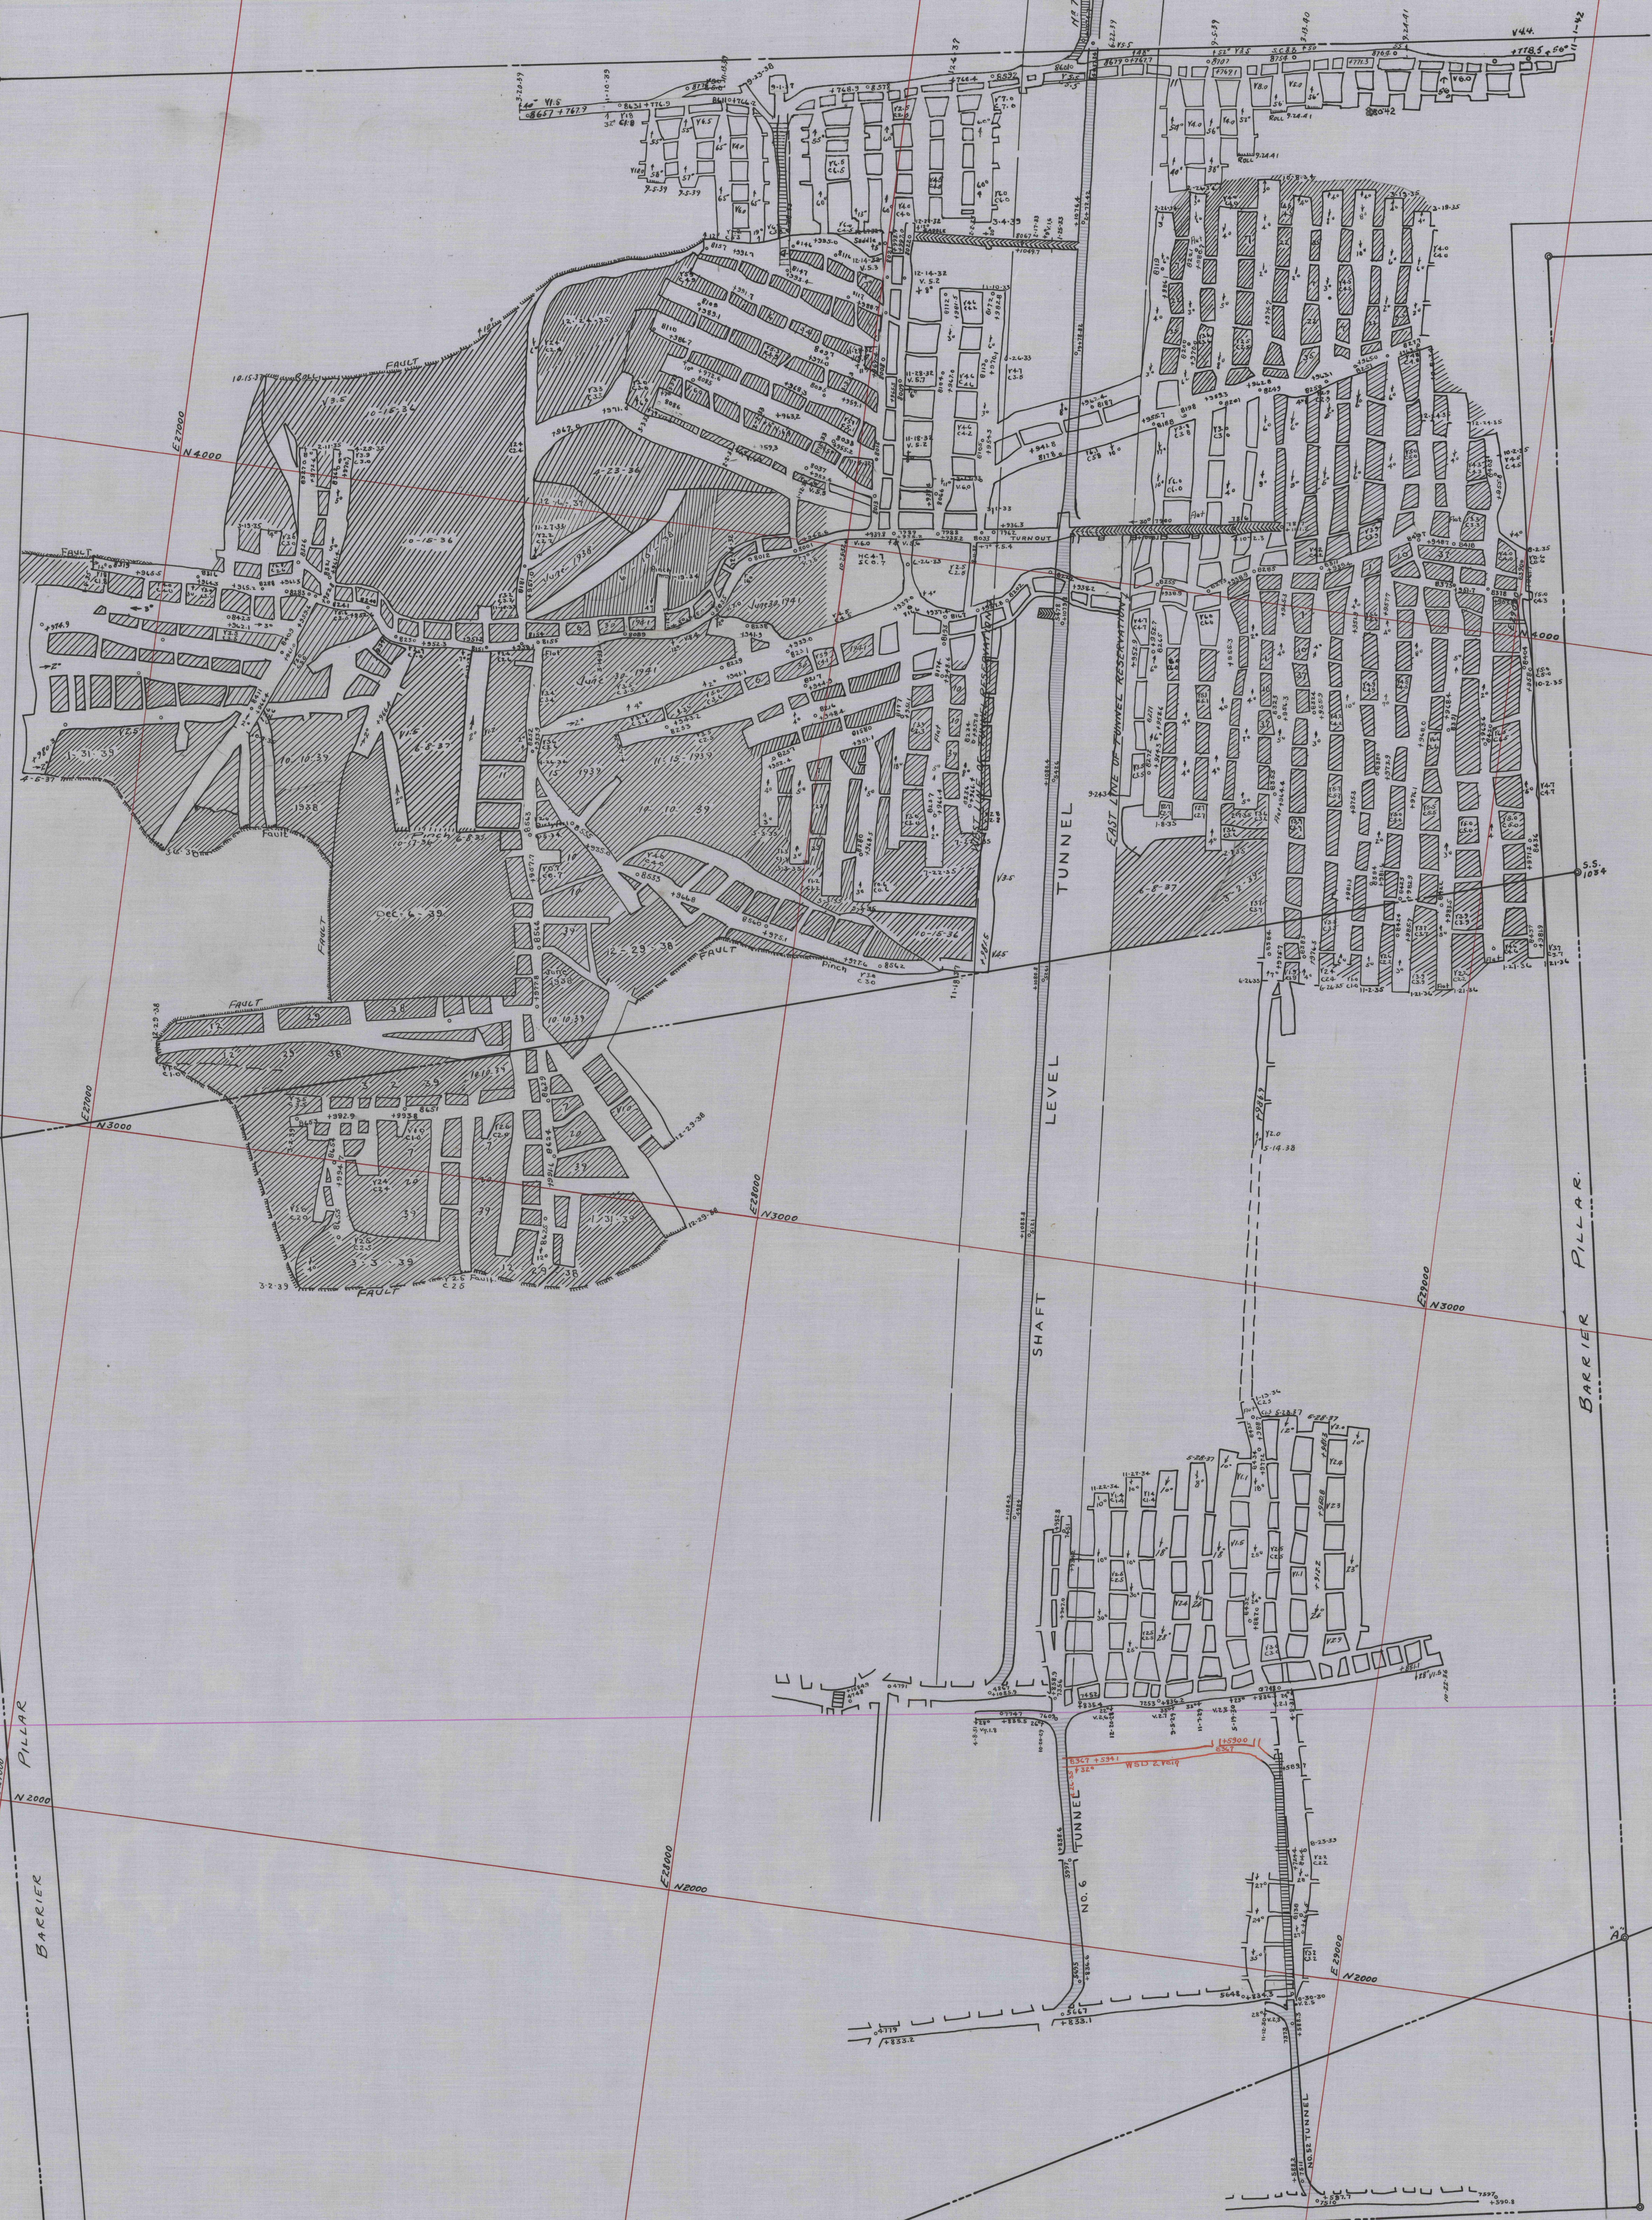

WESTERN MIDDLE FIELD-MT. CARMEL TWP.,
NO. 3 VEIN-NORTHUMBERLAND CO. PA.,
COLONIAL COLLIERIES COMPANY
GREENOUGH COLLIERY
.. SCALE: 1"=100 FT. . . 4-13-1933. .
Posted: to Nov. 16, 1943. MINE INSPECTOR'S

Post - 270
11-16-43

MAR 10 1943