


WESTERN MIDDLE FIELD.. GLEN BURN COLLIERY..

Cameron Colly. Section No. 19
1"=100'

12-SHAMOKIN DISTRICT, SUSQUEHANNA COLLIERIES CO.

MAR 10 1972 MF

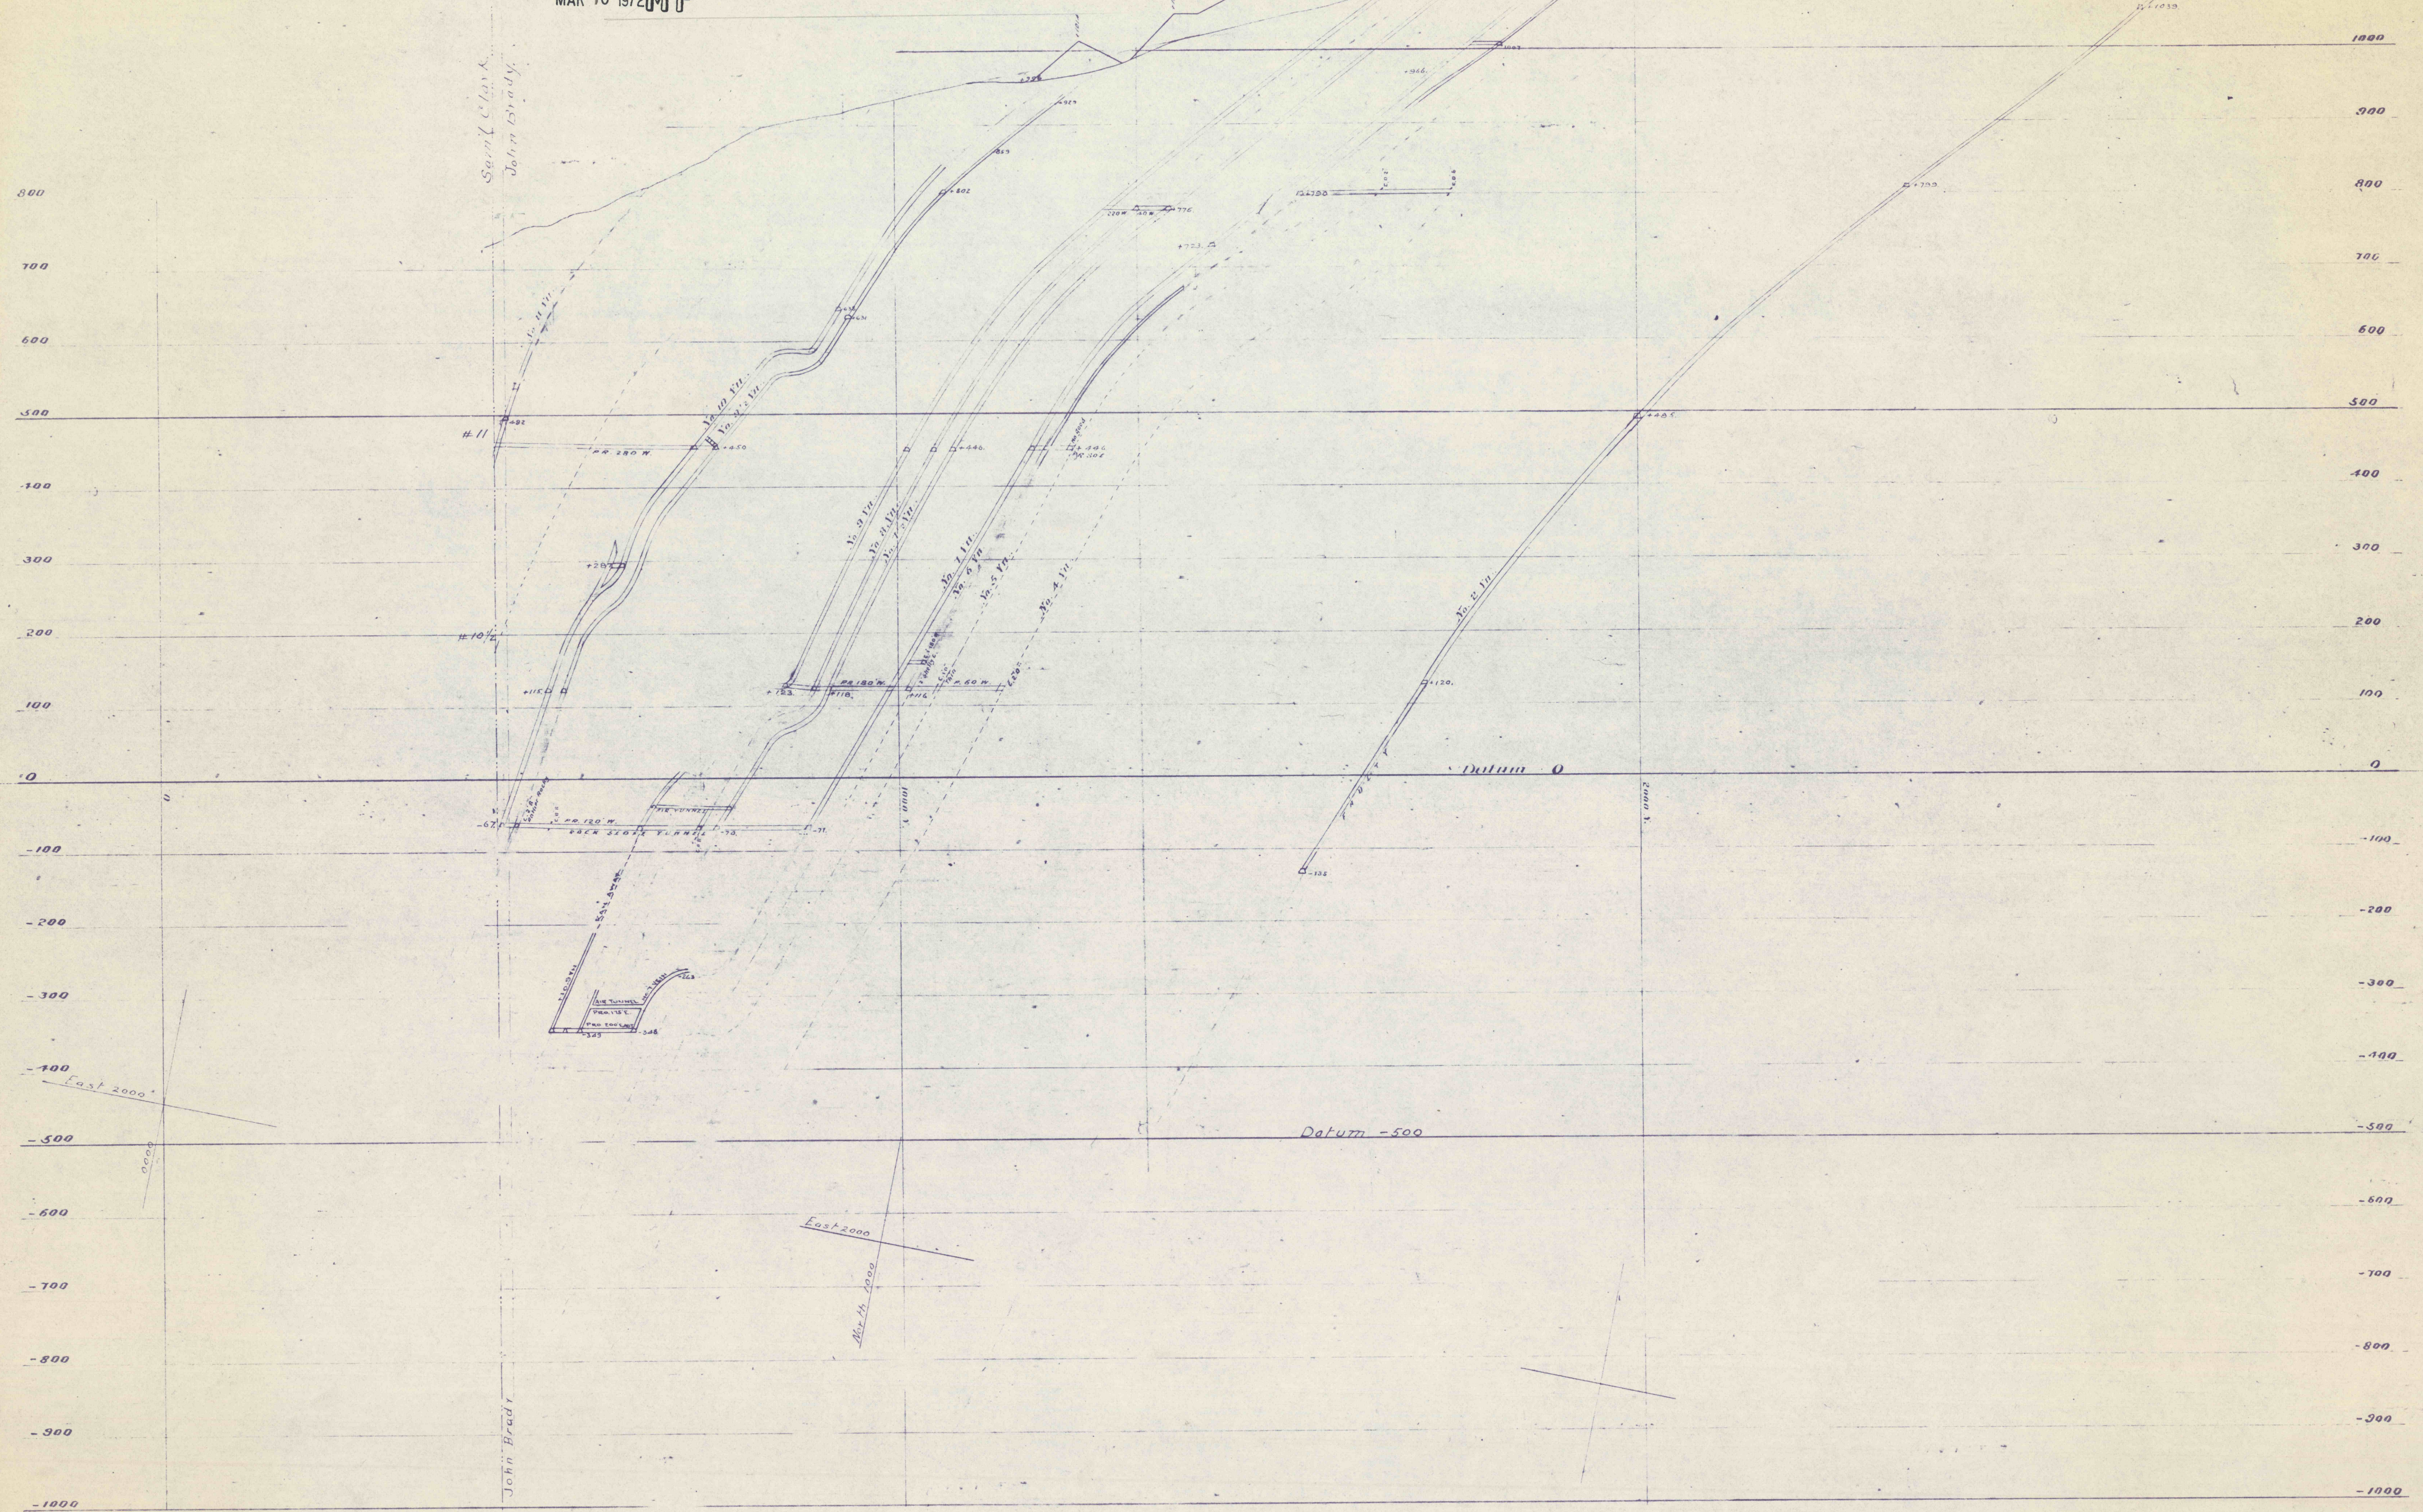

MAR 10 1972 MF

No. 19

No. 19