


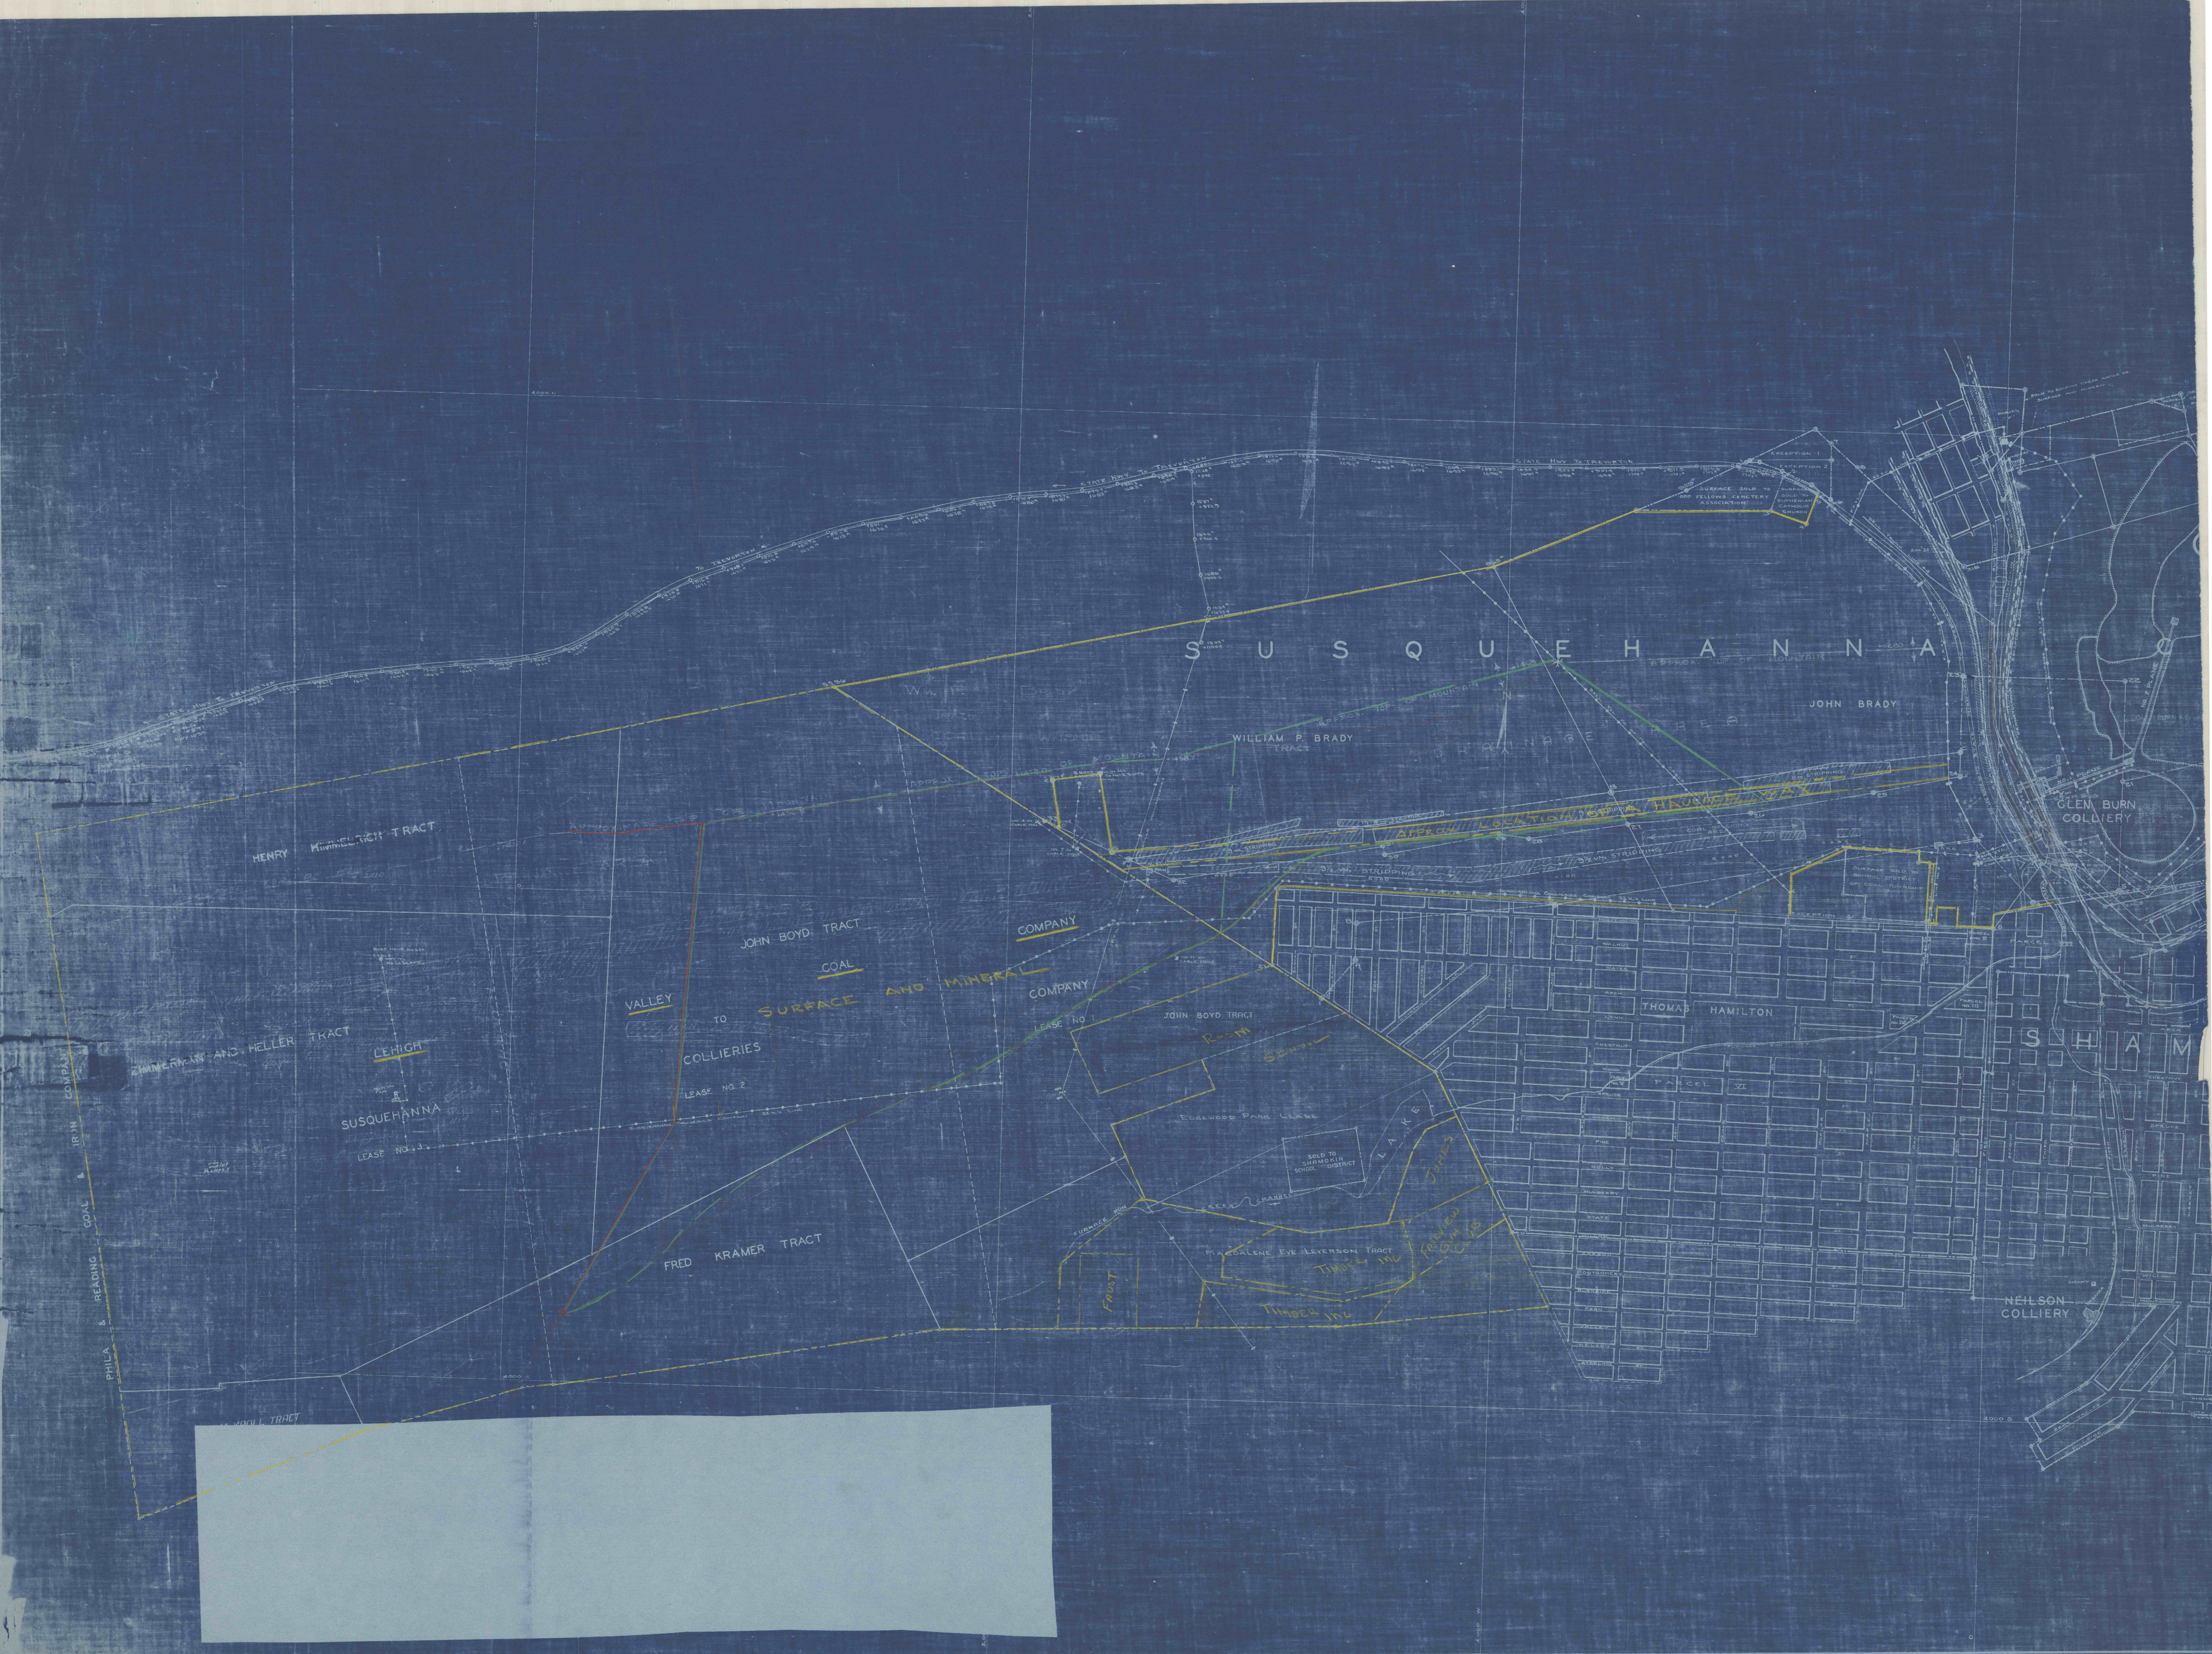

S U S Q U E H A N N A

HENRY HIMMELRICH TRACT

JOHN BOYD TRACT

WILLIAM P. BRADY TRACT

JOHN BRADY

GLEN BURN COLLIERY

LEHIGH

SUSQUEHANNA

VALLEY

COAL

COLLIERIES

FRED KRAMER TRACT

COMPANY

COMPANY

JOHN BOYD TRACT

EDGEWOOD PARK LEASE

MADELENE EYE LEVERSON TRACT

THOMAS HAMILTON

NEILSON COLLIERY

S H A M

PHILA & READING COAL & IRON COMPANY

