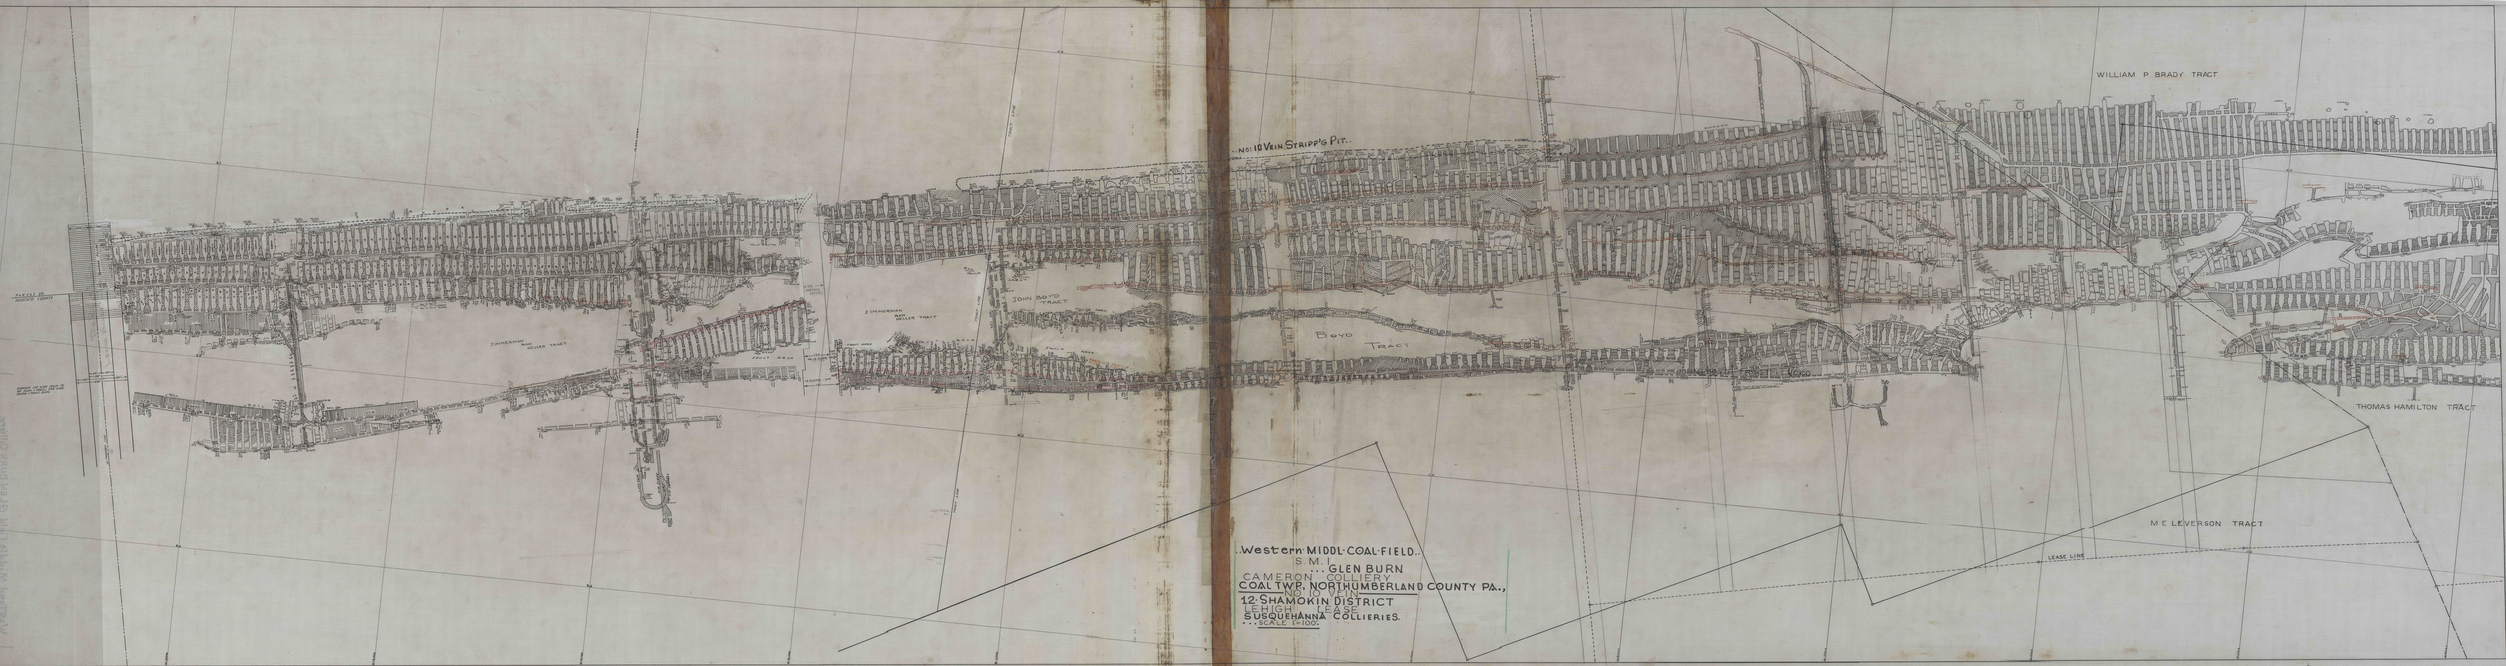

No. 10 Vein Stripp's Pit.
WILLIAM P BRADY TRACT
THOMAS HAMILTON TRACT
M E LEVERSON TRACT
LEASE LINE
Western MIDDL COAL FIELD.
S. M. I.
CAMERON COLLIERY
GLEN BURN
COAL TWP. NORTHUMBERLAND COUNTY PA.,
12 SHAMOKIN DISTRICT
LEHIGH LEASE
SUSQUEHANNA COLLIERIES.
SCALE 1100