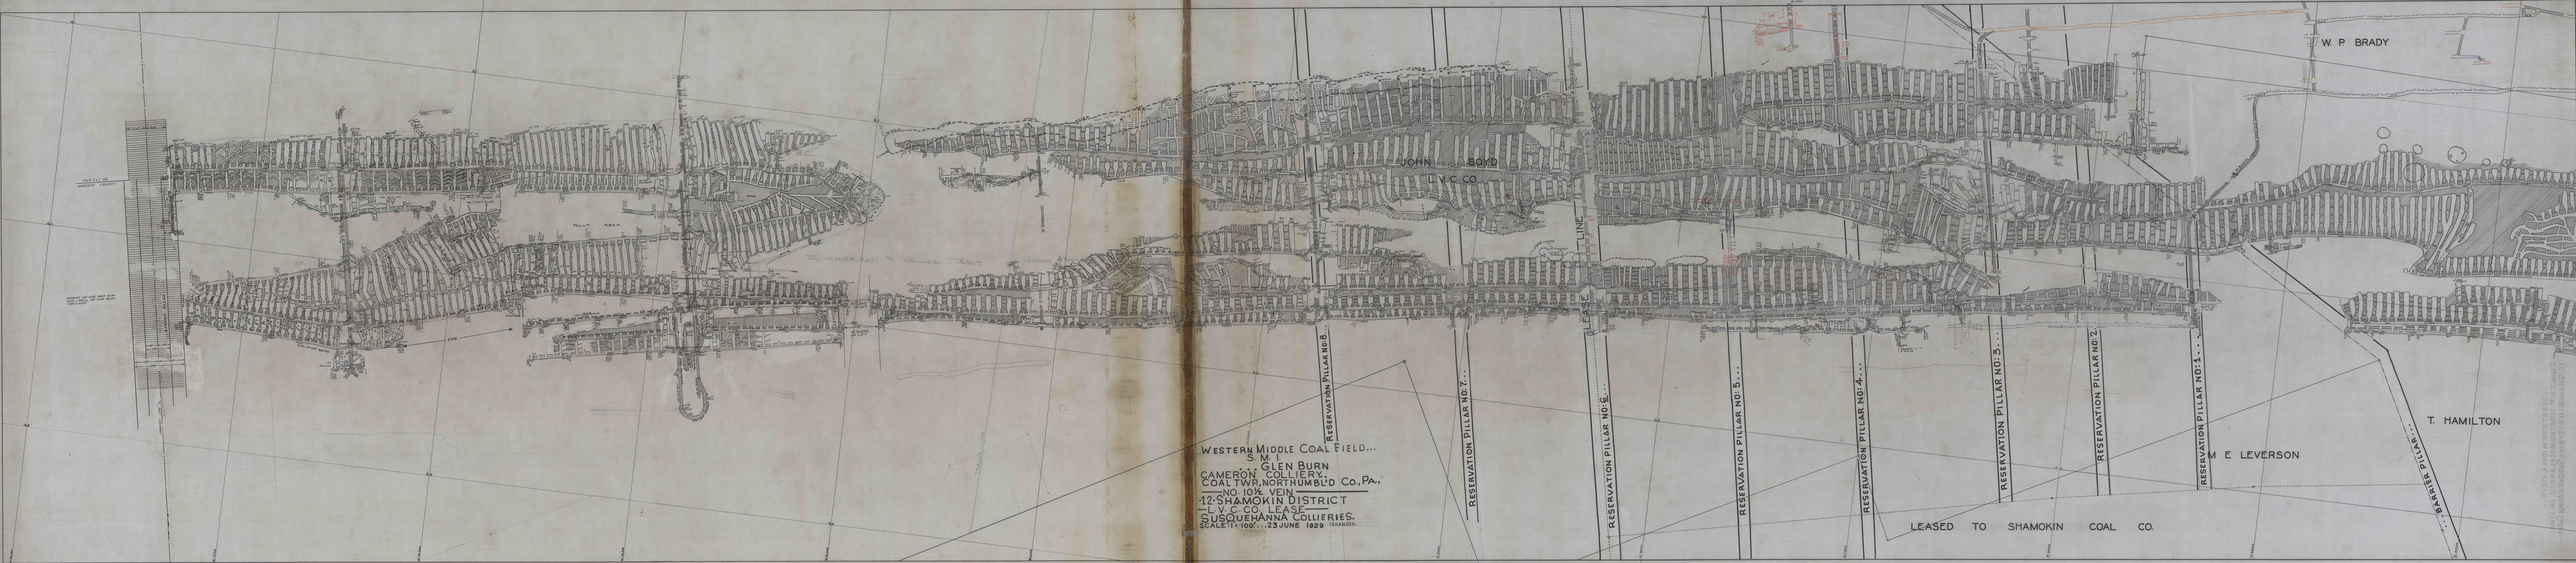

JOHN BOYD
L.V.C. CO.
W. P. BRADY
T. HAMILTON
M. E. LEVERSON
LEASED TO SHAMOKIN COAL CO.
RESERVATION PILLAR NO. 8...
RESERVATION PILLAR NO. 7...
RESERVATION PILLAR NO. 6...
RESERVATION PILLAR NO. 5...
RESERVATION PILLAR NO. 4...
RESERVATION PILLAR NO. 3...
RESERVATION PILLAR NO. 2
RESERVATION PILLAR NO. 1...
BARRIER PILLAR...
LEASE LINE
WESTERN MIDDLE COAL FIELD...
S. M. I.
GLEN BURN
CAMERON COLLIERY.
COAL TWP. NORTHUMB'D CO., PA.,
NO. 10¼ VEIN
12 SHAMOKIN DISTRICT
L.V.C. CO. LEASE
SUSQUEHANNA COLLIERIES.
SCALE 1 = 100'... 23 JUNE 1928 DRAWER.