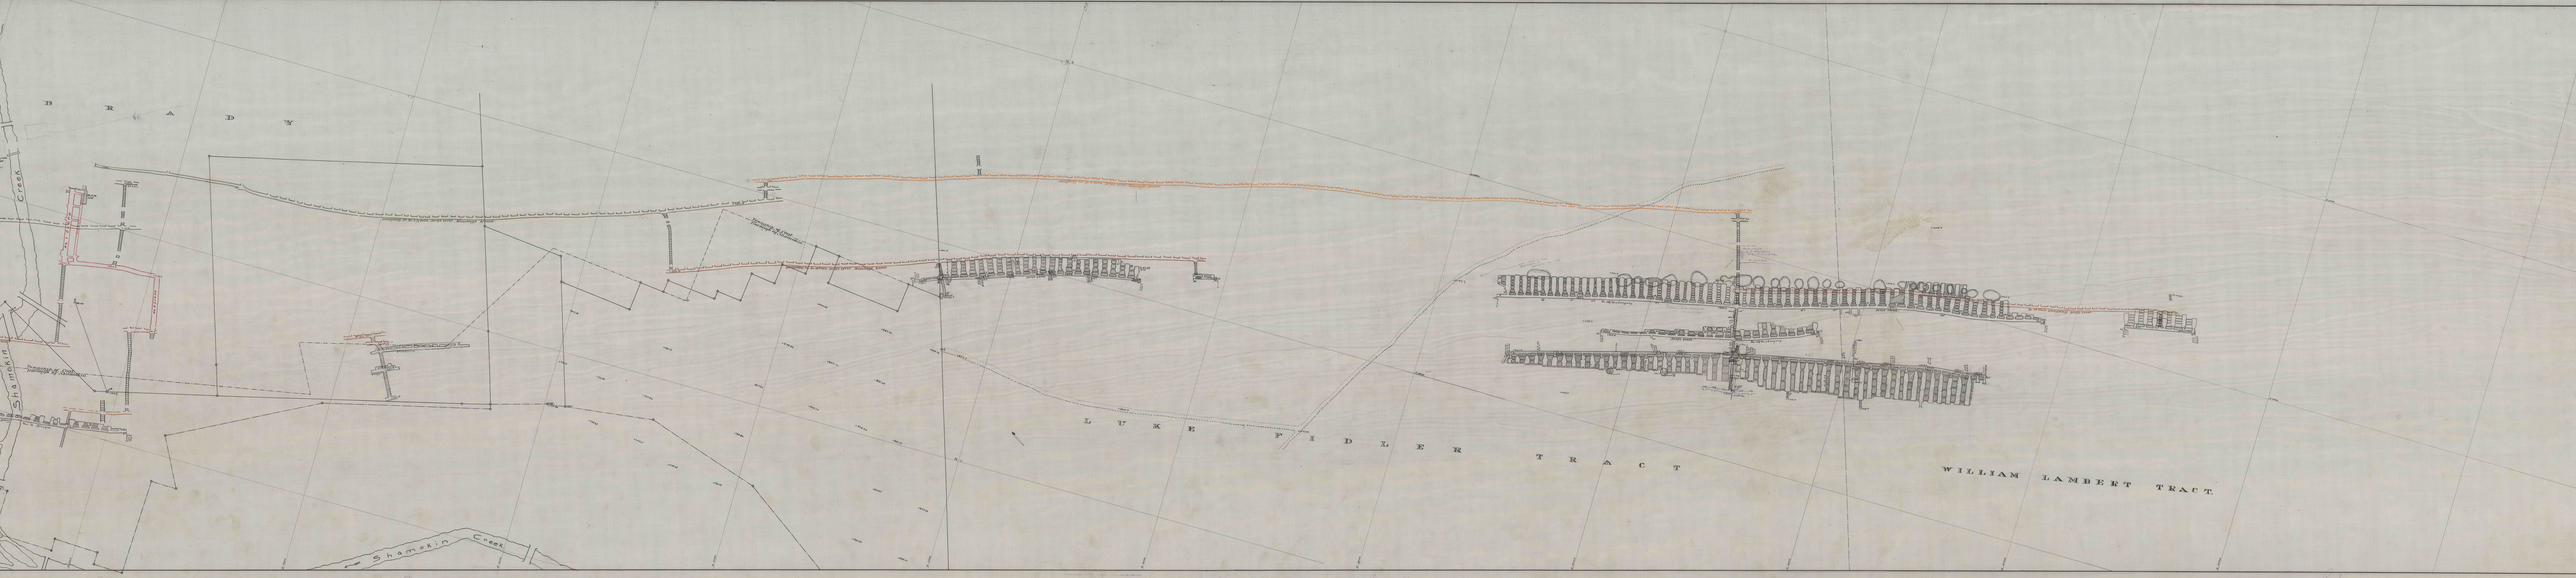

B R A D Y
Creek
Shamokin
Shamokin Creek
L U K E F I D L E R T R A C T
WILLIAM LAMBERT TRACT