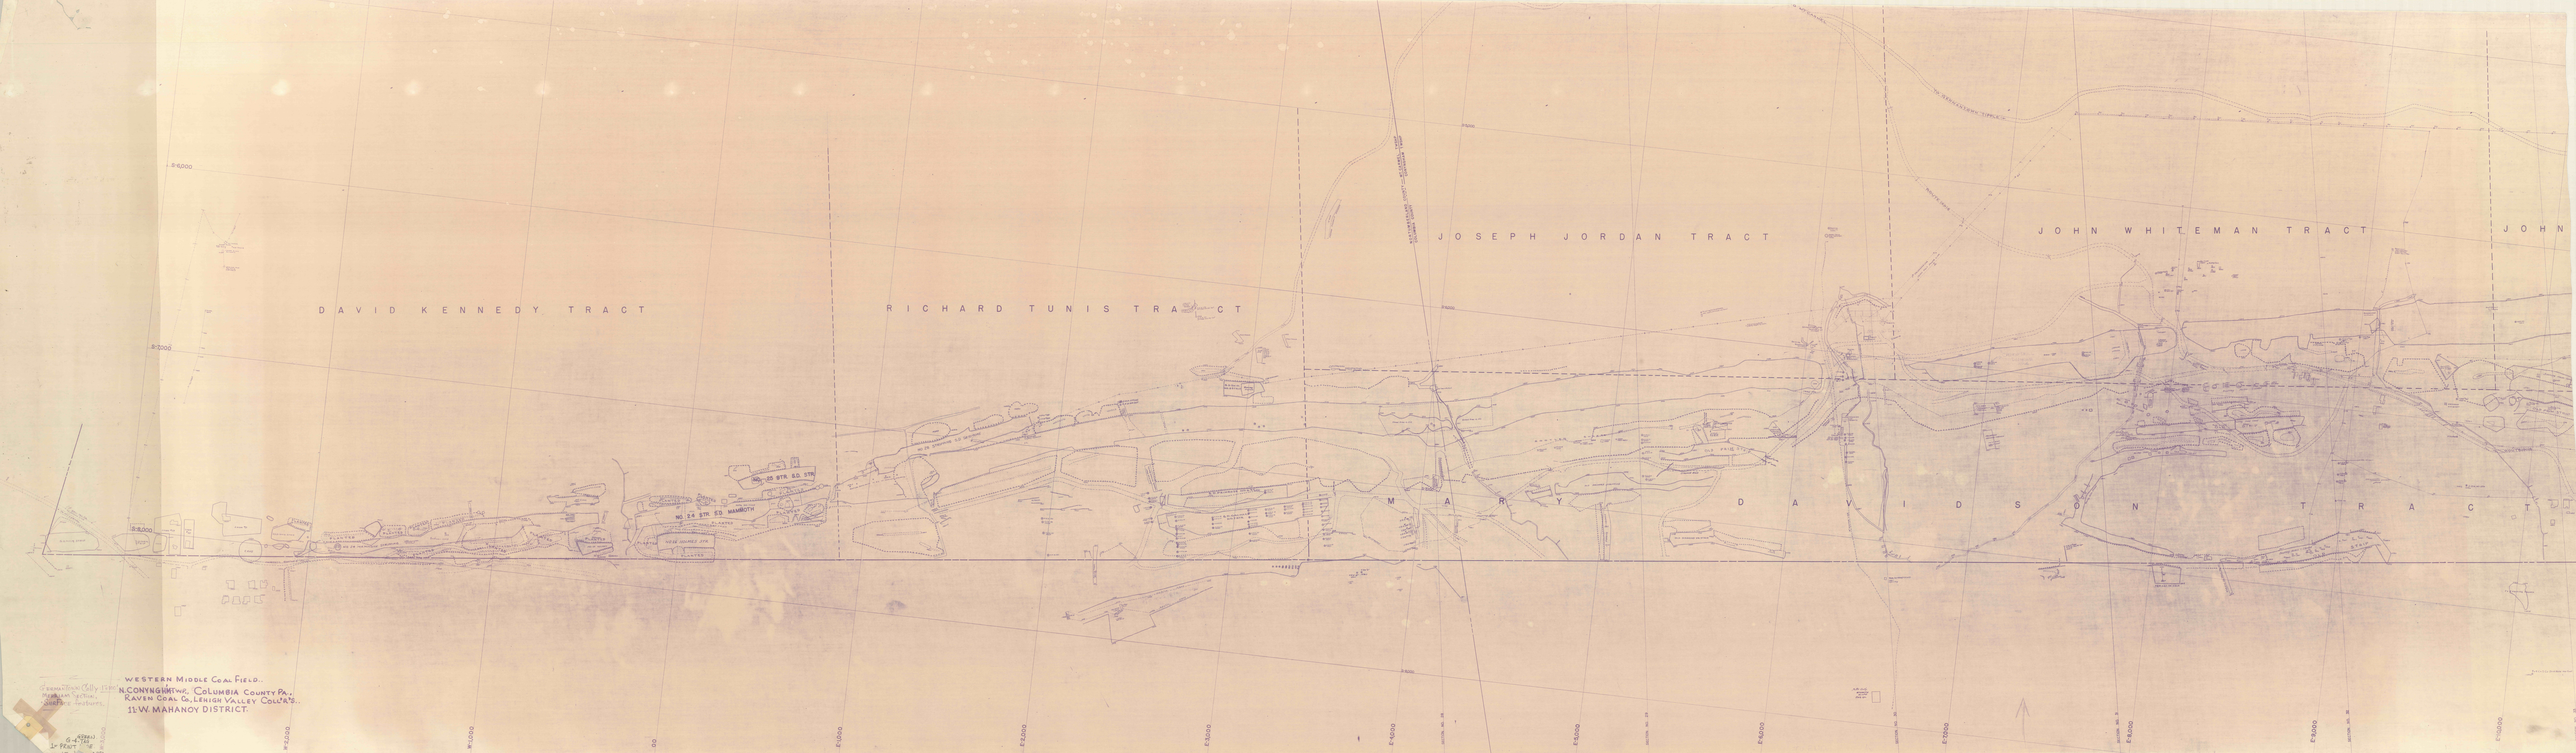

WESTERN MIDDLE COAL FIELD.
N. CONYNGHAM TWP. COLUMBIA COUNTY PA.
RAVEN COAL CO. LEHIGH VALLEY COAL CO.
11 W. MAHANOY DISTRICT.