


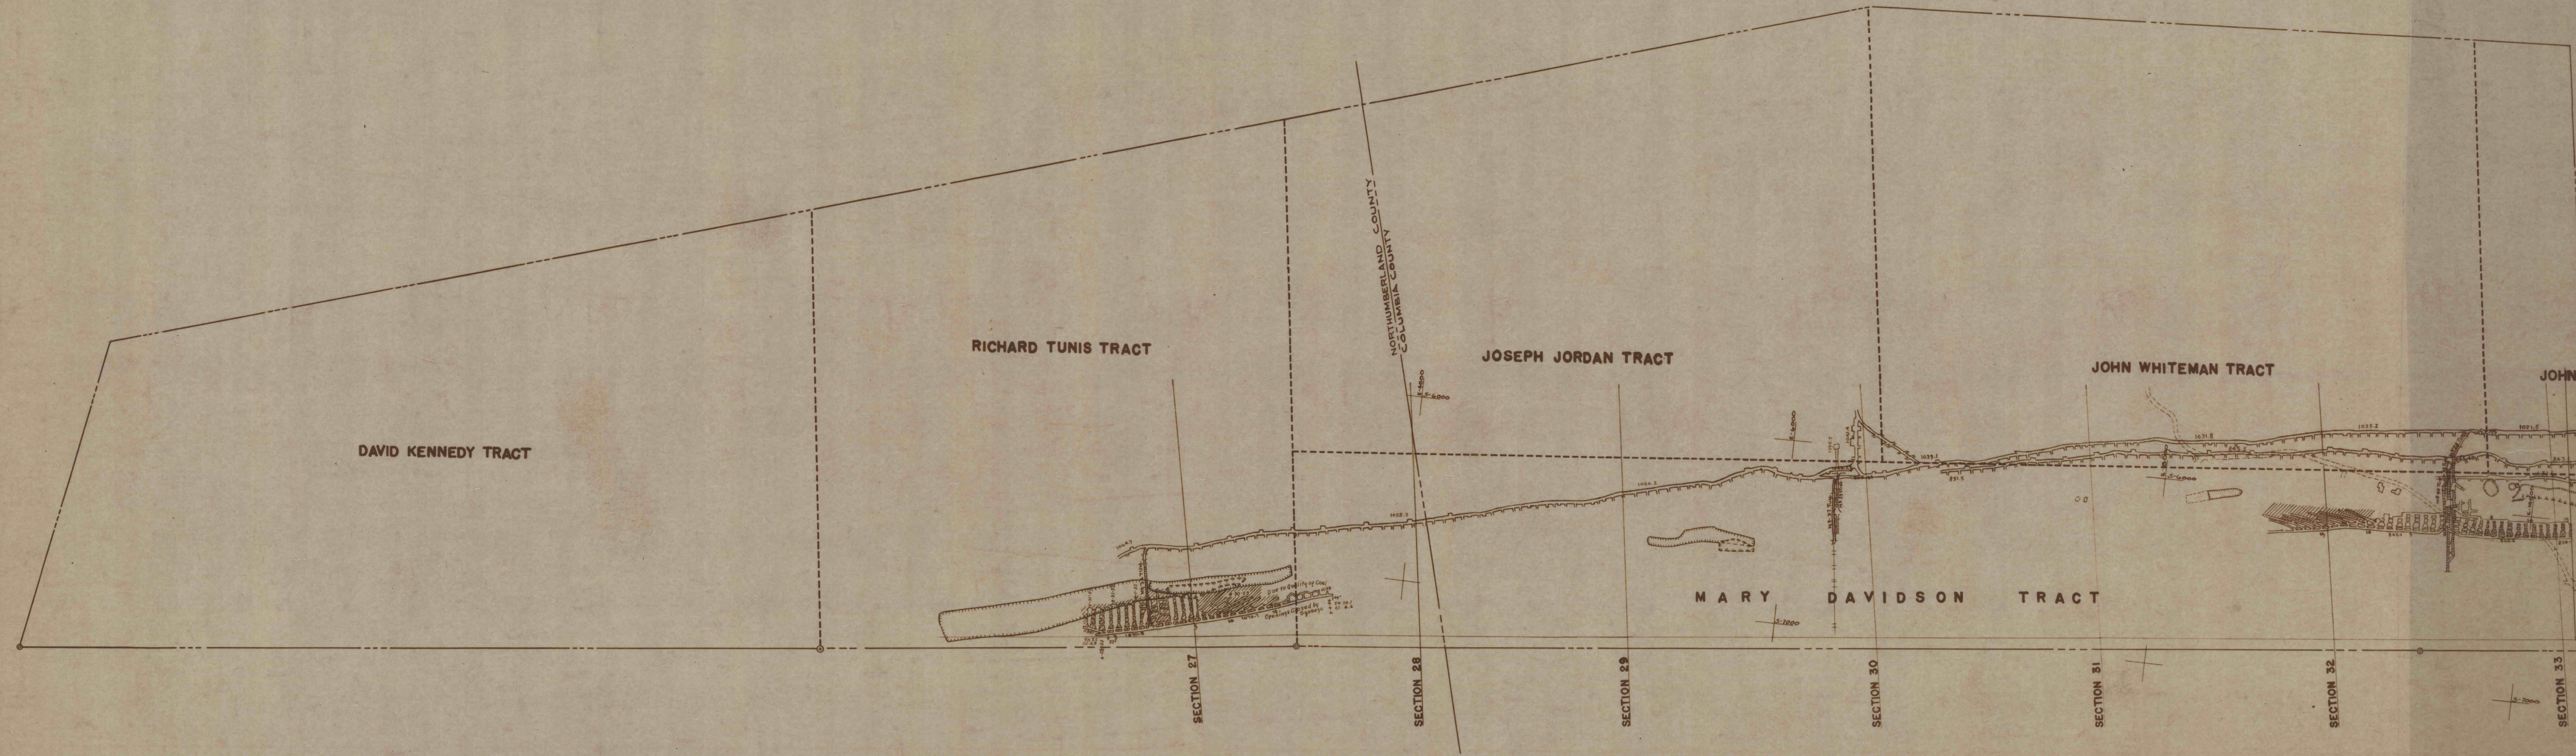

..Western Middle Coal Field..
NORTH CONYNGHAM TOWNSHIP..
COLUMIA COUNTY PA.,
11-W. MAHANAY DISTRICT. LEHIGH
RAVEN RUN COAL CO. VALLEY
GERMANTOWN MINE COLLIERIES.
MERRIAM SECTION
PRIMROSE, T.S. VEIN.
SCALE 1"=400' 4-30-81

GREEN TAC
G-1