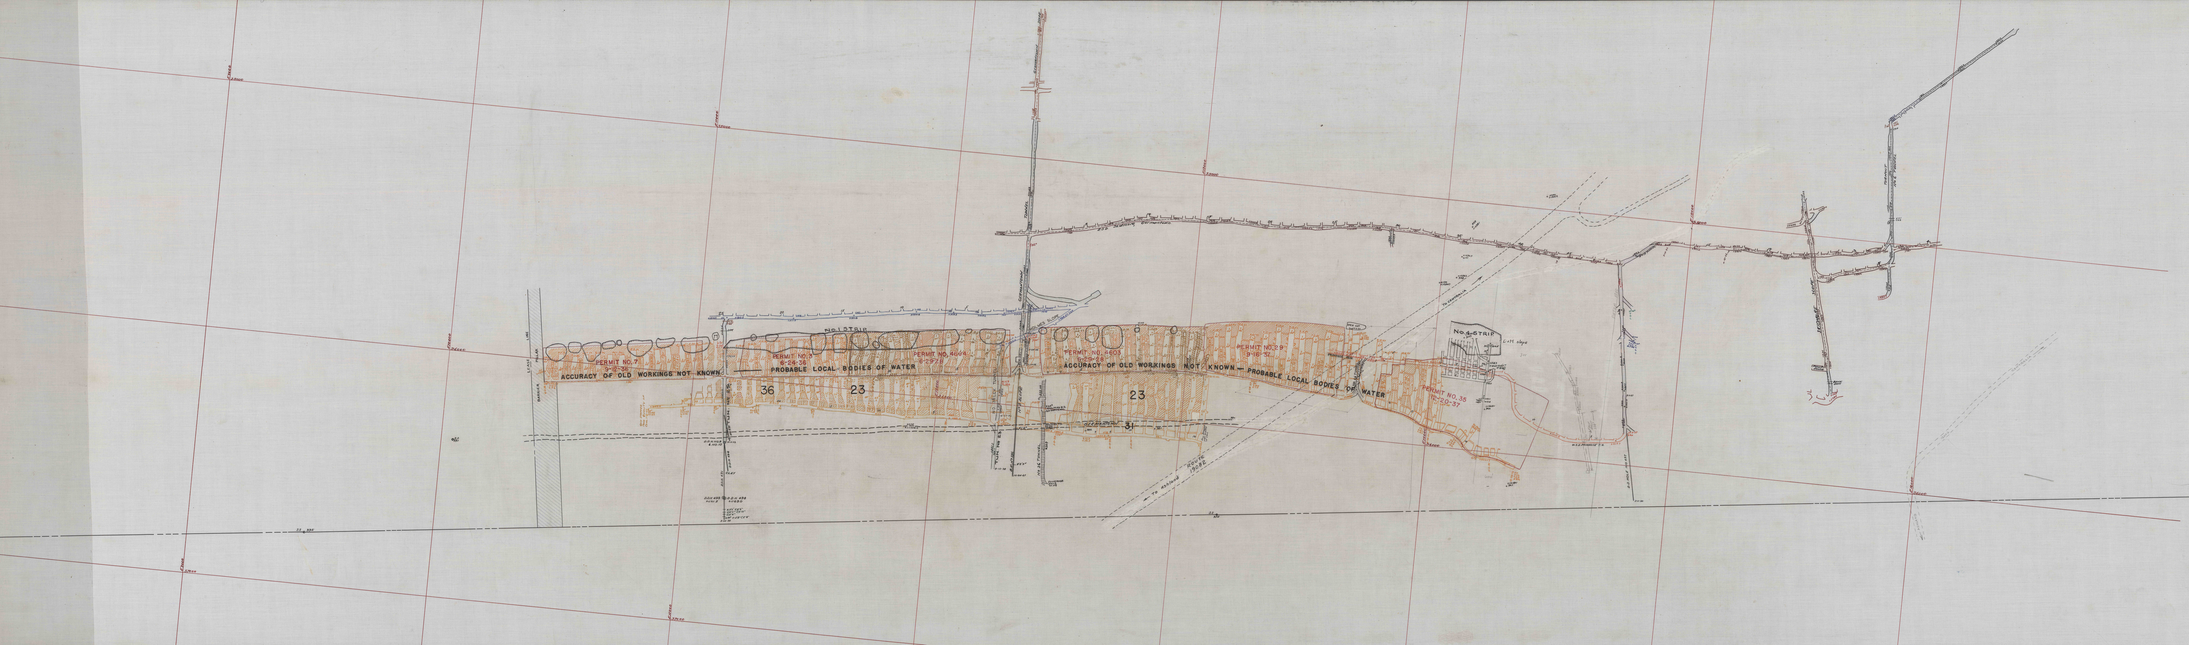

...WESTERN MIDDLE COAL FIELD...

NORTH CONYNGHAM Twp., ORCHARD VEIN COLUMBIA COUNTY PENNA.,

GERMANTOWN &

LOCUST RUN COLLIERY

OF THE

11-WEST MAHANOY DISTRICT.

Lehigh Valley Coal Company

ENGINEERING DEPARTMENT L.V.C.Co. LOCUST MOUNTAIN DIVISION

60 Ft = 1"

Mined to 1-1-1938

Drafted 1-15-1938

Revised 2-25-38 Rec.

3-9-38

3-31-38