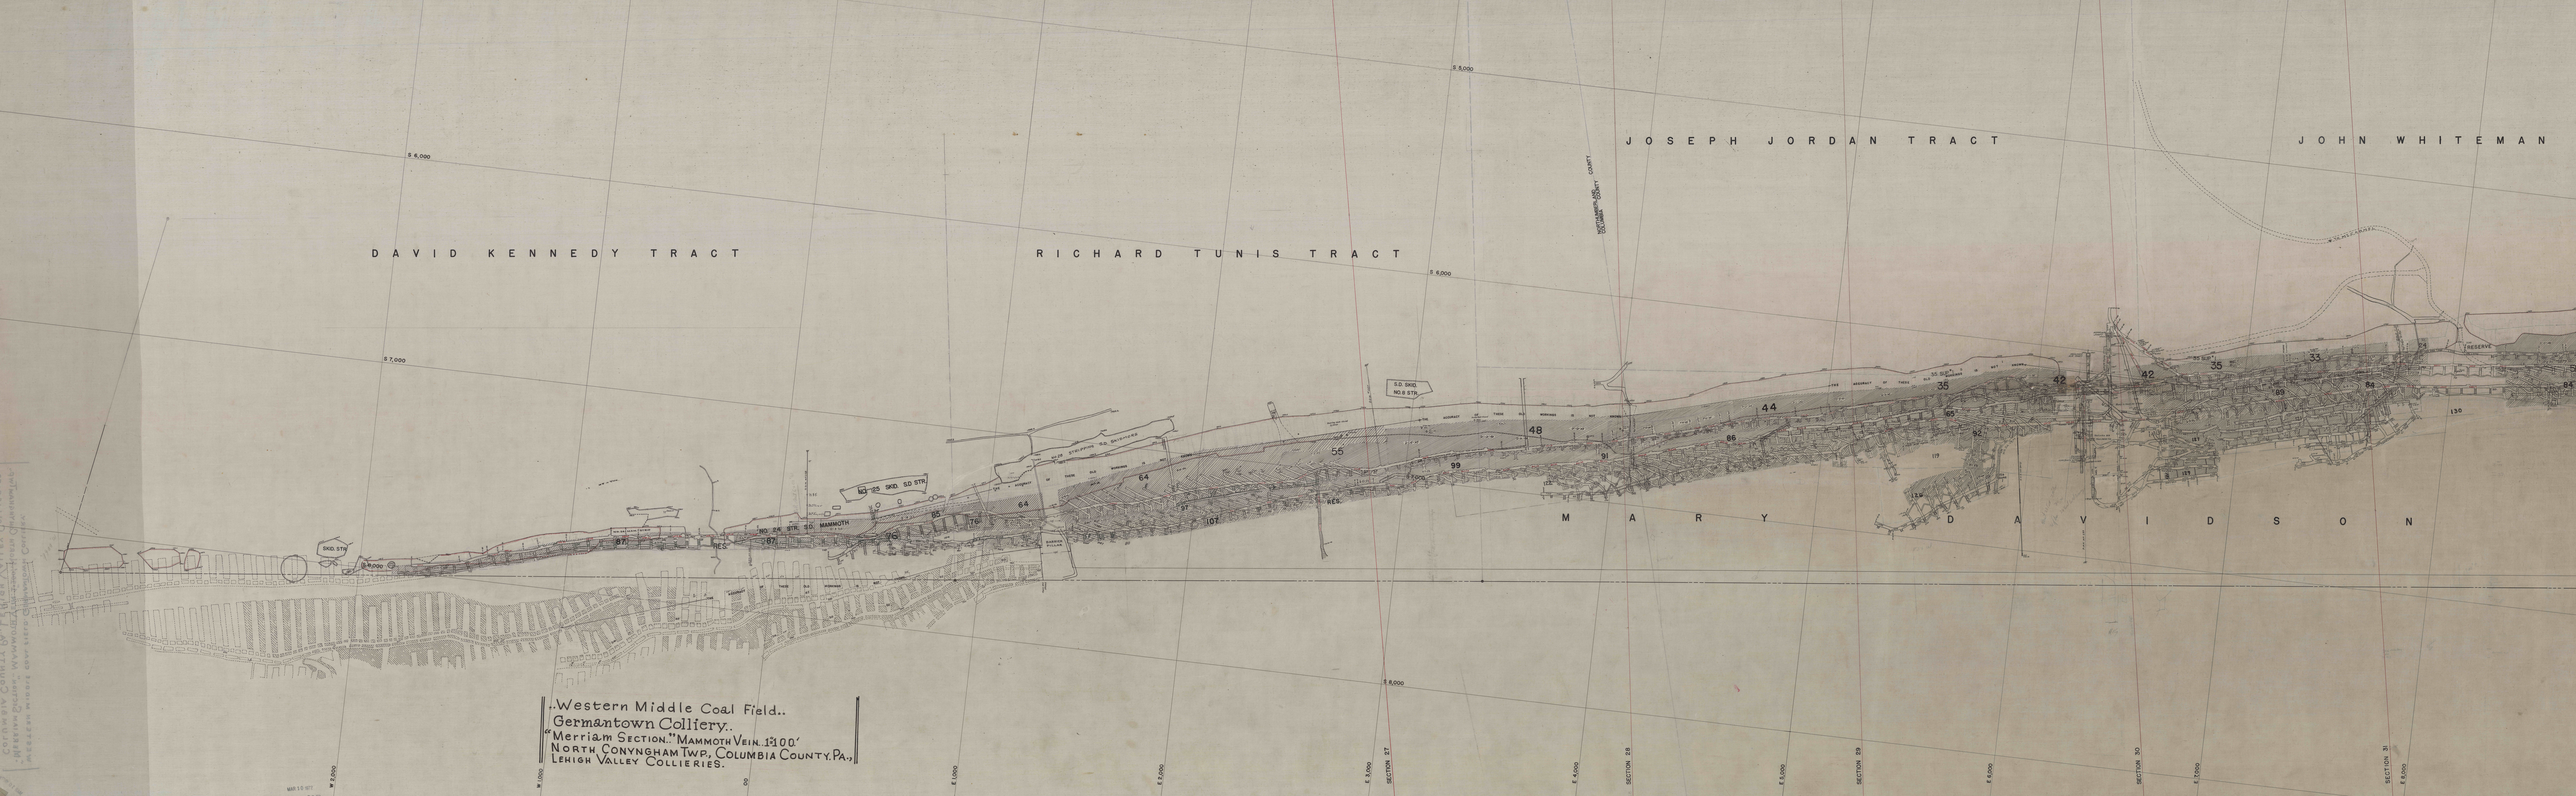

Western Middle Coal Field..
Germantown Colliery.
"Merriam Section." Mammoth Vein. 1"=100'
North Conyngham Twp., Columbia County, Pa.,
Lehigh Valley Collieries.