


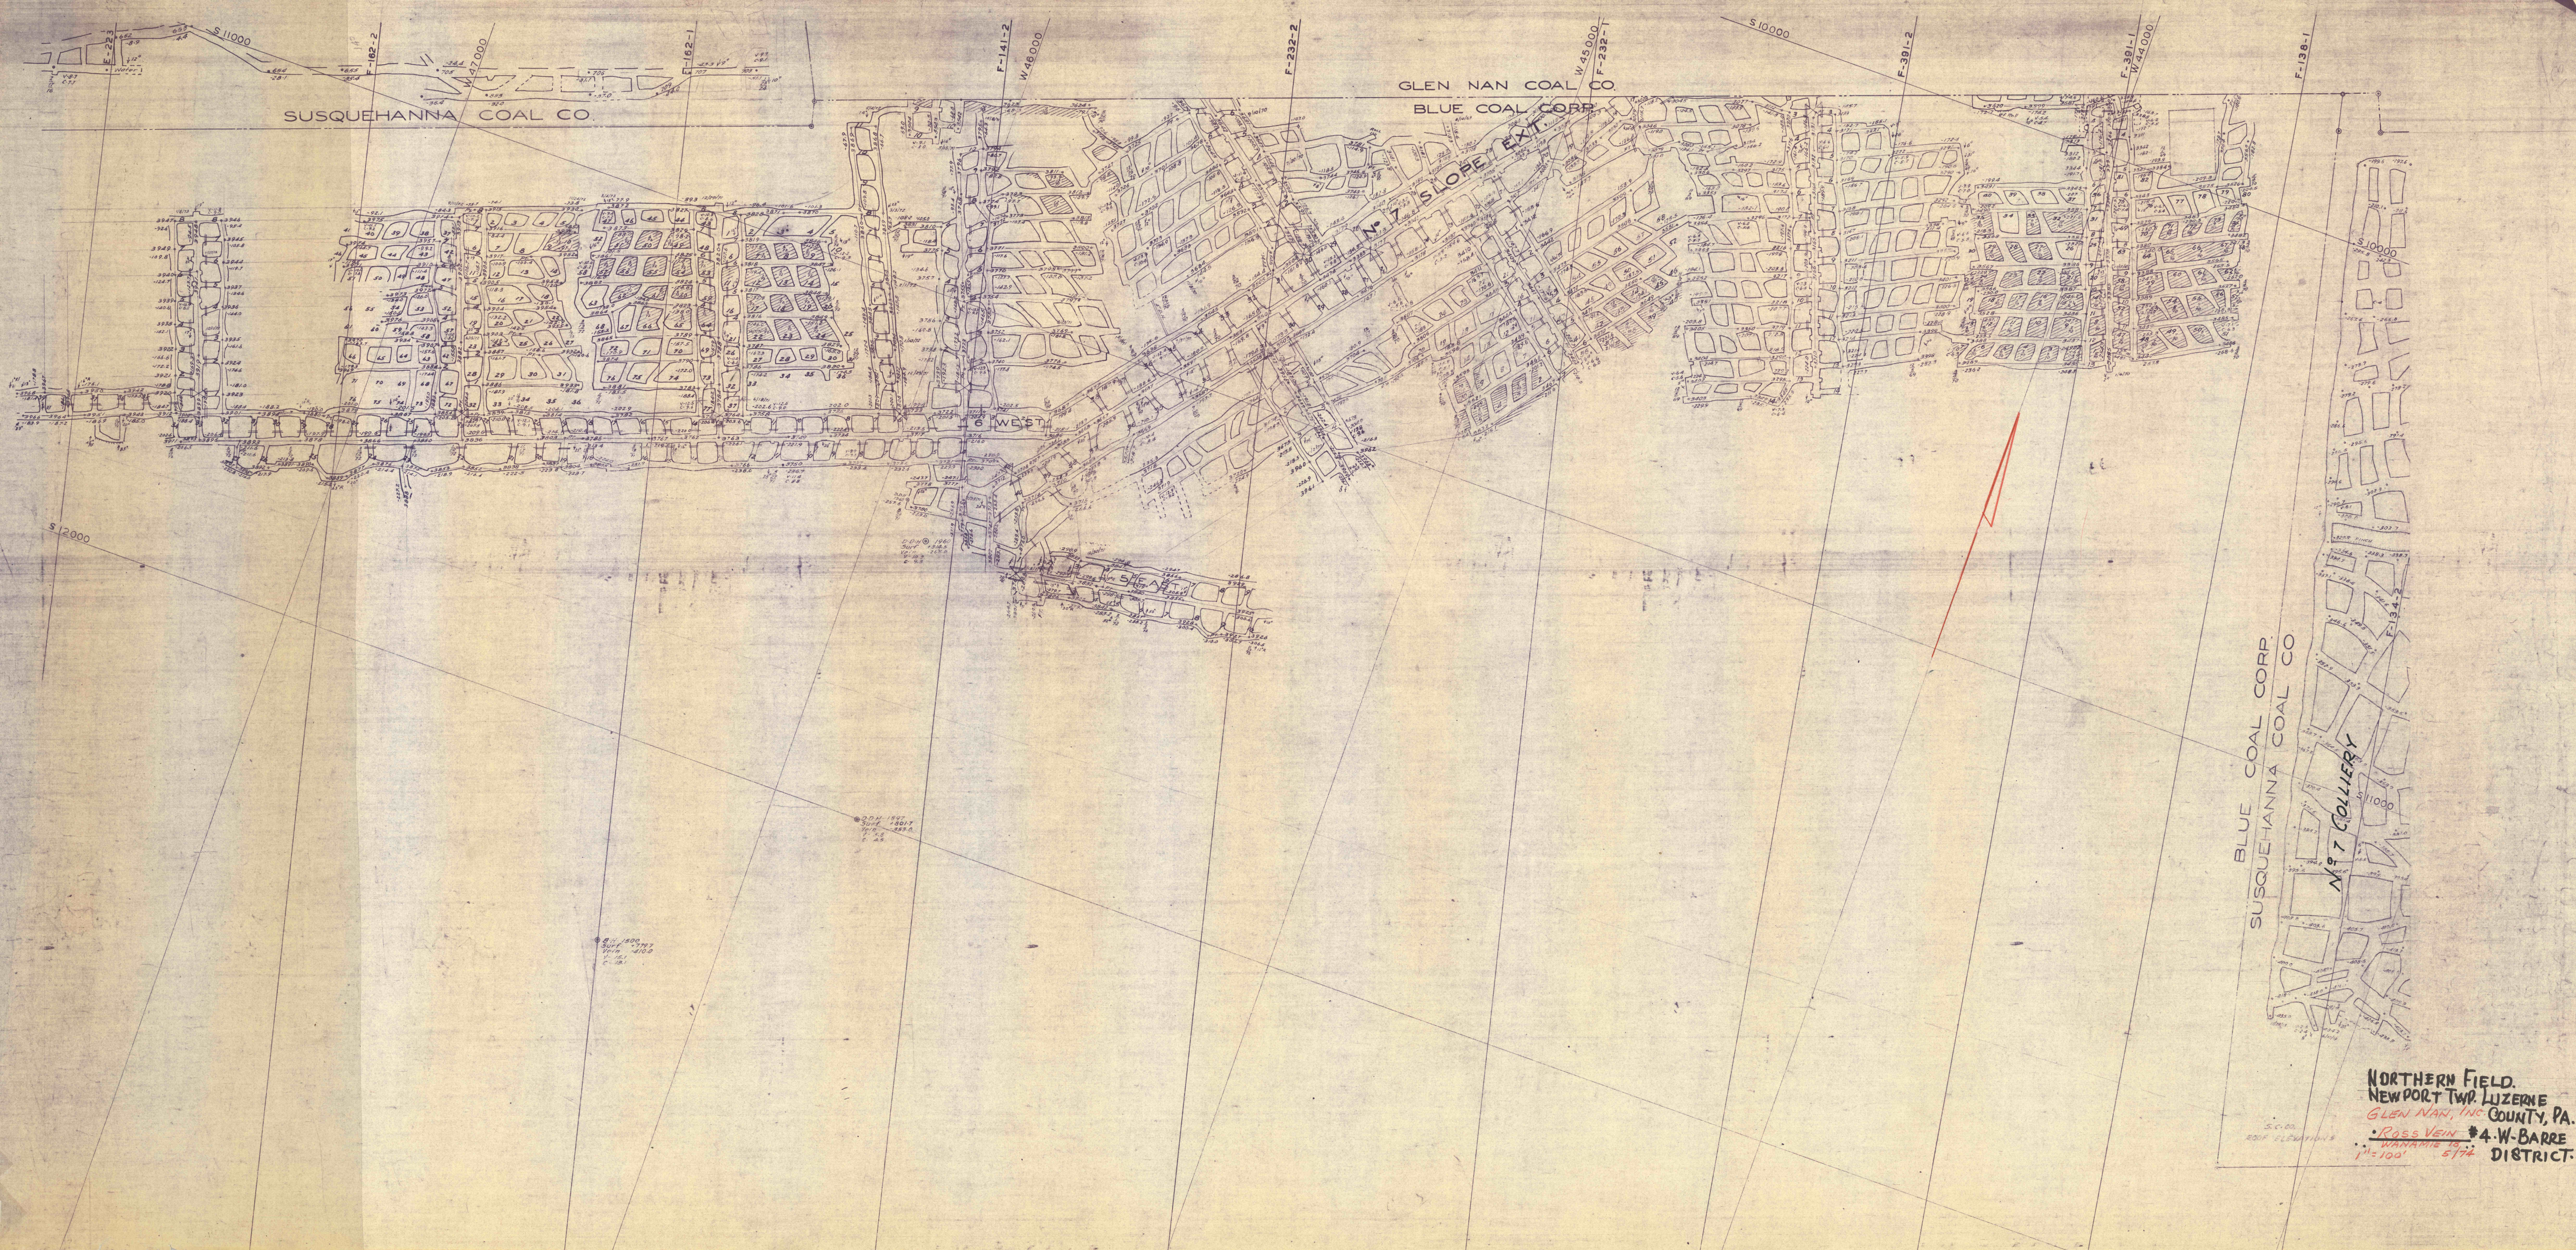

NORTHERN FIELD.
NEWPORT TWP. LUZERNE
COUNTY, PA.
GLEN NAN, INC.
ROSS VEIN #4-W-BARRE
DISTRICT.
1"=100' 5/74'