


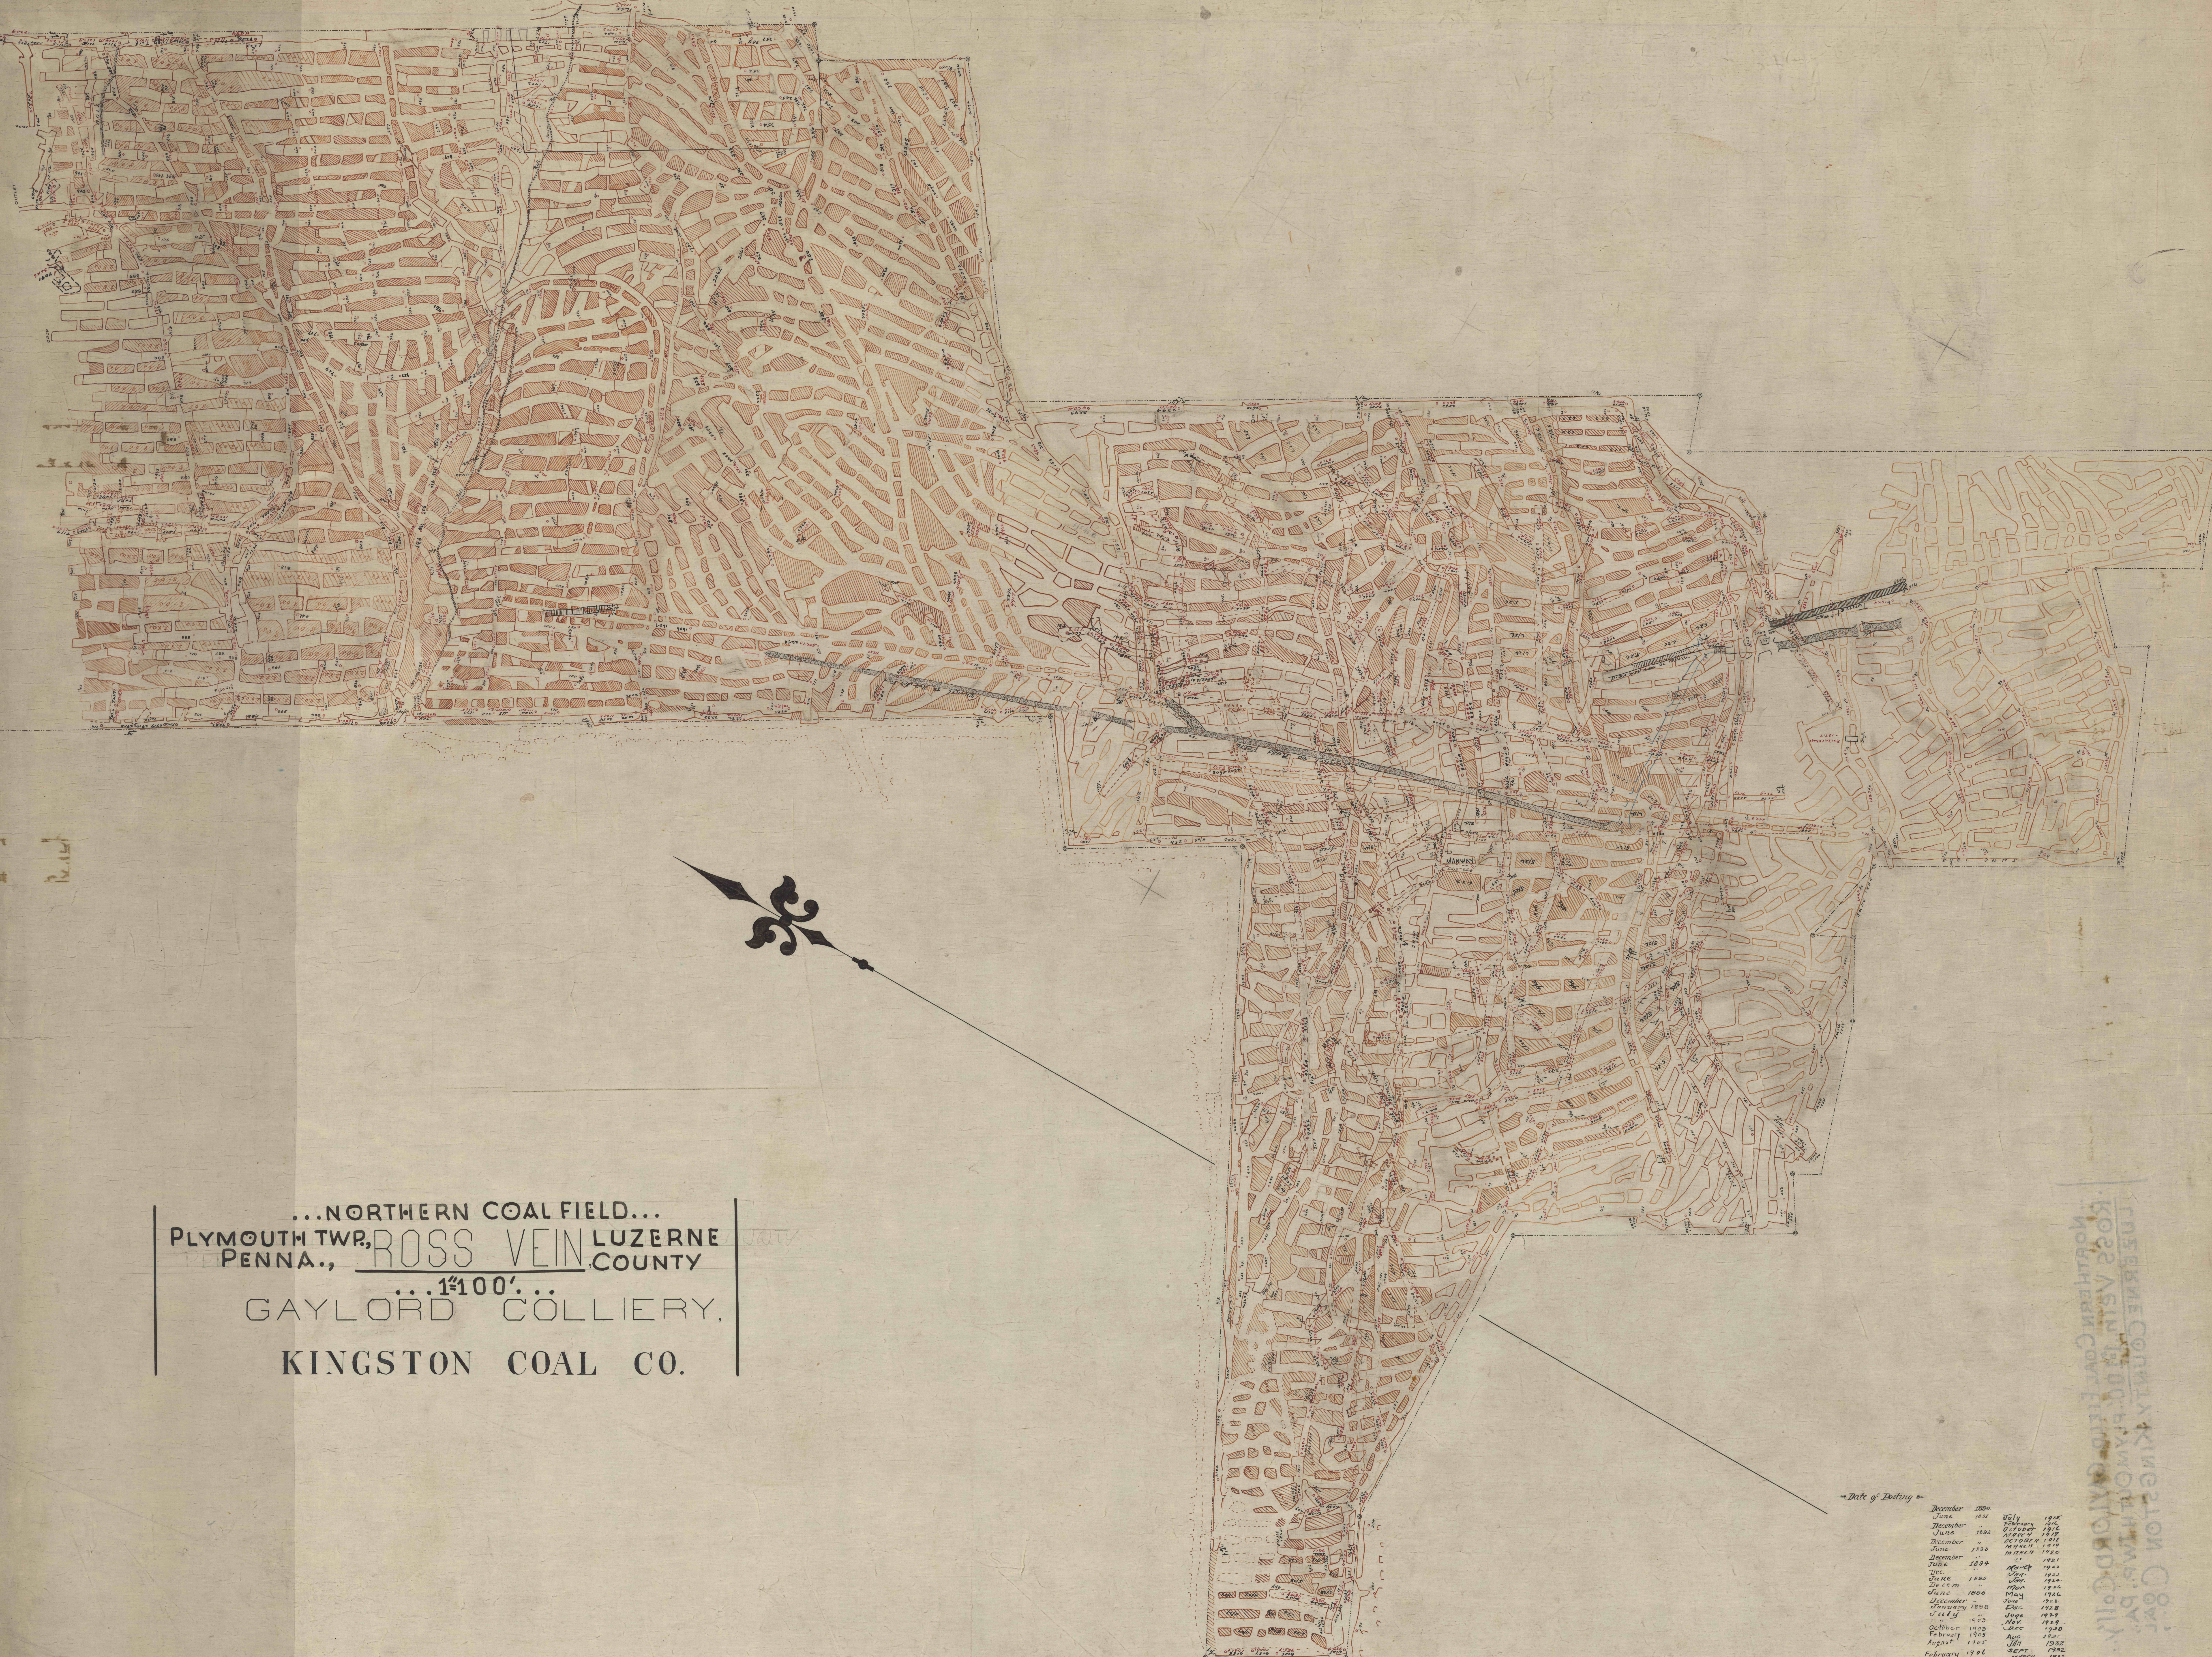

...NORTHERN COAL FIELD...
PLYMOUTH TWP, PENNA., ROSS VEIN, LUZERNE COUNTY
...1:100'...
GAYLORD COLLIERY,
KINGSTON COAL CO.

Date of Drilling

December 1896	July 1905
June 1897	February 1906
December 1897	October 1906
June 1898	April 1907
December 1898	October 1907
June 1899	March 1908
December 1899	March 1909
June 1900	May 1910
December 1900	July 1911
June 1901	September 1912
December 1901	November 1913
June 1902	January 1914
December 1902	March 1915
June 1903	May 1916
December 1903	July 1917
June 1904	September 1918
December 1904	November 1919
June 1905	January 1920
December 1905	March 1921
June 1906	May 1922

LUZERNE COUNTY KINGSTON COAL
ROSS VEIN
NORTHERN COAL FIELD GAYLORD COLLY