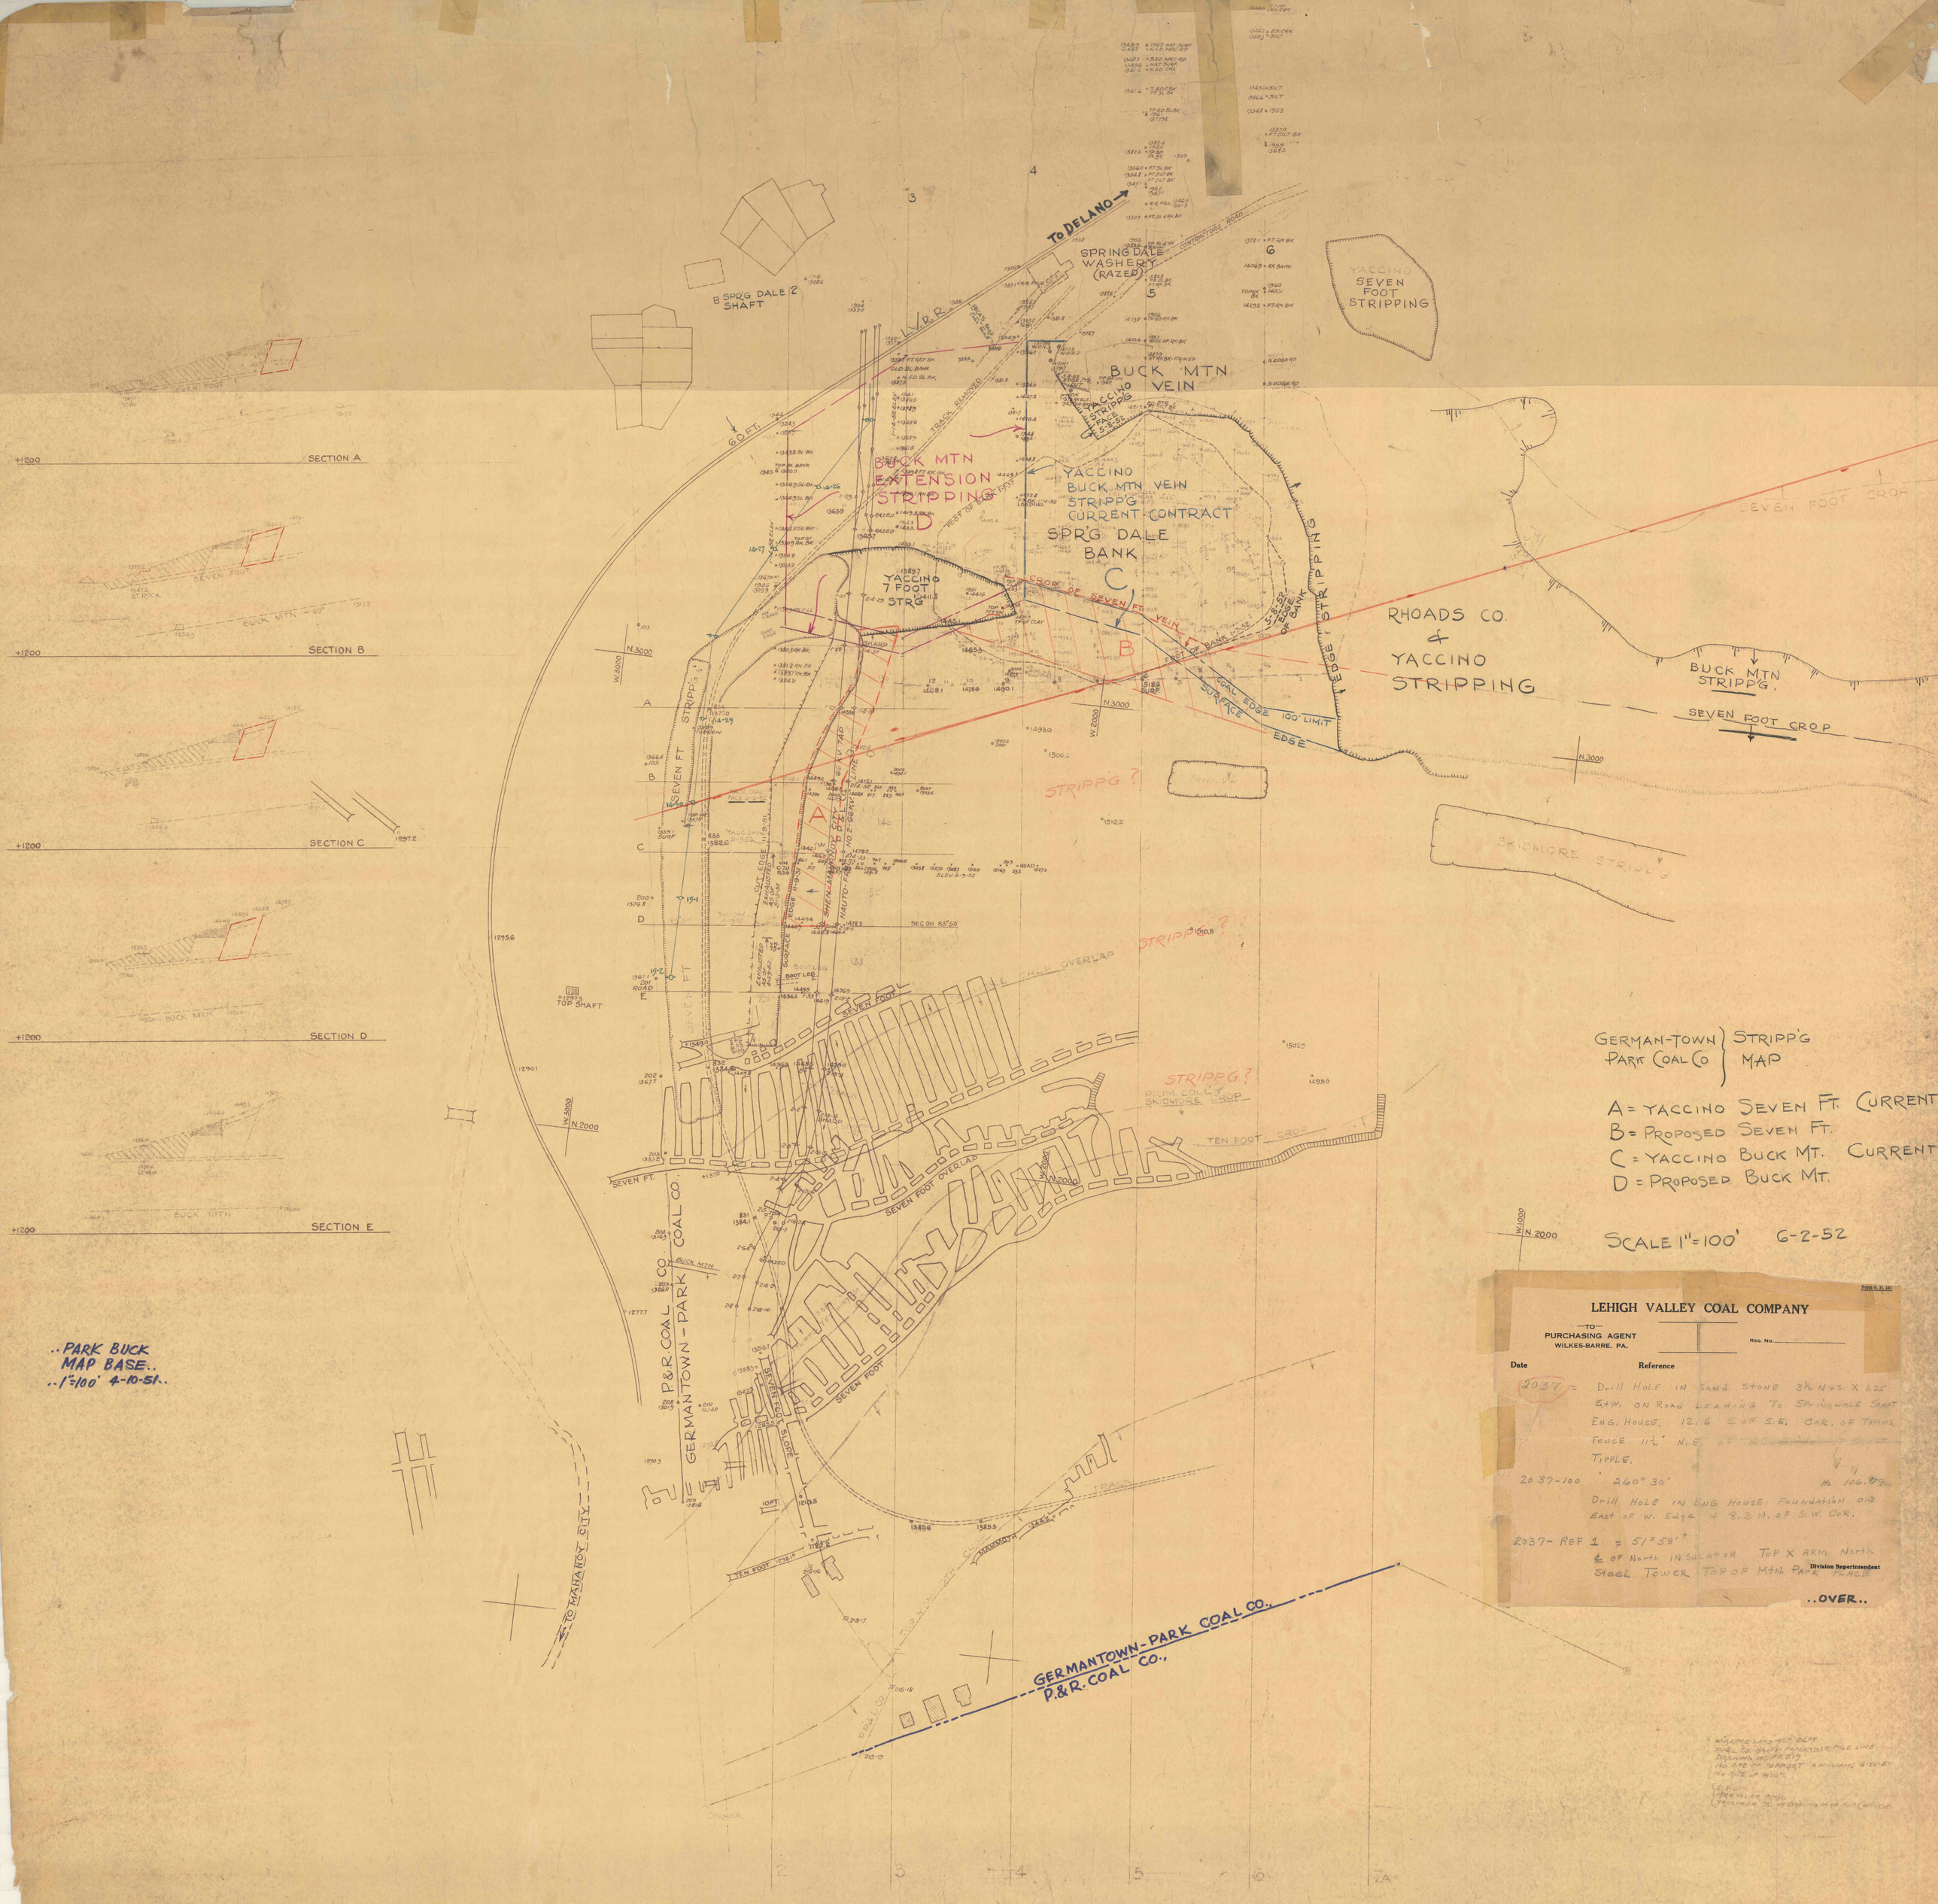
TO DELANO
SPRING DALE WASHERY (RAZED)
B SPR'G DALE ℙ SHAFT
YACCINO SEVEN FOOT STRIPPING
BUCK MTN VEIN
YACCINO STRIPP'G FACE 5-8-52
BUCK MTN EXTENSION STRIPPING
YACCINO BUCK MTN VEIN STRIPP'G CURRENT CONTRACT
SPR'G DALE BANK
YACCINO 7 FOOT STRP'G
CROP OF SEVEN FT. VEIN
FOOT OF BANK 5-8-52
COAL EDGE 100' LIMIT
SURFACE EDGE
EDGE STRIPPING
RHOADS CO. & YACCINO STRIPPING
SEVEN FOOT CROP
BUCK MTN STRIPP'G.
SKIDMORE STRIPP'G
STRIPP'G ?
SEVEN FT. STRIPP'G
SEVEN FOOT OVERLAP
TEN FOOT CROP
P&R. COAL CO.
GERMANTOWN-PARK COAL CO.
TO MAHANOY CITY
GERMANTOWN-PARK COAL CO., P.&R. COAL CO.,
SECTION A
SECTION B
SECTION C
SECTION D
SECTION E
+1200
GERMAN-TOWN PARK COAL CO } STRIPP'G MAP
A = YACCINO SEVEN FT. CURRENT
B = PROPOSED SEVEN FT.
C = YACCINO BUCK MT. CURRENT
D = PROPOSED BUCK MT.
SCALE 1"=100' 6-2-52
..PARK BUCK MAP BASE..
..1"=100' 4-10-51..
LEHIGH VALLEY COAL COMPANY
TO PURCHASING AGENT WILKES-BARRE, PA.
REQ. NO.
Date
Reference
2037 = Drill HOLE IN SAND STONE 3½ N.W.S. X 1.25 E+W. ON Road LEADING To SPRINGDALE Shaft ENG. HOUSE. 12.6 S. OF S.E. COR. OF TRANS. FENCE 11½' N.E. OF
TIPPLE.
2037-100 260° 30' 106.87
Drill HOLE IN ENG HOUSE Foundation 0.3 East of W. Edge + 8.3 N. of S.W. Cor.
2037-REF 1 = 51° 58'
℄ of North INSULATOR TOP X ARM North Steel TOWER TOP OF MTN. PARK PLACE
Division Superintendent
..OVER..