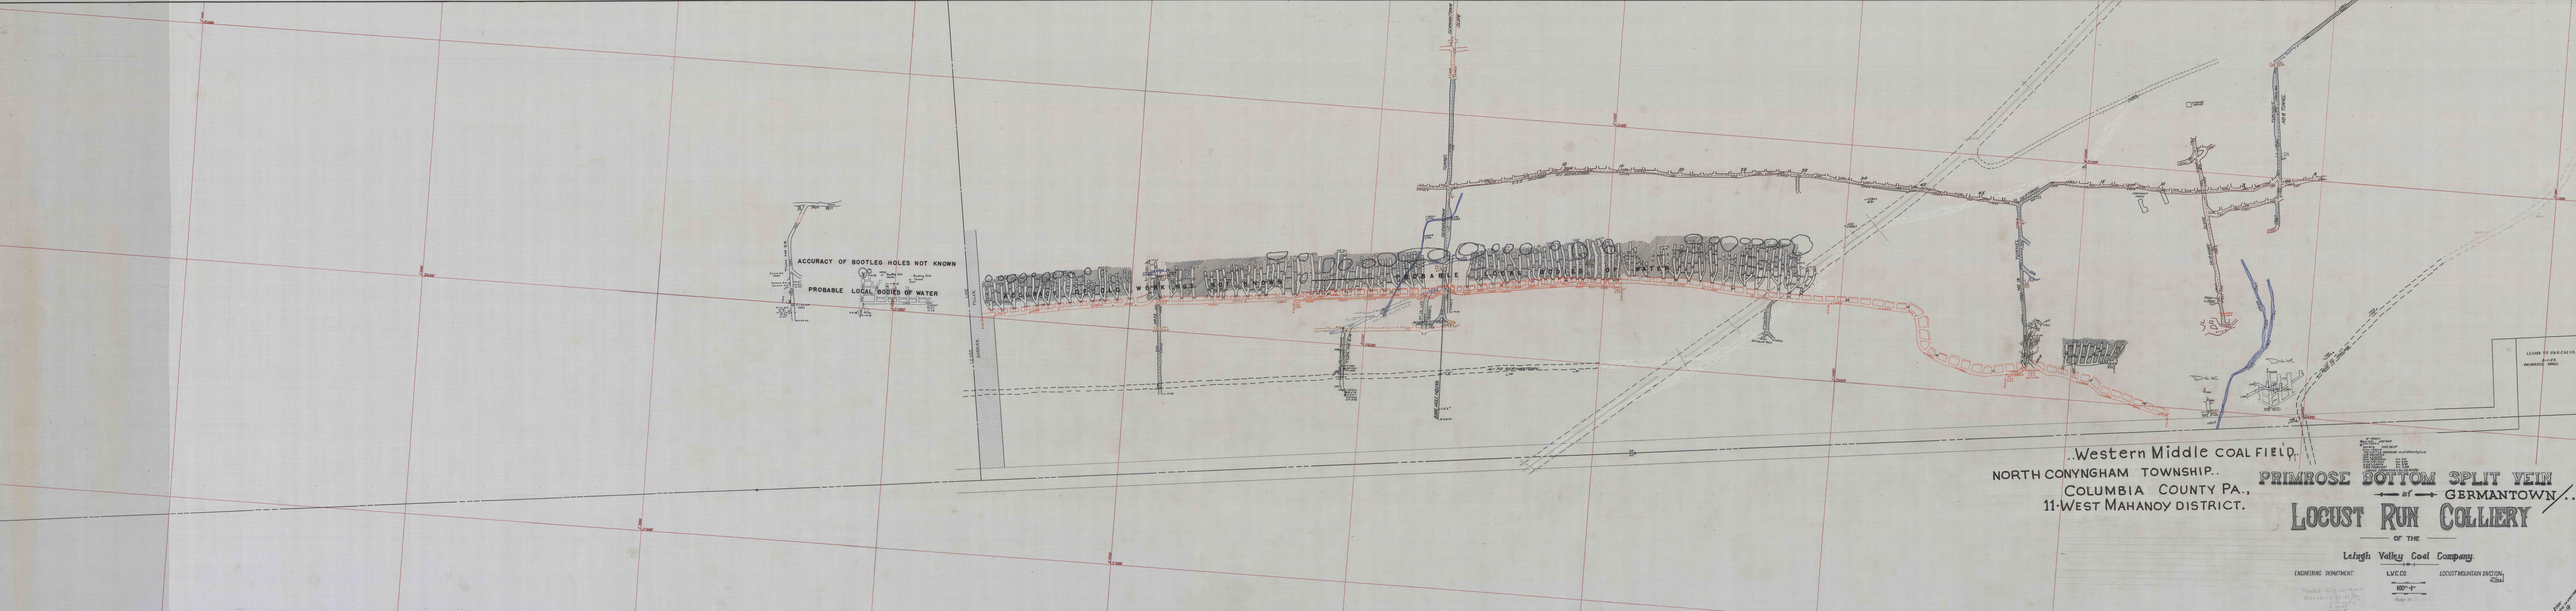

ACCURACY OF BOOTLEG HOLES NOT KNOWN
PROBABLE LOCAL BODIES OF WATER
WORKS UNDER WATER
WORKS UNDER WATER
CROSS A RISE
WORKS UNDER WATER
WORKS UNDER WATER
LEASED TO KAI-CAL CO.
PROPOSED SHAFT
..Western Middle COAL FIELD..
NORTH CONYNGHAM TOWNSHIP..
COLUMBIA COUNTY PA.,
11-WEST MAHANOY DISTRICT.
PRIMROSE BOTTOM SPLIT VEIN
at GERMANTOWN..
LOCUST RUN COLLIERY
OF THE
Lehigh Valley Coal Company.
ENGINEERING DEPARTMENT
L.V.C.CO.
LOCUST MOUNTAIN DIVISION.