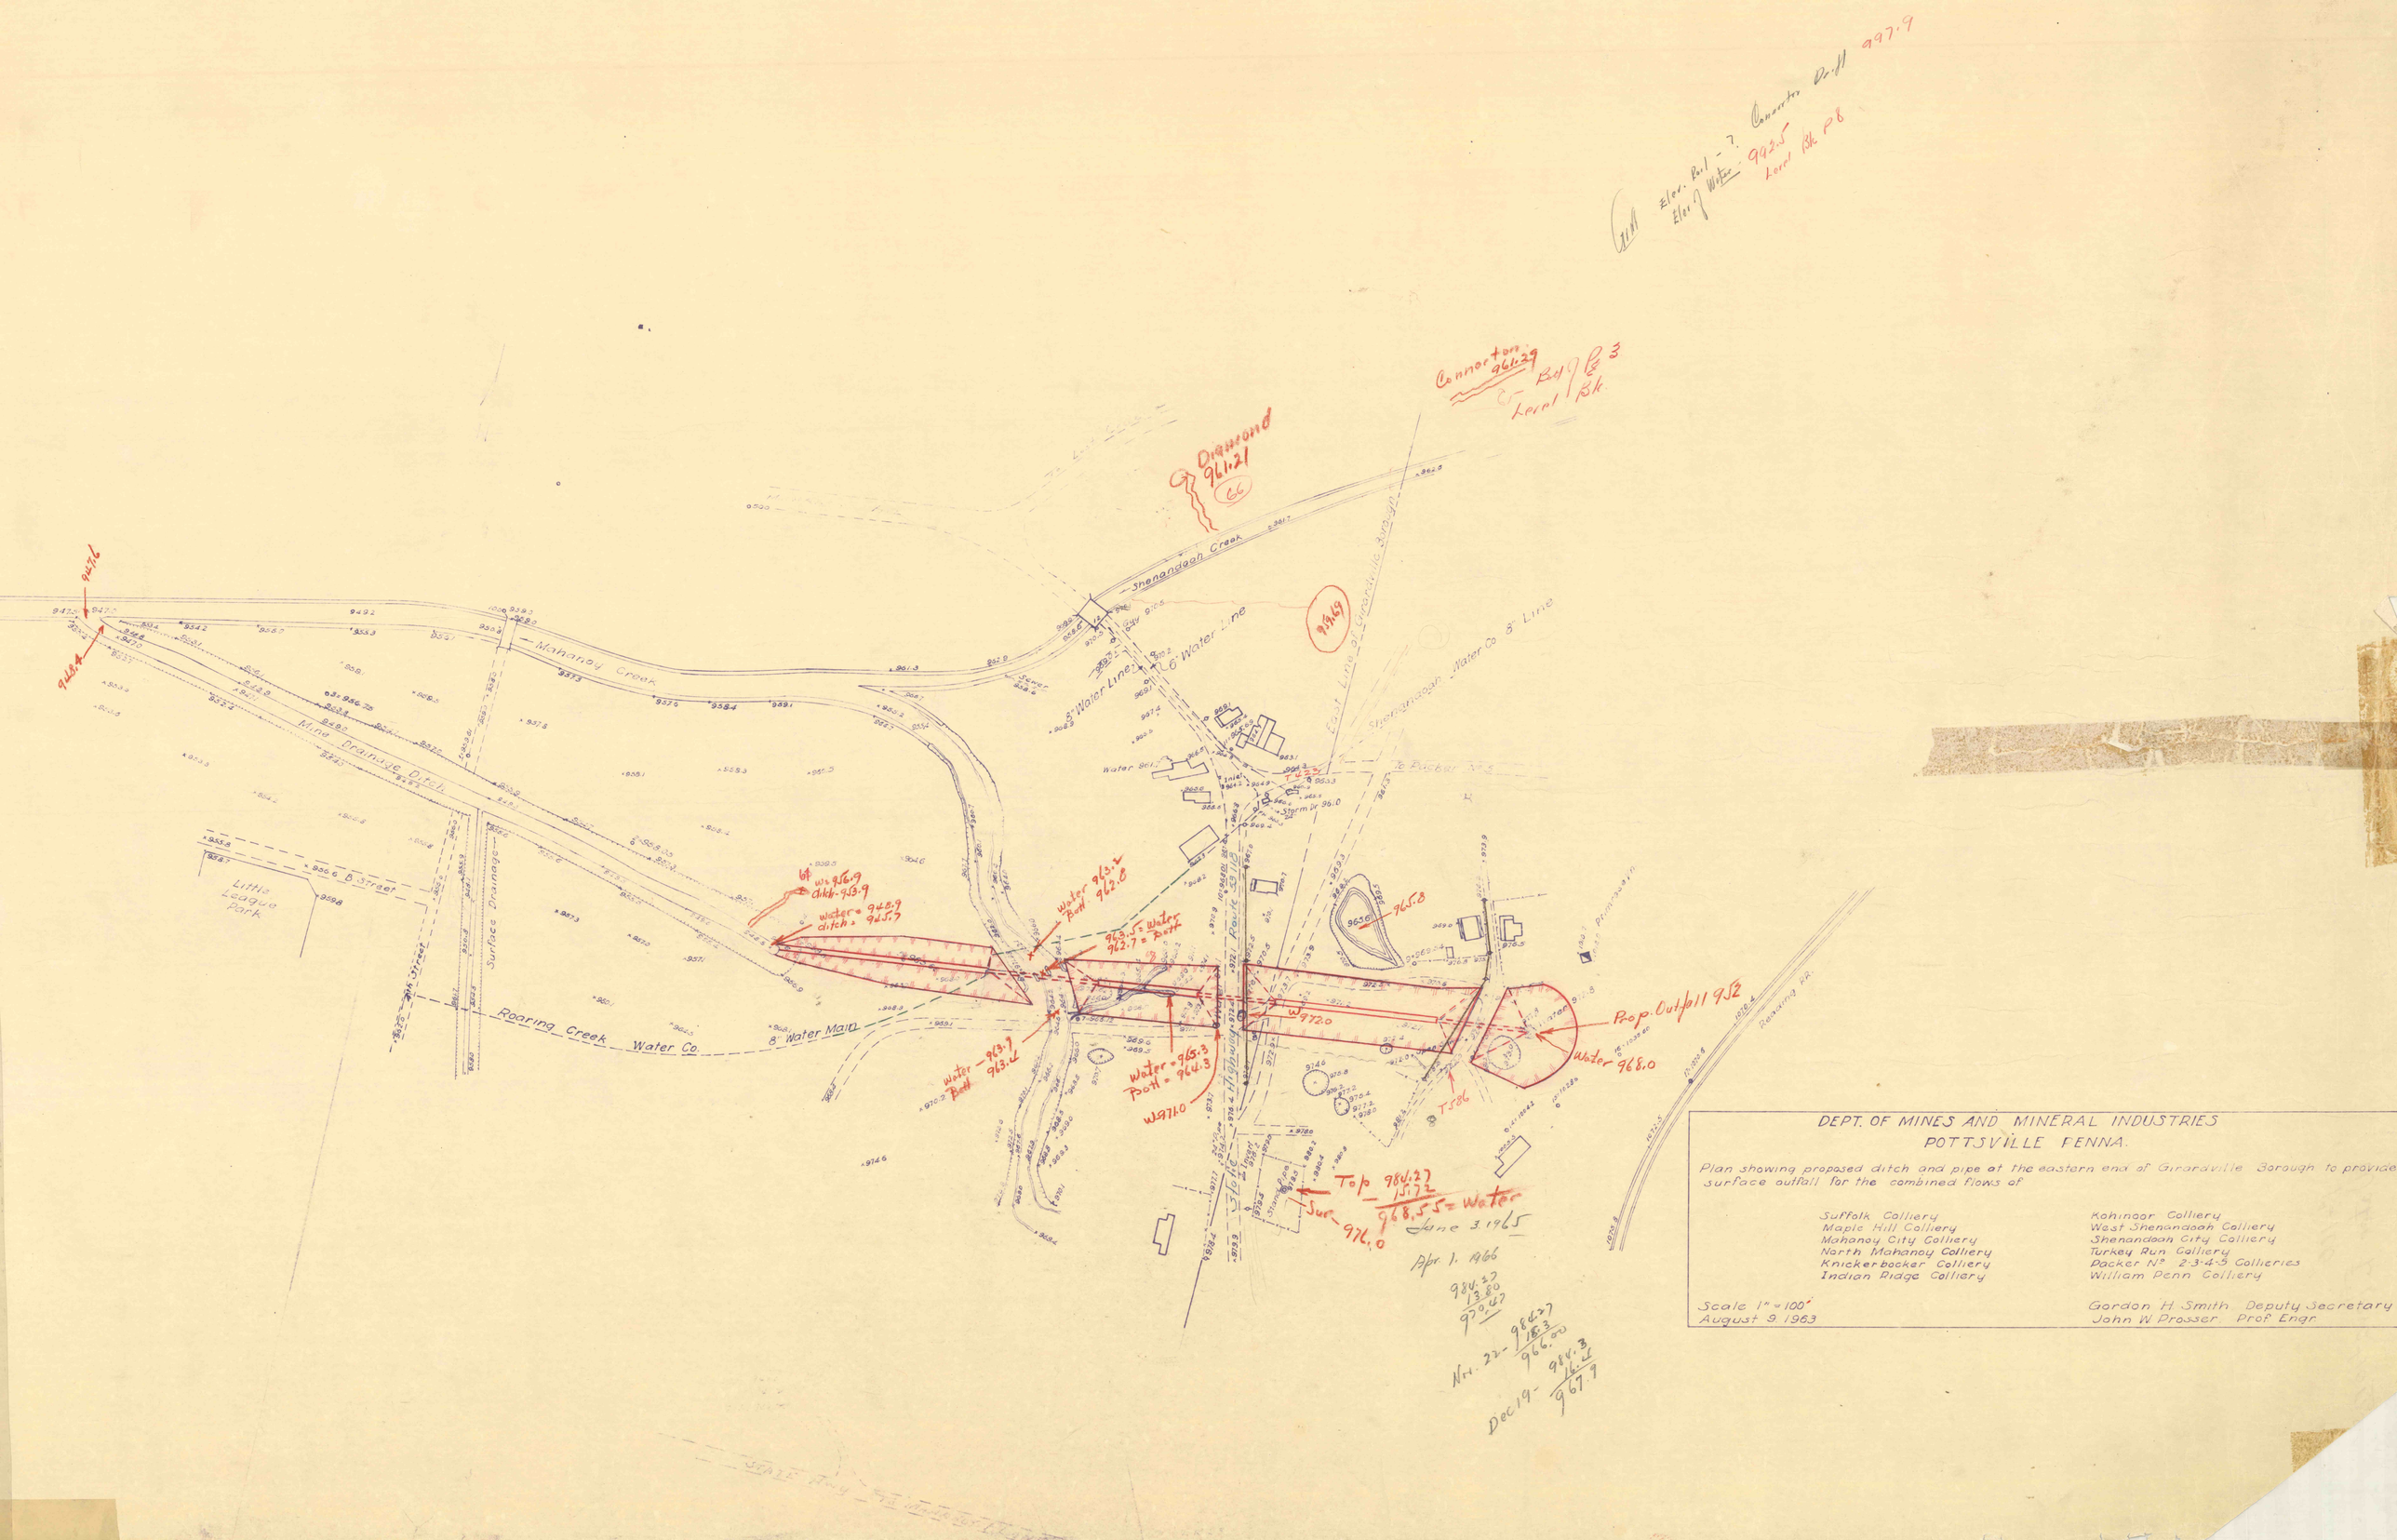
Shenandoah Creek
Mahanoy Creek
Mine Drainage Ditch
Little League Park
B Street
Surface Drainage
Roaring Creek Water Co.
8" Water Main
8" Water Line
6" Water Line
East Line of Girardville Borough
Shenandoah Water Co. 8" Line
To Packer No. 5
Water
Storm Inlet
Pouk Ave
Highway
Prop. Outfall 952
Water 968.0
Water 963.9
Water 963.4
Water 963.3
Water 965.8
Water 962.8
Water 965.2
Top 984.27
Sur. 976.0
Water
June 3, 1965
Apr. 1, 1966
Nov. 22
Dec. 19
Diamond 961.21
Connerton 964.29
Connerton Drill 997.9
Elev. Pool - ?
Elev. of Water 992.5
Level Bk. P8
Level Bk. P3
DEPT. OF MINES AND MINERAL INDUSTRIES
POTTSVILLE PENNA.
Plan showing proposed ditch and pipe at the eastern end of Girardville Borough to provide surface outfall for the combined flows of
Suffolk Colliery
Maple Hill Colliery
Mahanoy City Colliery
North Mahanoy Colliery
Knickerbocker Colliery
Indian Ridge Colliery
Kohinoor Colliery
West Shenandoah Colliery
Shenandoah City Colliery
Turkey Run Colliery
Packer No. 2-3-4-5 Collieries
William Penn Colliery
Scale 1" = 100'
August 9, 1963
Gordon H. Smith, Deputy Secretary
John W. Prosser, Prof. Engr.