
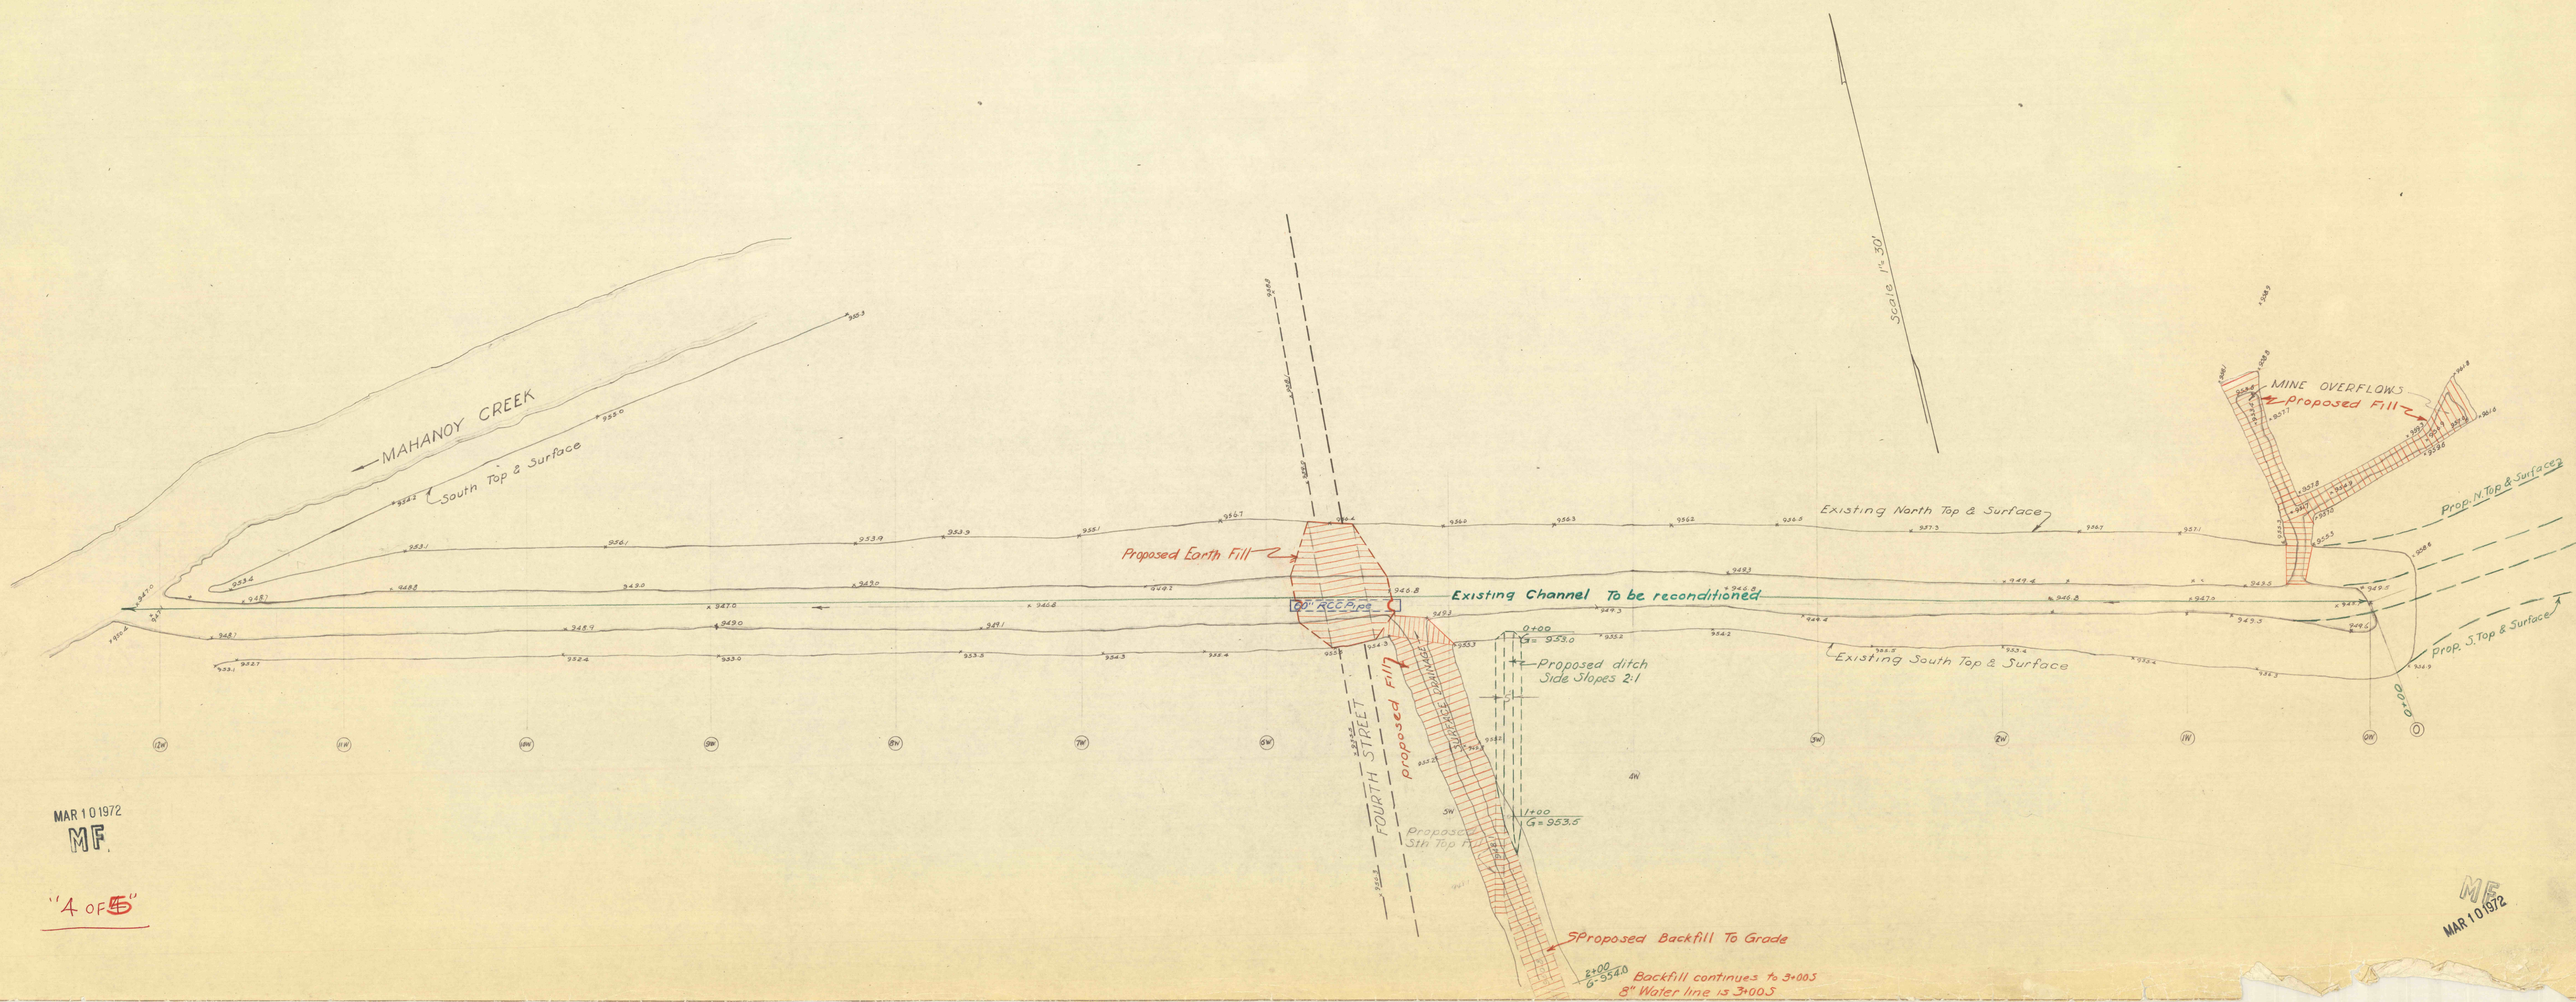


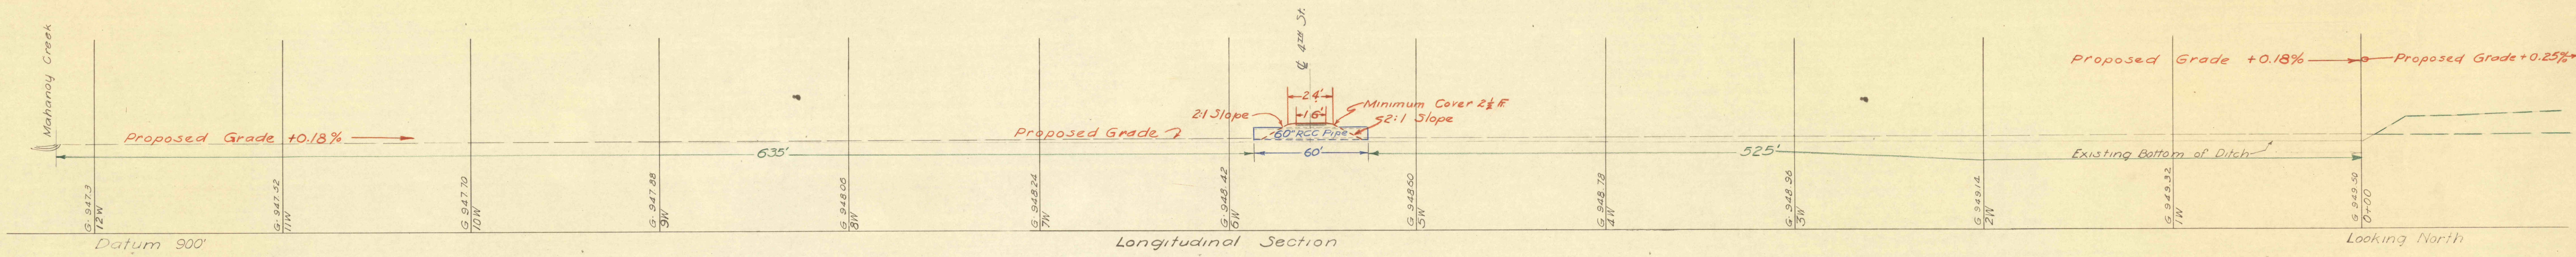

MAR 10 1972
MF
"4 OF 5"

MAR 10 1972
MF