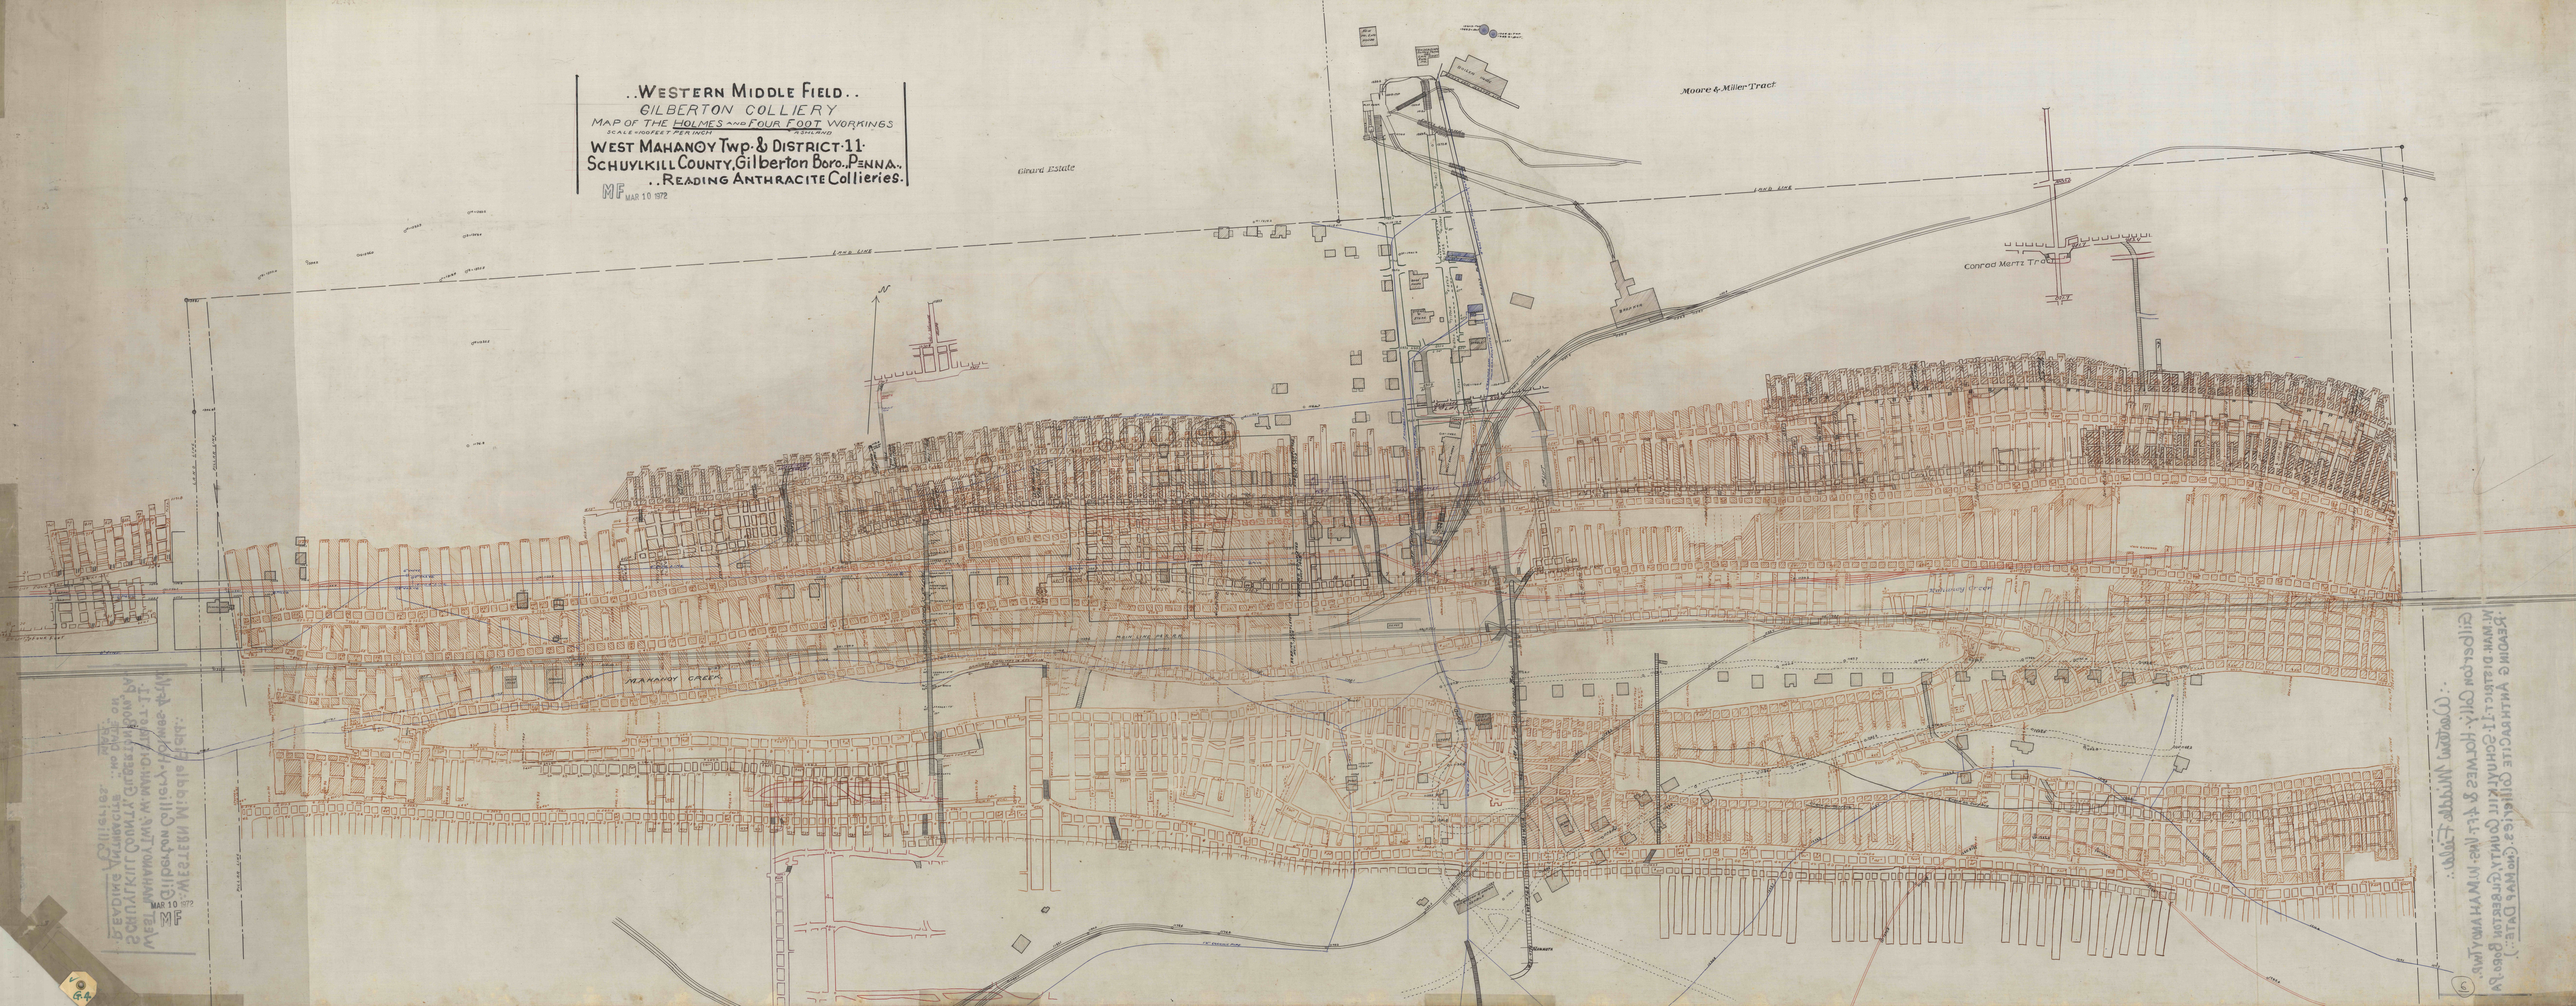
..WESTERN MIDDLE FIELD..
GILBERTON COLLIERY
MAP OF THE HOLMES AND FOUR FOOT WORKINGS
SCALE 100 FEET PER INCH
WEST MAHANOY Twp. & DISTRICT 11
SCHUYLKILL COUNTY, Gilberton Boro., PENNA.
..READING ANTHRACITE Collieries.
MF MAR 10 1972
Girard Estate
Moore & Miller Tract
Conrad Mertz Tract
MAHANOY CREEK
MAHANOY AVENUE
MAIN LINE P.R.R.
LOCK LINE
N