


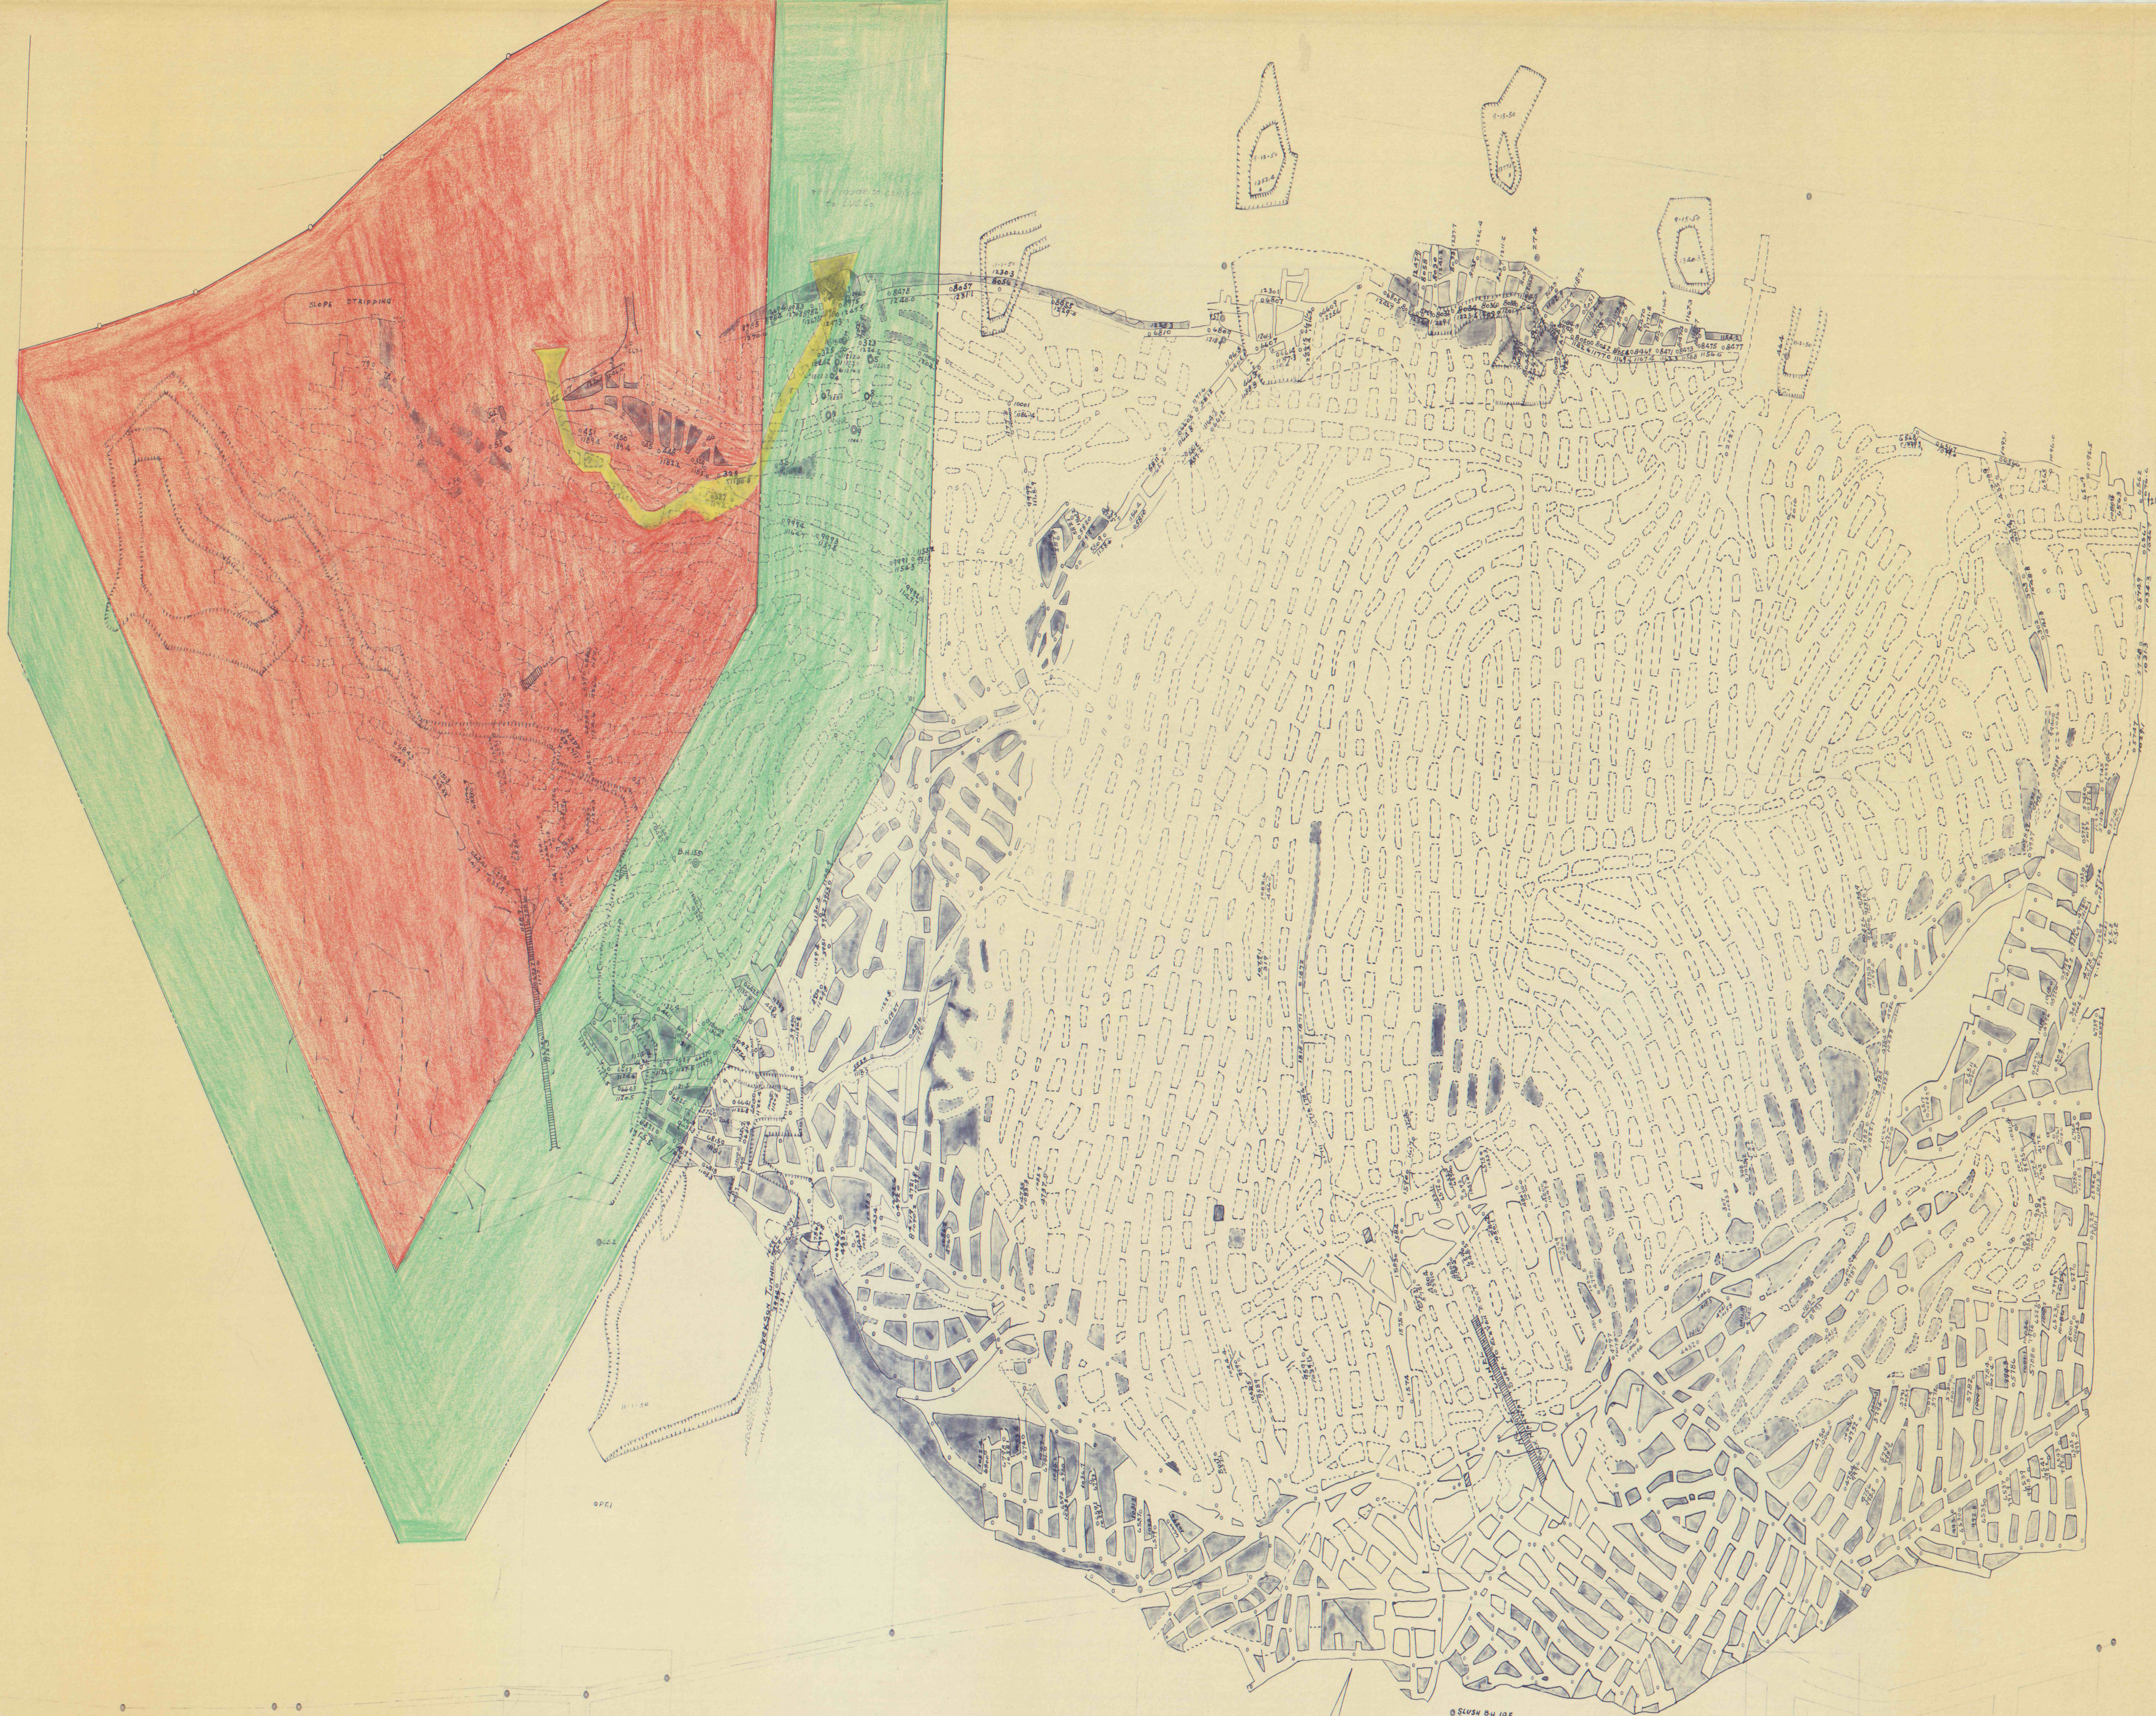

FORTY FORT
SIX FOOT VEIN
NORTH