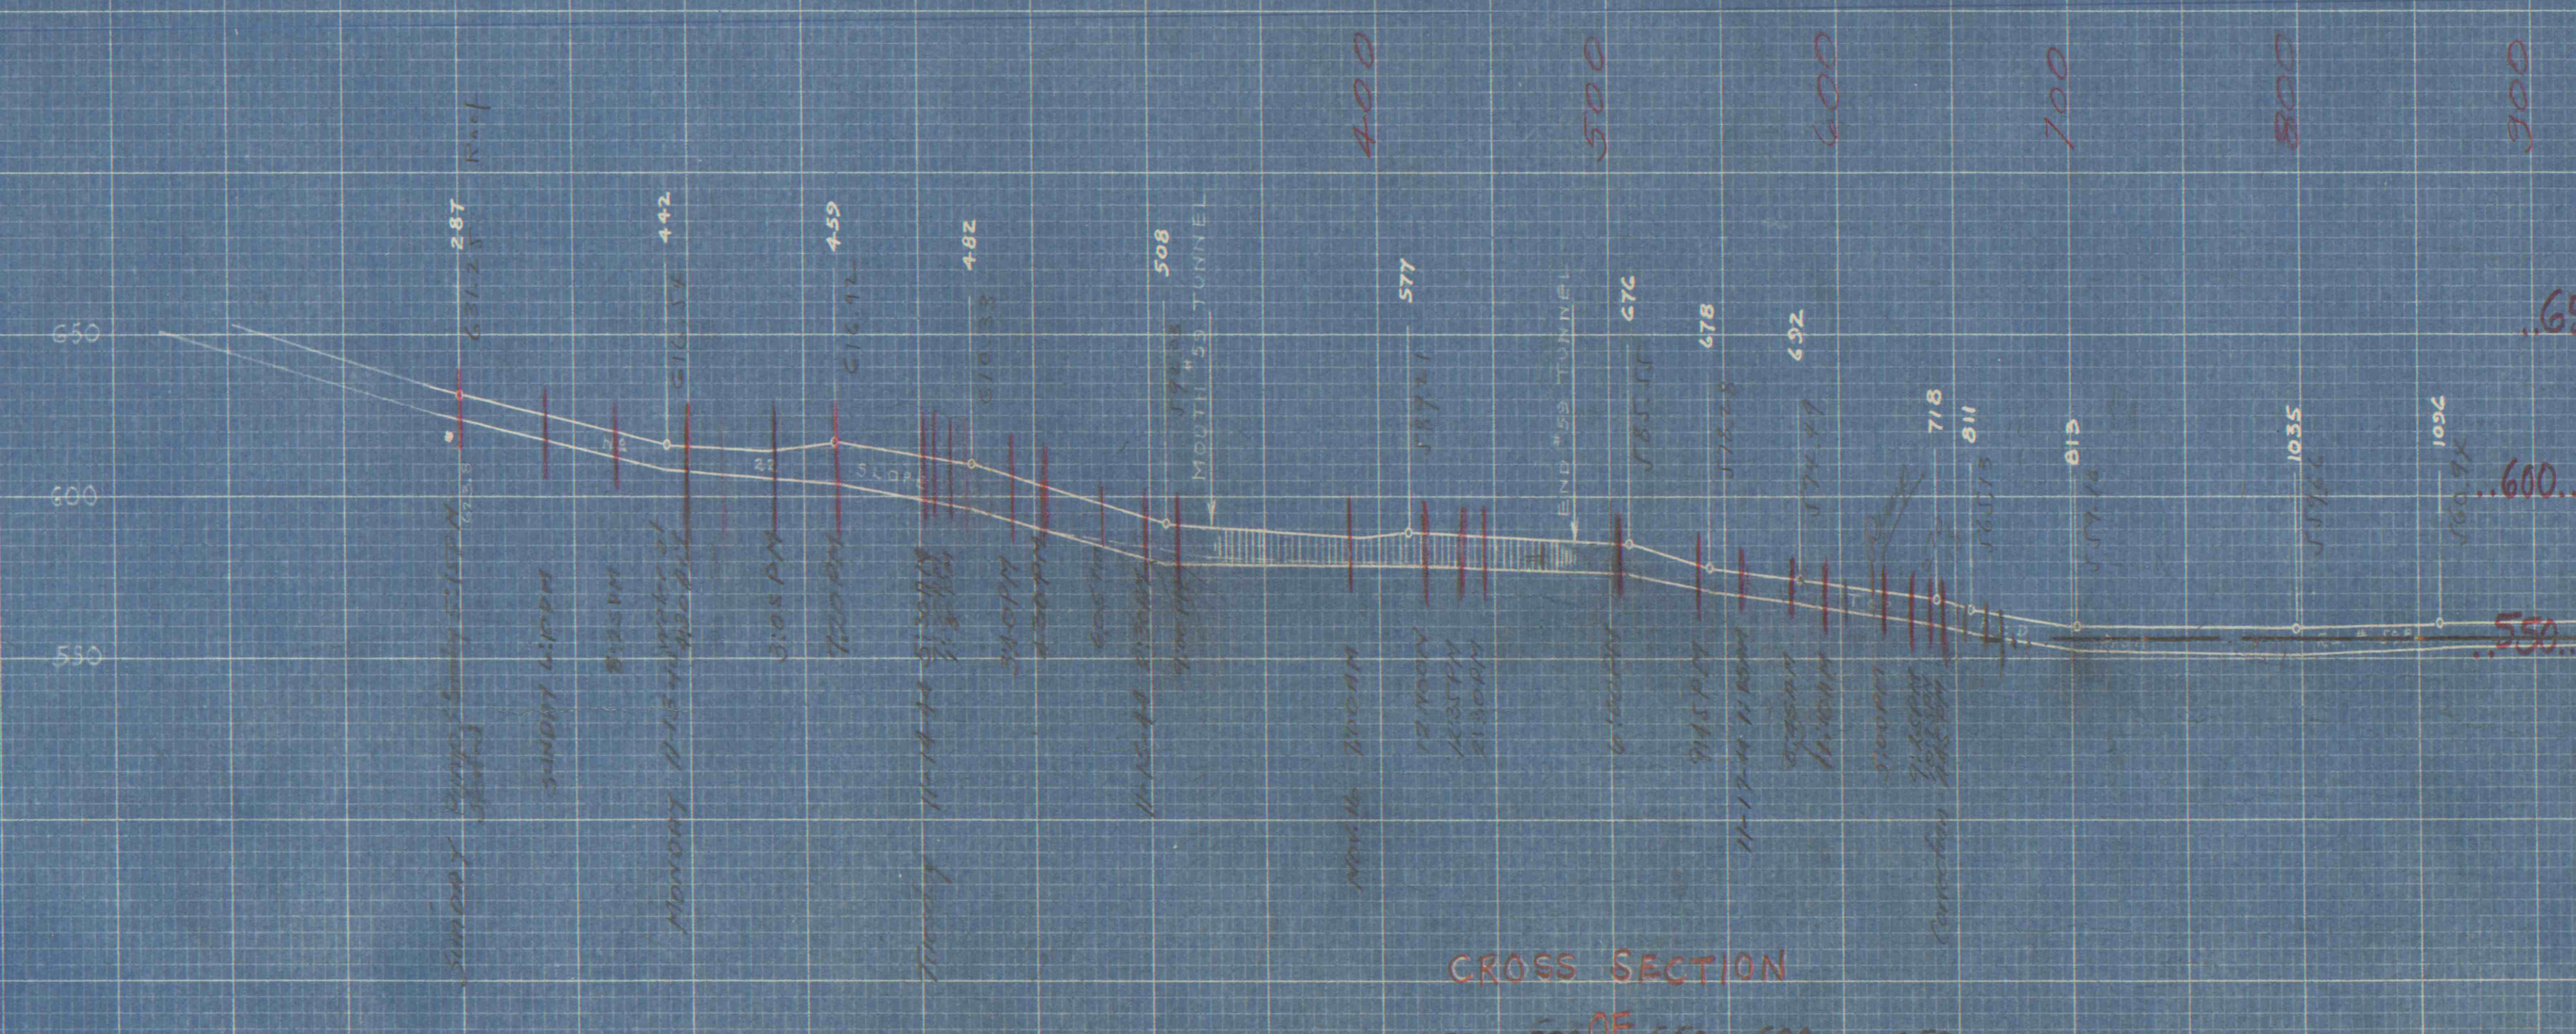

CROSS SECTION
OF
NO. 22 SLOPE THRU NO. 59 TUNNEL AND RD. 598 T.R.A.
FRANKLIN COAL MINING CO.
Scale: 1" = 50', 11-13-1944