


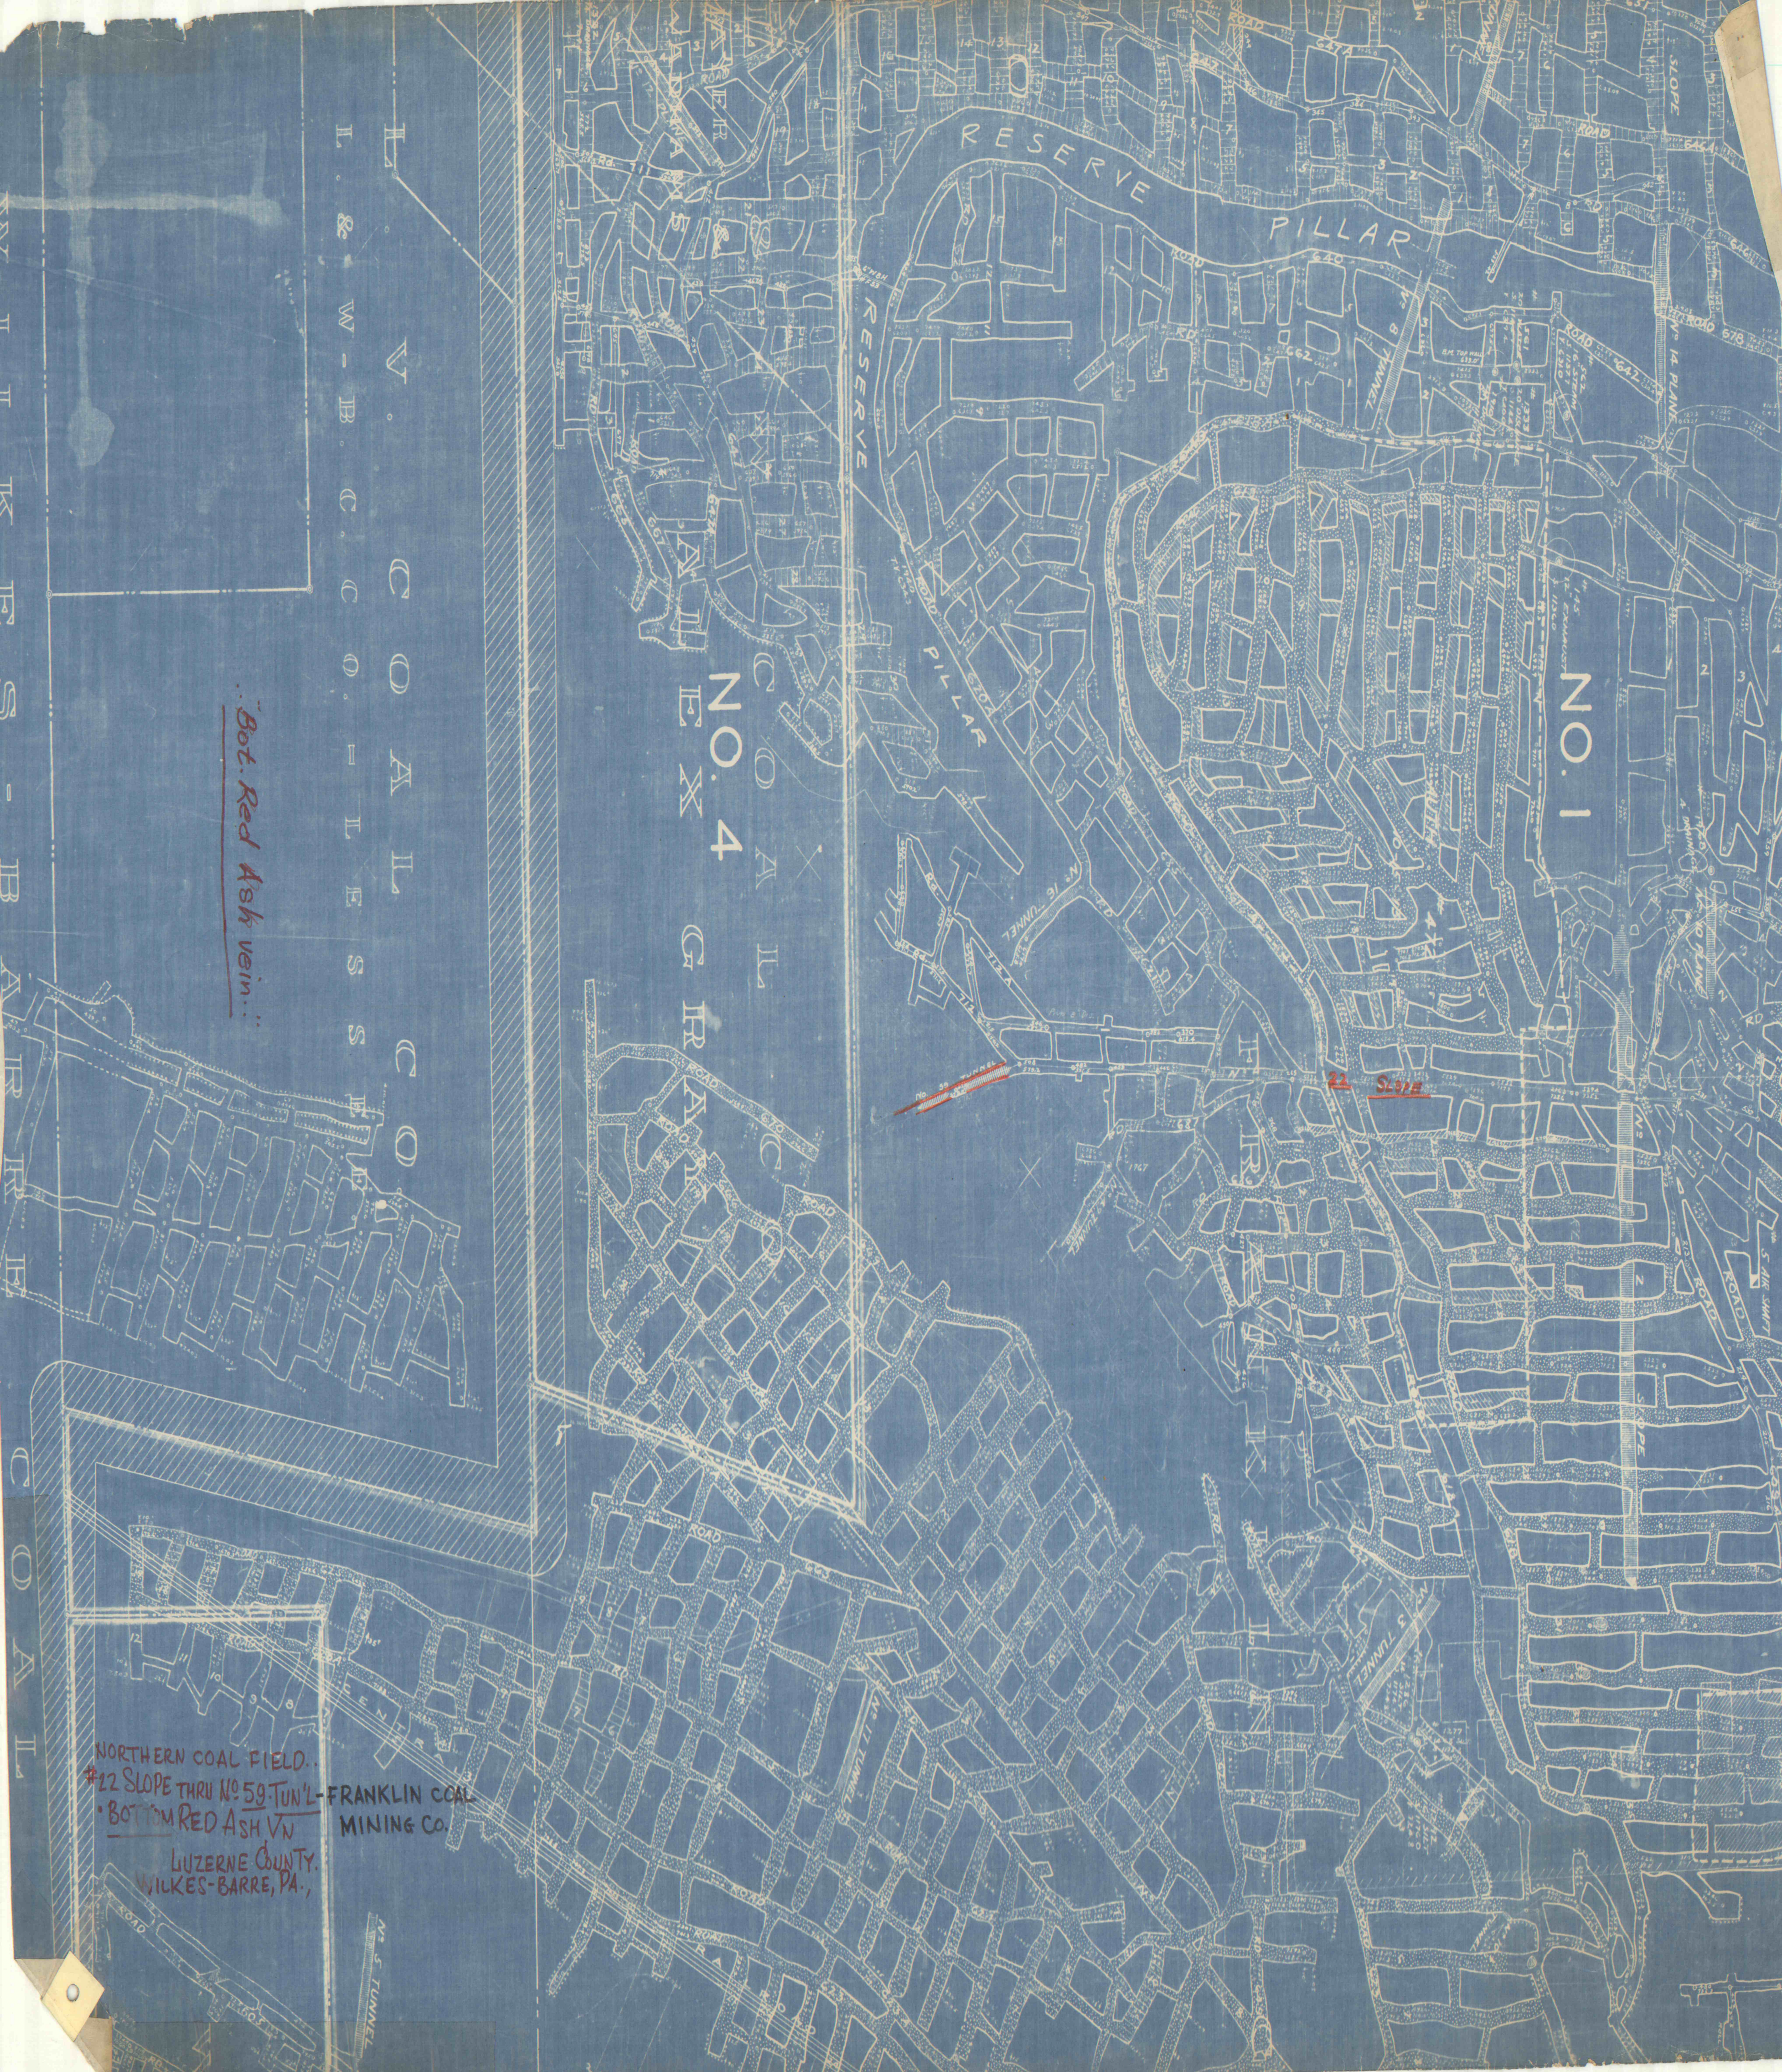

Bot. Red Ash vein.

NORTHERN COAL FIELD.
#22 SLOPE THRU NO. 59 TUN'L - FRANKLIN COAL MINING CO.
• BOTTOM RED ASH VN
LUZERNE COUNTY.
WILKES-BARRE, PA.,