


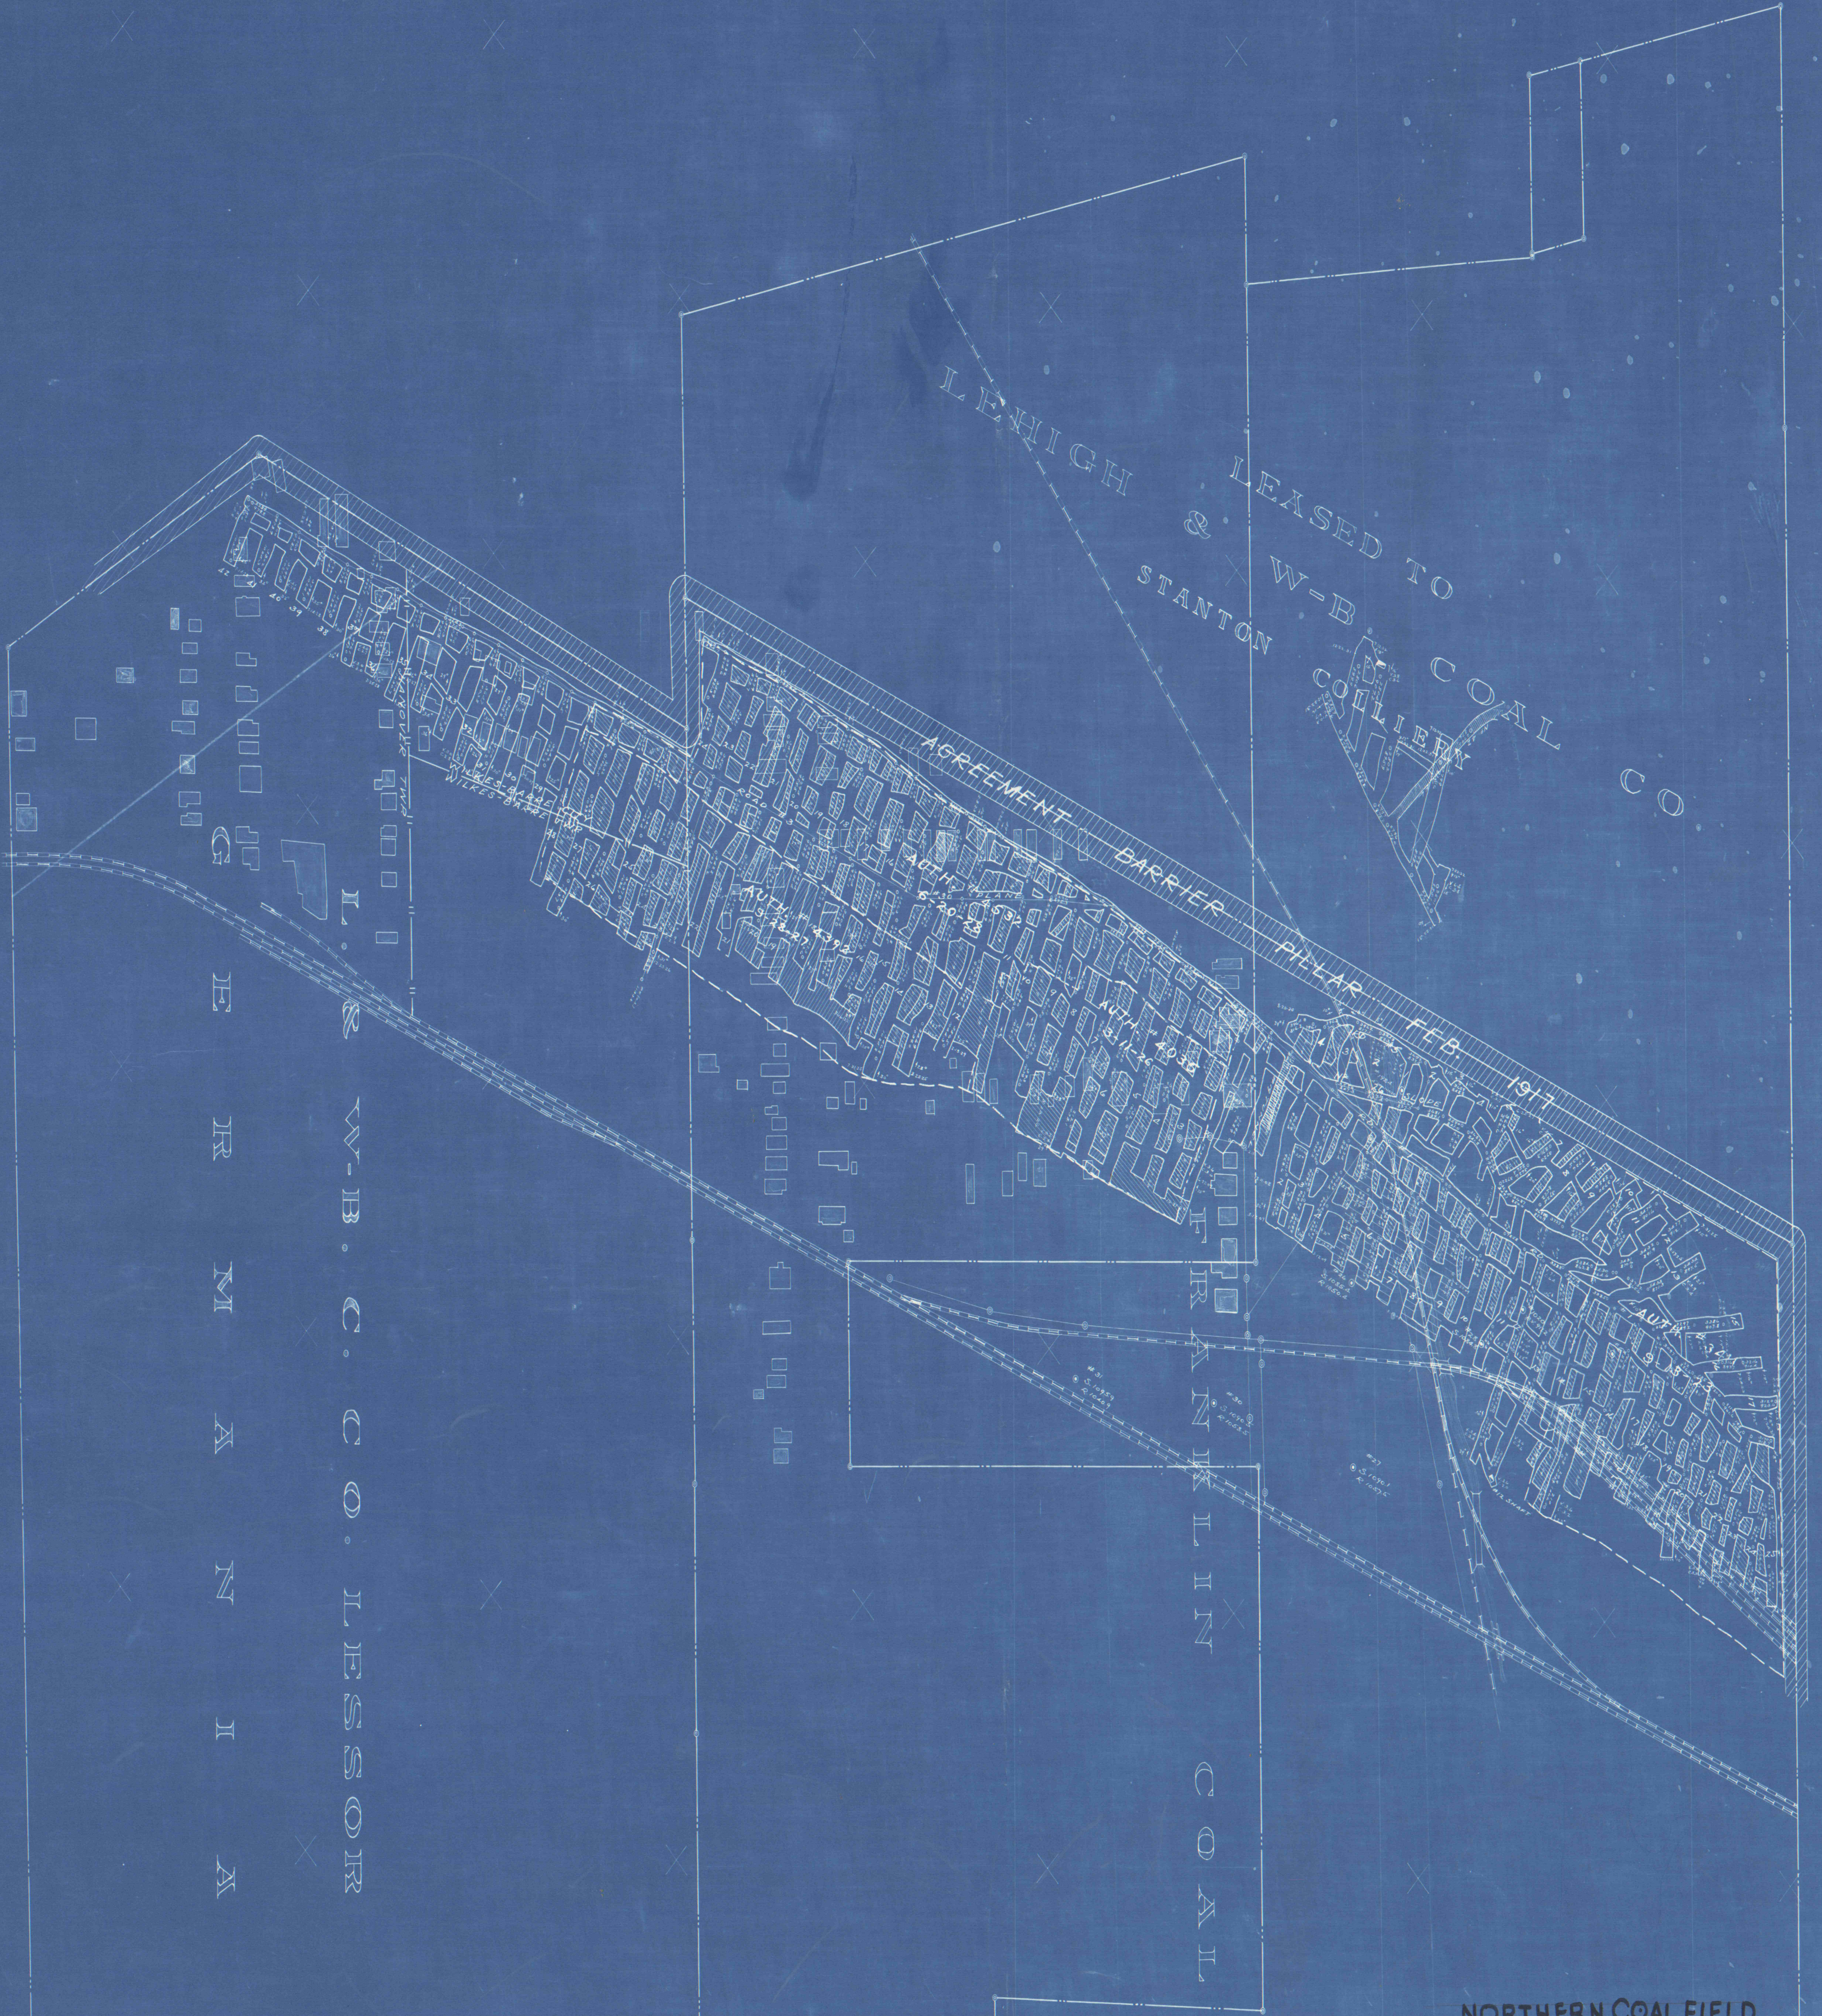

...NORTHERN COAL FIELD...
FRANKLIN COLLIERY,
= SNAKE ISLAND VEIN =
LUZERNE COUNTY..WILKES-BARRE TWP./HANOVER TWP.,
WILKES-BARRE, PA.
SCALE 100 FT. = 1 IN. DATUM 500 FT. BELOW TIDE.

MF
DEC 12 1974

DEC 12 1974

MF